


Plat of Survey

of

Lot 10 of Stewart Ridge,

a subdivision located in the Southeast 1/4 of the Southwest 1/4 of Section 35, Town 4 North, Range 15 East, Town of Whitewater, Walworth County, Wisconsin.

Surveyed for: **Thomas & Patricia Bauhs**
948 Chicago Avenue
Oak Park, Illinois. 60302

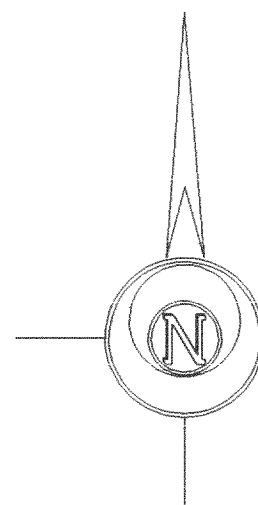

Bearings reference to the plat of Stewart Ridge.

Lot 7

Lot 8

Lot 9

Lot 11

Lot 12

(N84°41'E 235.12')
N84°43'20"E 235.12'

20' Wide Ingress & Egress Easement for Joint Driveway
Described in Vol. 630 on Page 4456, Doc. No. 286184.

(N17°42'31"E 76.49')
N17°42'31"E 76.49'

House
N7349
22.5'
16.9'

Shed
8.1'

Lot 10
0.550 Acre
23,965 Sq.Ft.

S84°28'17"E 263.96'
(S84°31'E 264.18')



Found second pipe
1.77' N40°32'18"W
of pipe at corner.

S2°33'00"E 120.05'
(120.00')

Drive
(66' Wide)

Stewart
(Private Road)

20' Wide Passageway & Access Easement
Described in Vol. 630 on Page 4456, Doc. No. 286184.

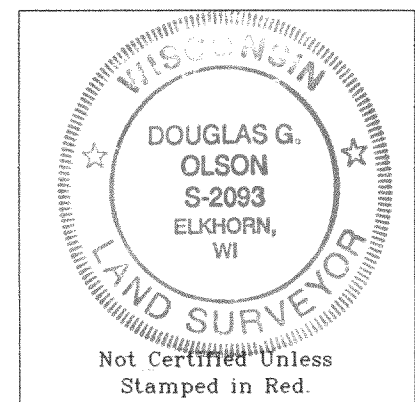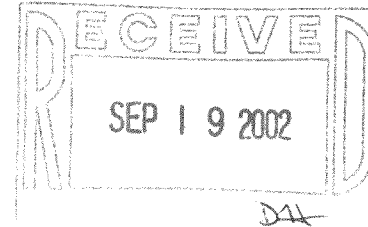

Copyright © 2002 by Jensen & Olson Land Surveying, LLC.


All rights reserved. No part of this survey plat may be reproduced or transmitted in any form by any means - graphic, electronic, or mechanical, including photocopying, tracing, or information storage and retrieval systems - without permission in writing from Douglas G. Olson, Jensen & Olson Land Surveying, LLC.

- Notes: 1) This survey plat is not certified unless signed and sealed in red ink.
2) This survey is subject to Wisconsin lien laws. This Plat of Survey is the notice of intent to file lien. Lien waiver required.

I, Douglas G. Olson, Wisconsin Registered Land Surveyor, do hereby certify that this survey was performed by me or under my direction in full compliance with the owner's/agent's instructions and Chapter A-E 7 of the Wisconsin Administrative Code "Minimum Standards for Property Surveys", and that this map is an accurate representation thereof to the best of my knowledge and belief.

Douglas G. Olson
Wisconsin Registered Land Surveyor - 2093

Survey Date: July 26, 2002.
Revisions:

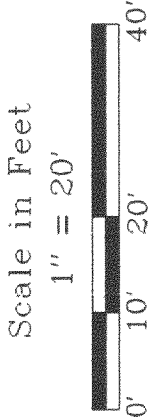

Jensen & Olson Land Surveying, LLC

45 South Wisconsin Street P.O. Box 322
Elkhorn, Wisconsin. 53121
Telephone (262) 723-3434
Facsimile (262) 723-8044

- Legend
☒ Found Iron Pipe
☒ Recorded Information
☒ Utility Pole
☒ Utility Pedestal
☒ Gravel Surface
☒ Wood Chips

Sheet 1 of 1 Sheets
Job Reference Number
2002.138

2002.138