

ABELL
SURVEYING & MAPPING

1140 SEQUOIA STREET • DELAVAN, WISCONSIN 53115
262-728-6737



SCALE 1"=20'

LEGEND

- ⊗ - IRON PIPE FOUND
- ⊙ - IRON ROD FOUND
- CS - CONCRETE STOOP
- △ - UTILITY POLE
- - OVERHEAD UTILITY LINES
- () - RECORDED AS

PLAT OF SURVEY OF

LOT 29, BLOCK 2, MORaine HEIGHTS, LOCATED IN T4N, R15E, WALWORTH COUNTY, WISCONSIN EXCEPTING THEREFROM THE FOLLOWING: COMMENCING AT THE NORTHEAST CORNER OF SAID LOT 29; THENCE S 13°54'03" W 75.75 FEET TO THE PLACE OF BEGINNING; THENCE S 35°49'57" W 10.00 FEET; THENCE N 56°11'22" W 131.68 FEET; THENCE S 60°31'04" E 132.41 FEET TO THE PLACE OF BEGINING. CONTAINING 658.0 SQ. FT. OF LAND.


I HEREBY CERTIFY THAT I HAVE SURVEYED THE ABOVE DESCRIBED PROPERTY AND THAT THE ABOVE MAP IS A TRUE REPRESENTATION THEREOF AND SHOWS THE SIZE AND LOCATION OF THE PROPERTY, ITS EXTERIOR BOUNDARIES, THE LOCATION OF ALL VISIBLE STRUCTURES AND DIMENSIONS OF ALL PRINCIPAL BUILDINGS THEREON, BOUNDARY FENCES, APPARENT EASEMENTS, ROADWAYS AND VISIBLE ENCROACHMENTS, IF ANY, TO THE BEST OF MY KNOWLEDGE AND BELIEF.

THIS SURVEY IS MADE FOR THE USE OF THE PRESENT OWNERS OF THE PROPERTY, AND ALSO THOSE WHO PURCHASE, MORTGAGE, OR GUARANTEE THE TITLE THERETO WITHIN ONE (1) YEAR FROM DATE HEREON.

DAVID F. ABELL
WISCONSIN REGISTERED LAND SURVEYOR, S-1596

June 7, 1993

DATE: June 7, 1993 JOB NUMBER - 93052D
NOTE: THIS IS NOT A CERTIFIED COPY UNLESS SEALED.

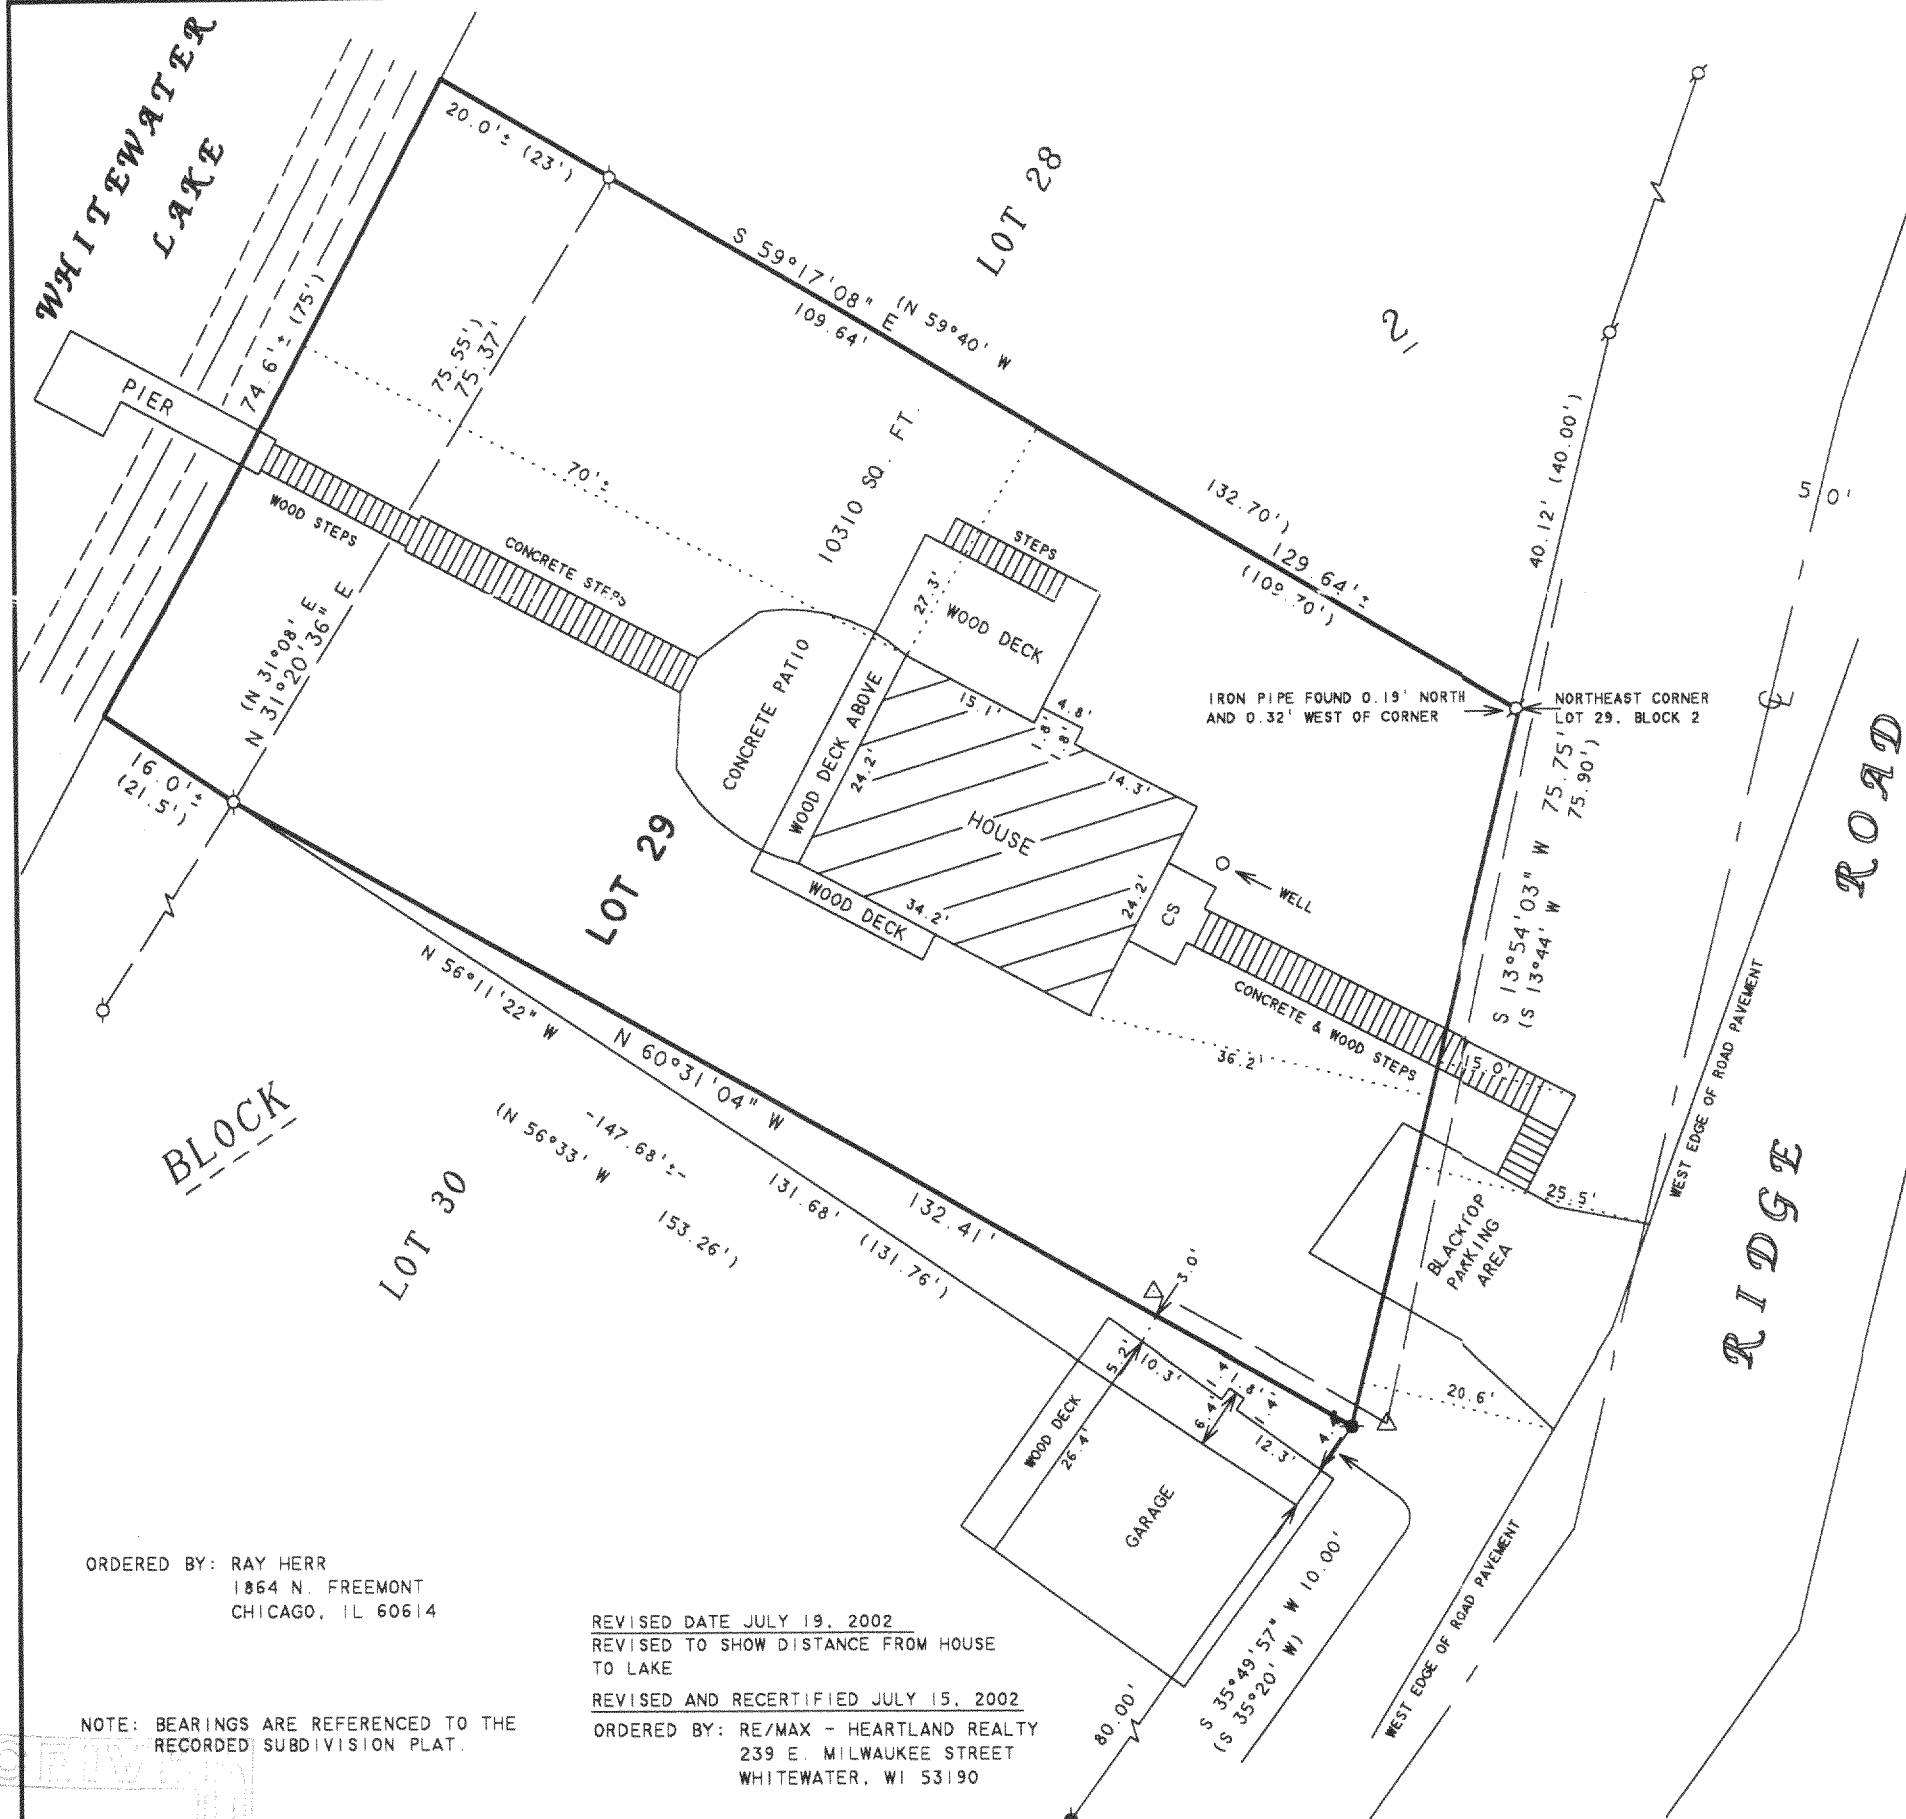


ORDERED BY: RAY HERR
1864 N. FREEMONT
CHICAGO, IL 60614

REVISED DATE JULY 19, 2002
REVISED TO SHOW DISTANCE FROM HOUSE
TO LAKE

REVISED AND RECERTIFIED JULY 15, 2002
ORDERED BY: RE/MAX - HEARTLAND REALTY
239 E. MILWAUKEE STREET
WHITEWATER, WI 53190

NOTE: BEARINGS ARE REFERENCED TO THE
RECORDED SUBDIVISION PLAT.

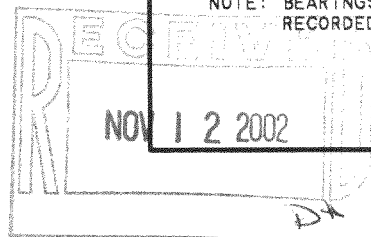

DMH-62 415-882