
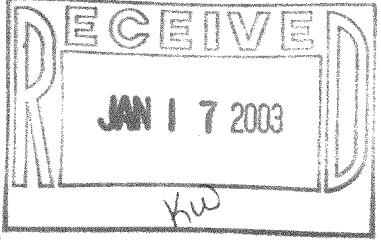


PLAT OF SURVEY

LOT 16, THORNE HEIGHTS, located in the Southeast 1/4 and in the Southwest 1/4 of Section 35, Town 4 North, Range 15 East, of the 4th P.M., Walworth County, Wisconsin.

Surveyed for: Tincher Realty

Survey address: N.7431 East Lake Shore Drive

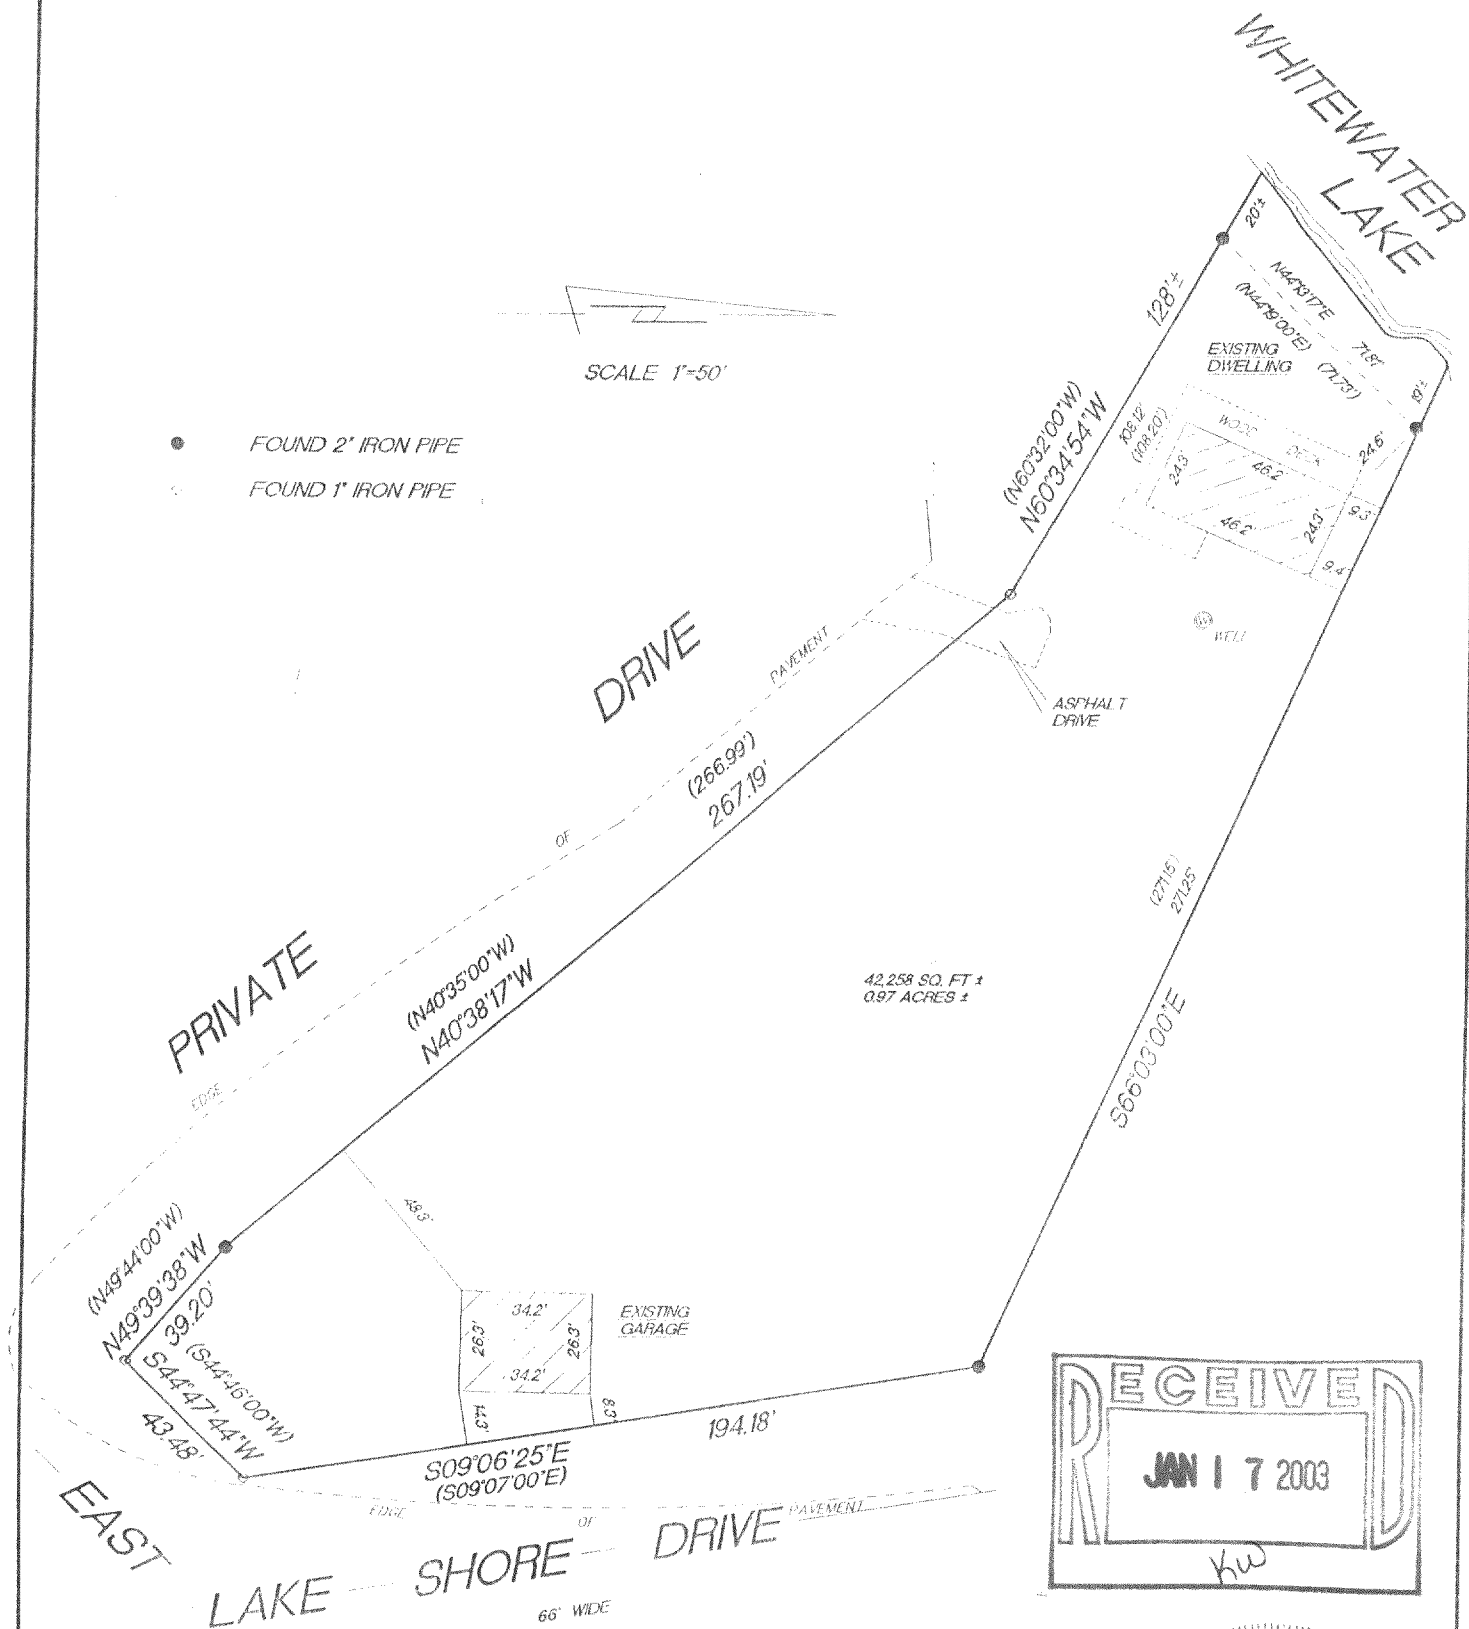

"I hereby certify that I have surveyed the above described property and that the above map is a true representation thereof and shows the size and location of the property, its exterior boundaries, the location of all visible structures and dimension of all principal buildings thereon, boundary fences, apparent easements, roadways and encroachments if any."

"This survey is made for the use of the present owners of the property, and also those who purchase, mortgage or guarantee the title thereto within one year from date hereof."

KETTLE MORaine SURVEYING, INC.
W356 S9050 Godfrey Lane
Eagle Wisconsin 53119
P.O. Box 357
(262) 594-3484
Terrance E. Pisarek R.L.S.

THIS IS NOT AN ORIGINAL SURVEY UNLESS THE SEAL IS RED.

12/30/02

TEP/DW

TEP

02228

DATE

FIELD WORK BY

DRAWN BY

JOB NUMBER

DTH-16

415-892