

# PLAT OF SURVEY

**RSV**

**ENGINEERING, INC.**

Engineers • Land Surveyors • Environmental Scientists  
801 MAIN STREET MUKWONAGO, WISCONSIN 53149 (262)363-2004


FOR: WALTON ENTERPRISES

DATE: 12-09-02

DESCRIPTION: LOT 5 OF LORWOOD ACRES, A SUBDIVISION LOCATED IN PART OF THE SE<sup>1</sup>/<sub>4</sub> OF THE SW<sup>1</sup>/<sub>4</sub> AND IN PART OF THE SW<sup>1</sup>/<sub>4</sub> AND SE<sup>1</sup>/<sub>4</sub> OF THE SE<sup>1</sup>/<sub>4</sub> OF SECTION 35, TOWN 4 NORTH, RANGE 15 EAST, AND IN THE NW<sup>1</sup>/<sub>4</sub> OF THE NE<sup>1</sup>/<sub>4</sub> OF SECTION 2, TOWN 3 NORTH, RANGE 15 EAST, ALL IN WALWORTH COUNTY, WISCONSIN.

## LEGEND

- .5" IRON ROD FOUND
- 1" IRON ROD FOUND
- ( ) RECORDED AS

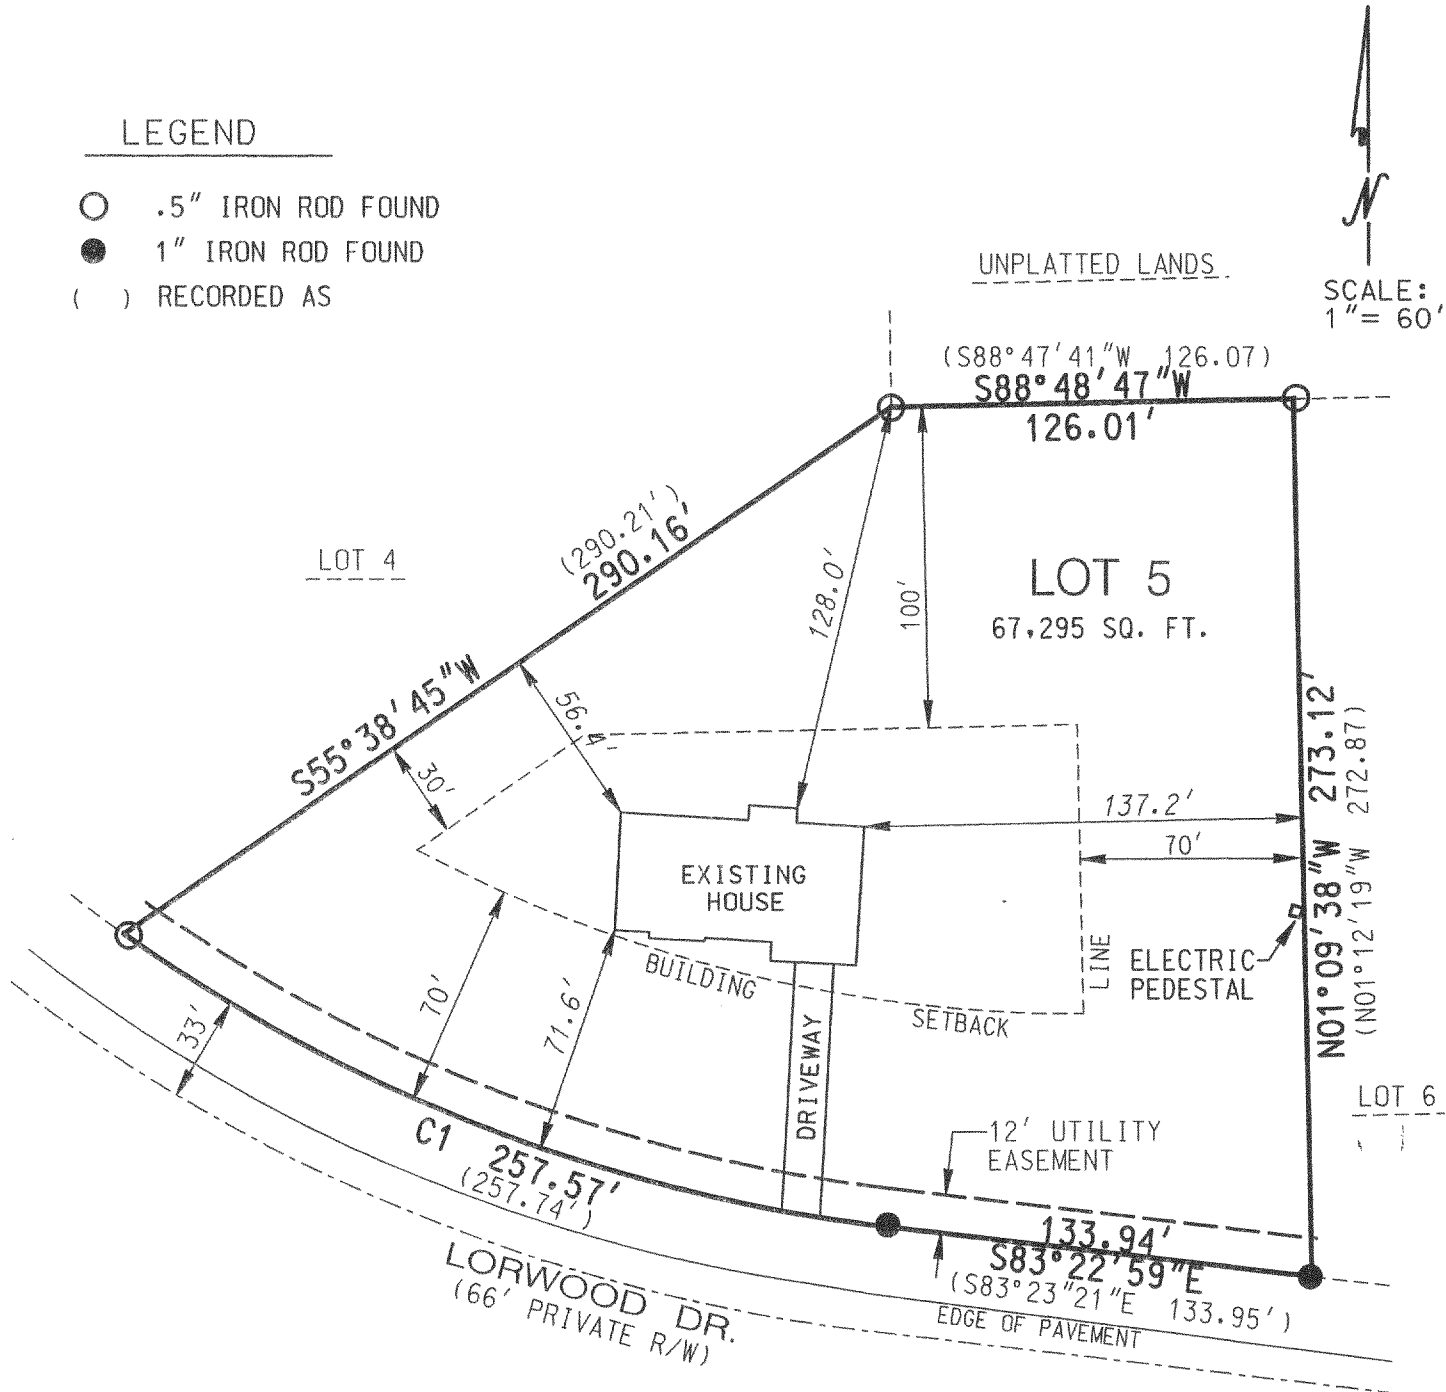

### C1 CURVE DATA RECORDED:

DELTA ———— 28°33'51"  
RADIUS ———— 517.00  
ARC ———— 257.74  
CHD. BRG. ——— S69°06'25.5"E  
CHD. LENGTH ——— 255.08

### C1 CURVE DATA MEASURED:



DELTA ———— 28°32'43"  
RADIUS ———— 517.00  
ARC ———— 257.57  
CHD. BRG. ——— S69°01'03"E  
CHD. LENGTH ——— 254.92

THE ABOVE MAP IS A TRUE REPRESENTATION THEREOF AND SHOWS THE SIZE AND LOCATION OF ALL THE PROPERTY, EXTERIOR BOUNDARIES, THE LOCATION OF ALL VISIBLE BOUNDARY FENCES, APPARENT EASEMENTS, ROADWAYS AND VISIBLE ENCROACHMENTS, IF ANY.

THIS SURVEY IS MADE FOR THE USE OF THE PRESENT OWNERS OF THE PROPERTY, AND ALSO THOSE WHO PURCHASE, MORTGAGE OR GUARANTEE TITLE THERETO WITHIN ONE (1) YEAR FROM DATE HERETO.

BRADFORD L. SPENCER, R.L.S. 2069  
RSV#02408

THIS IS ORIGINAL  
PRINT ONLY IF  
SEAL IS IMPRINTED  
IN RED

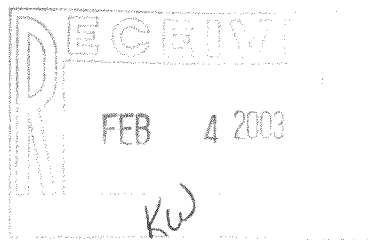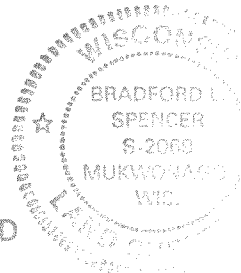

CLOR-5 + DLOR-5

415-894