


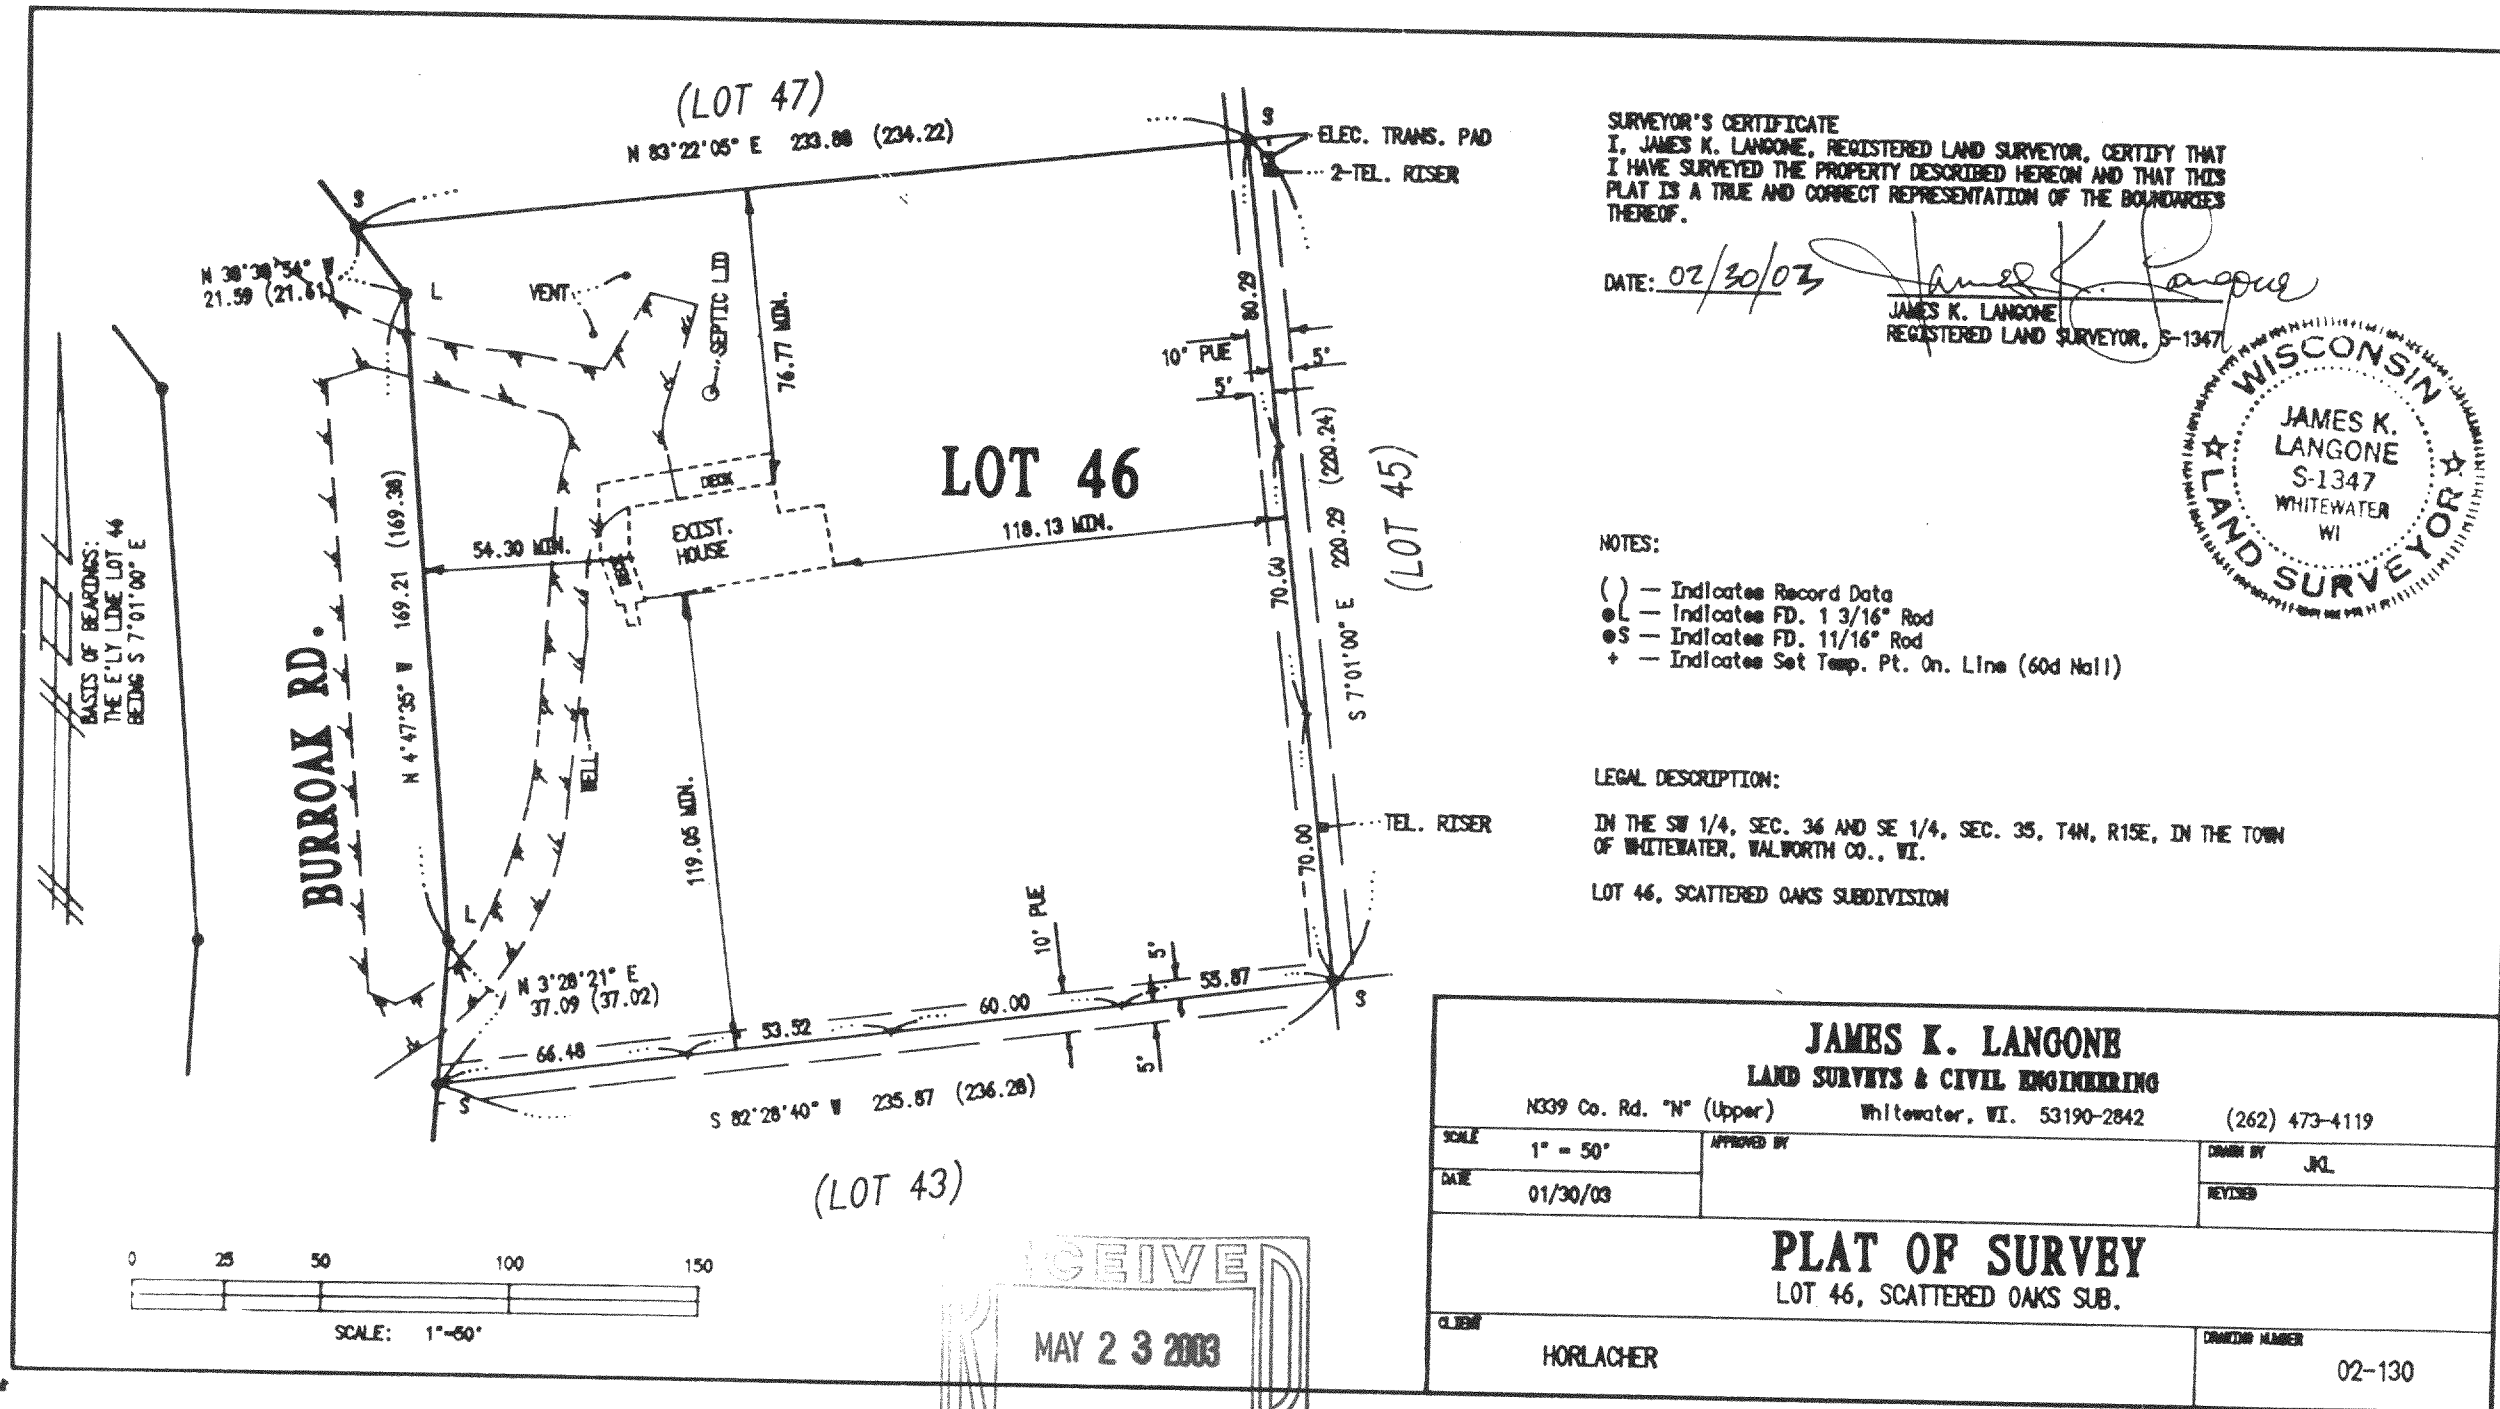

DSO-48

415-905