



PLAT OF SURVEY

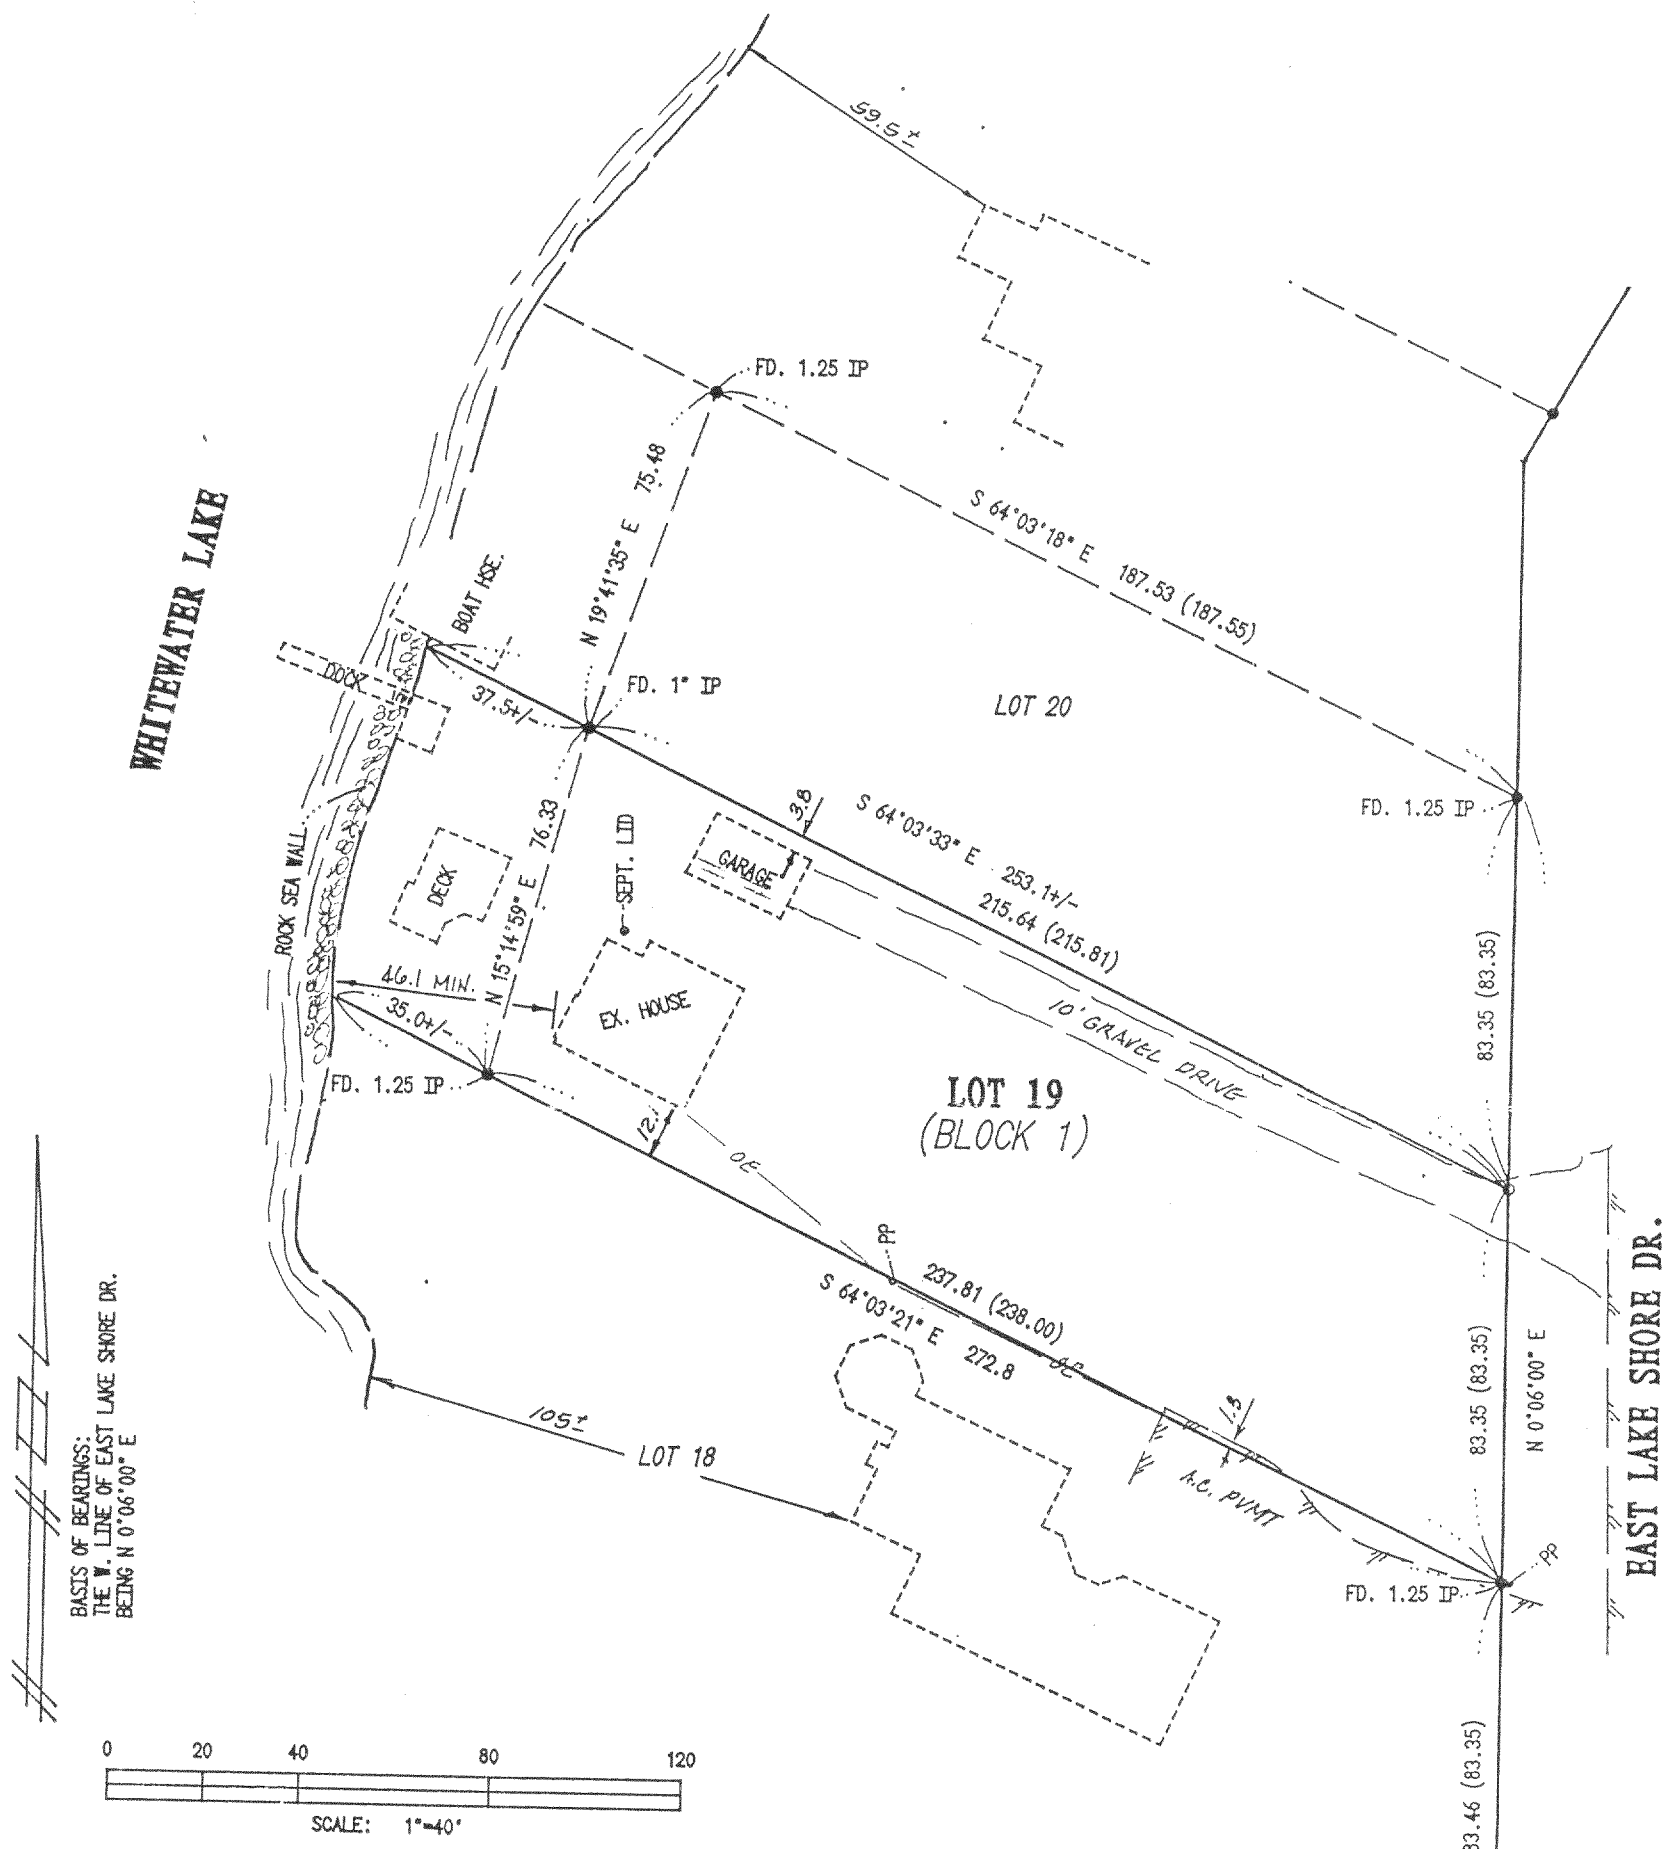

SURVEYOR'S CERTIFICATE
I, JAMES K. LANGONE, REGISTERED LAND SURVEYOR, CERTIFY THAT I HAVE SURVEYED THE PROPERTY DESCRIBED HEREON AND THAT THIS PLAT IS A TRUE AND CORRECT REPRESENTATION OF THE BOUNDARIES THEREOF.

DATE: 9/22/02

JAMES K. LANGONE
REGISTERED LAND SURVEYOR, S-1347

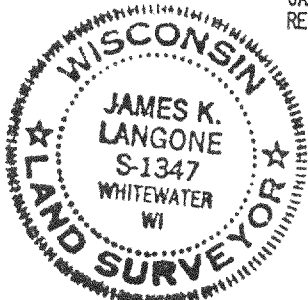

NOTES:

- () — Indicates Record Data
- — Indicates Mnt. FD. as Noted
- — Indicates SET 3/4" Iron Rod

DESCRIPTION:

LOT 19, BLK. 1, WINNIESKA SUB.

JAMES K. LANGONE
LAND SURVEYS & CIVIL ENGINEERING

N339 Co. Rd. "N" (Upper)

Whitewater, WI. 53190-2842

(262) 473-4119

JN: 02-124
9/21/02

MAY 23 2003

DM-19

415-907