
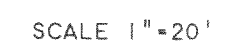


1140 SEQUOIA STREET • DELAVAN, WISCONSIN 53115
262-728-6737

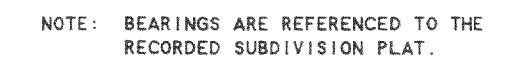

LEGEND

- - IRON PIPE FOUND
 △ - UTILITY POLE
 ——— - OVERHEAD UTILITY LINES
 → - GUY WIRE
 ▲ - SOIL BORING
 () - RECORDED AS

HOUSE FOUNDATION
LOCATED 9/17/03

DETAIL

27.0'

30.0'

14.04'

14.11'

13.0'

10.16'

24.9'

16.0'

4.0'

8.29'

4.0'

2.0'

18.32'

29.9'

29.0'

ORDERED BY: JEAN-PIERRE DEHEEGER
2413 THORNWOOD AVENUE
WILMETTE, IL 60091

REVISED DATE: JULY 15, 2003
REVISED TO SHOW PROPOSED HOUSE
AND GARAGE LOCATION.

REVISED DATE: AUGUST 4, 2003
REVISED TO SHOW NEW PROPOSED
GARAGE LOCATION.

REVISED DATE: AUGUST 25, 2003
REVISED TO SHOW NEW PROPOSED
GARAGE LOCATION.

REVISED DATE: SEPTEMBER 18, 2003
REVISED TO SHOW HOUSE AND GARAGE
FOUNDATIONS.

ORDERED BY: HOME DESIGN MFG.
P.O. BOX 527
FONTANA, WI 53125

I, DAVID F. ABELL, DO HEREBY CERTIFY THAT I HAVE SURVEYED THE PROPERTY HEREON DESCRIBED ACCORDING TO THE OFFICAL RECORDS AND THAT THE PLAT HEREON IS A CORRECT REPRESENTATION OF THE PROPERTY LINES TO THE BEST OF MY KNOWLEDGE AND BELIEF.

David F. Phill

DAVID F. ABELL
WISCONSIN REGISTERED LAND SURVEYOR, S-1596

June 20, 2003

DATE _____ JOB NUMBER - 02119F
NOTE: THIS IS NOT A CERTIFIED COPY UNLESS SEALED.