
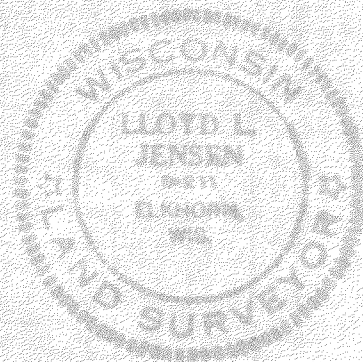


PLAT OF SURVEY OF

LOT 4 BLOCK 3 OF GUTZMER'S SUBDIVISION
LOCATED IN THE SOUTH WEST $\frac{1}{4}$ OF SECTION
25, T4N R15E, WALWORTH COUNTY,
WISCONSIN.

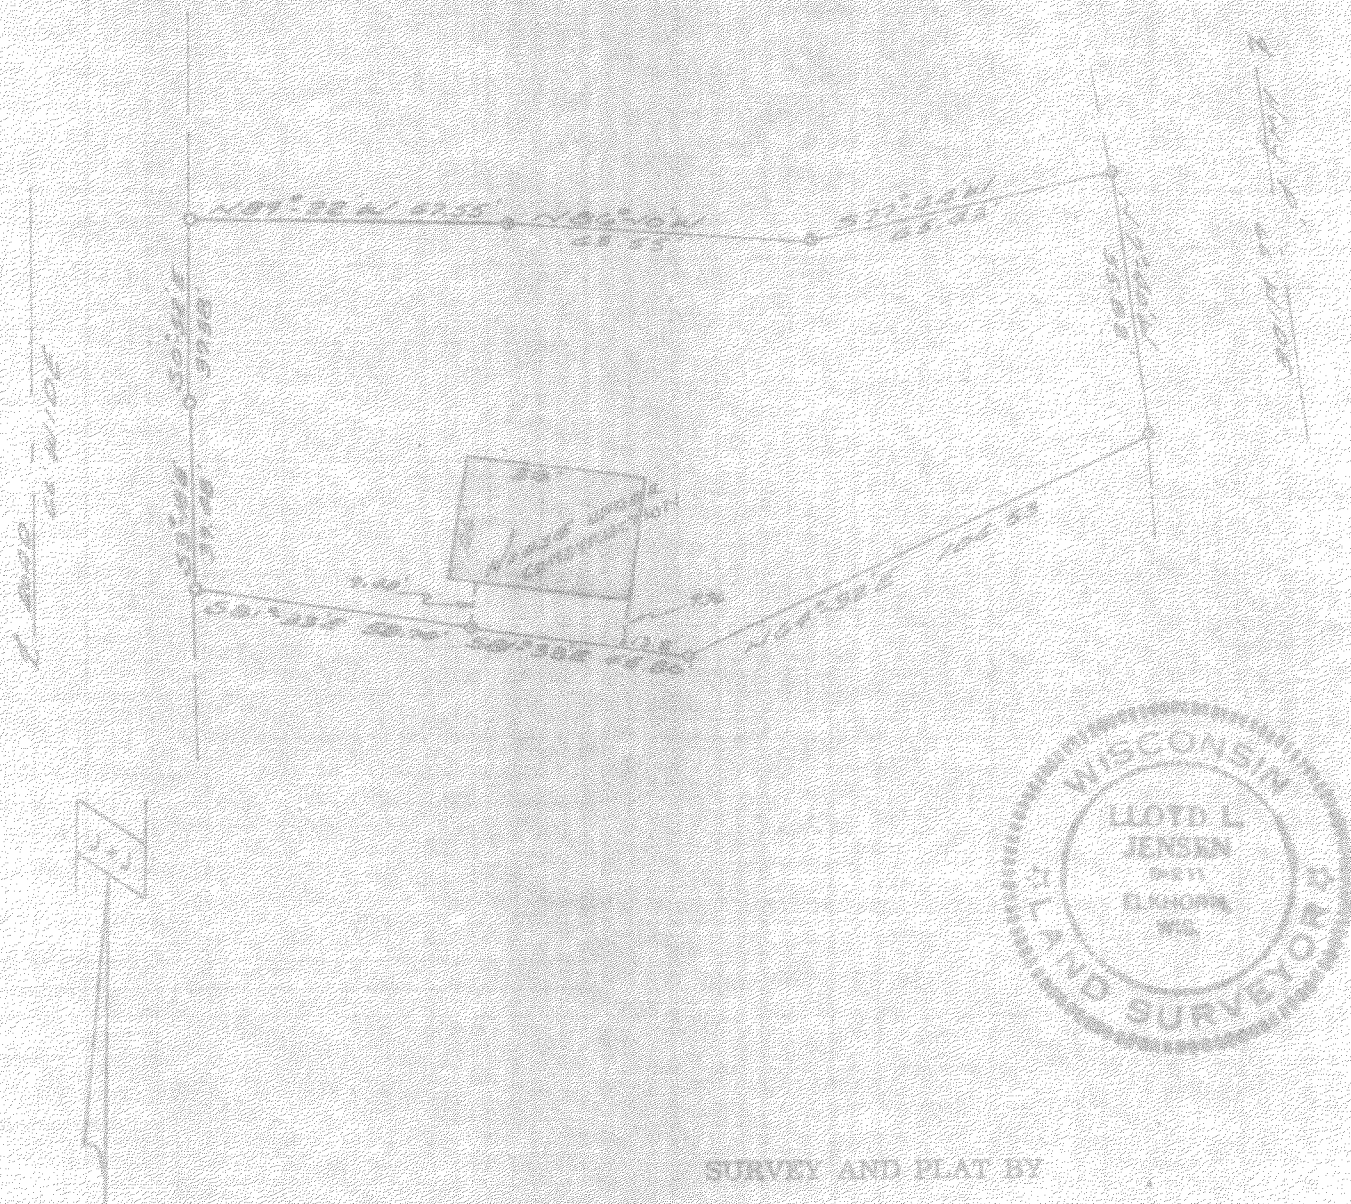

SURVEY AND PLAT BY
JENSEN & JOHNSON, INC.
CIVIL ENGINEERS AND SURVEYORS

Elkhorn, Wisconsin

LEGEND

- -- Iron Pipe
- -- Concrete Monument
- Scale 1" = 40'

WE CERTIFY: That we have surveyed the above described property and that the plat shown hereon is an accurate survey and a true representation thereof and correctly show the exterior boundary lines and all divisions of said property, and all buildings thereon.

Date Aug 4, 1970

Lloyd L. Jensen
LLOYD L. JENSEN,

Wisconsin Registered Land Surveyor, No. S-211


D65-23

415-93 JV

PLAT OF SURVEY

OF

LOT 4 BLOCK 3 OF GUTZMER'S SUBDIVISION
LOCATED IN THE SOUTHWEST $\frac{1}{4}$ OF SECTION
25, T4N R15E, WALKWORTH COUNTY,
WISCONSIN.

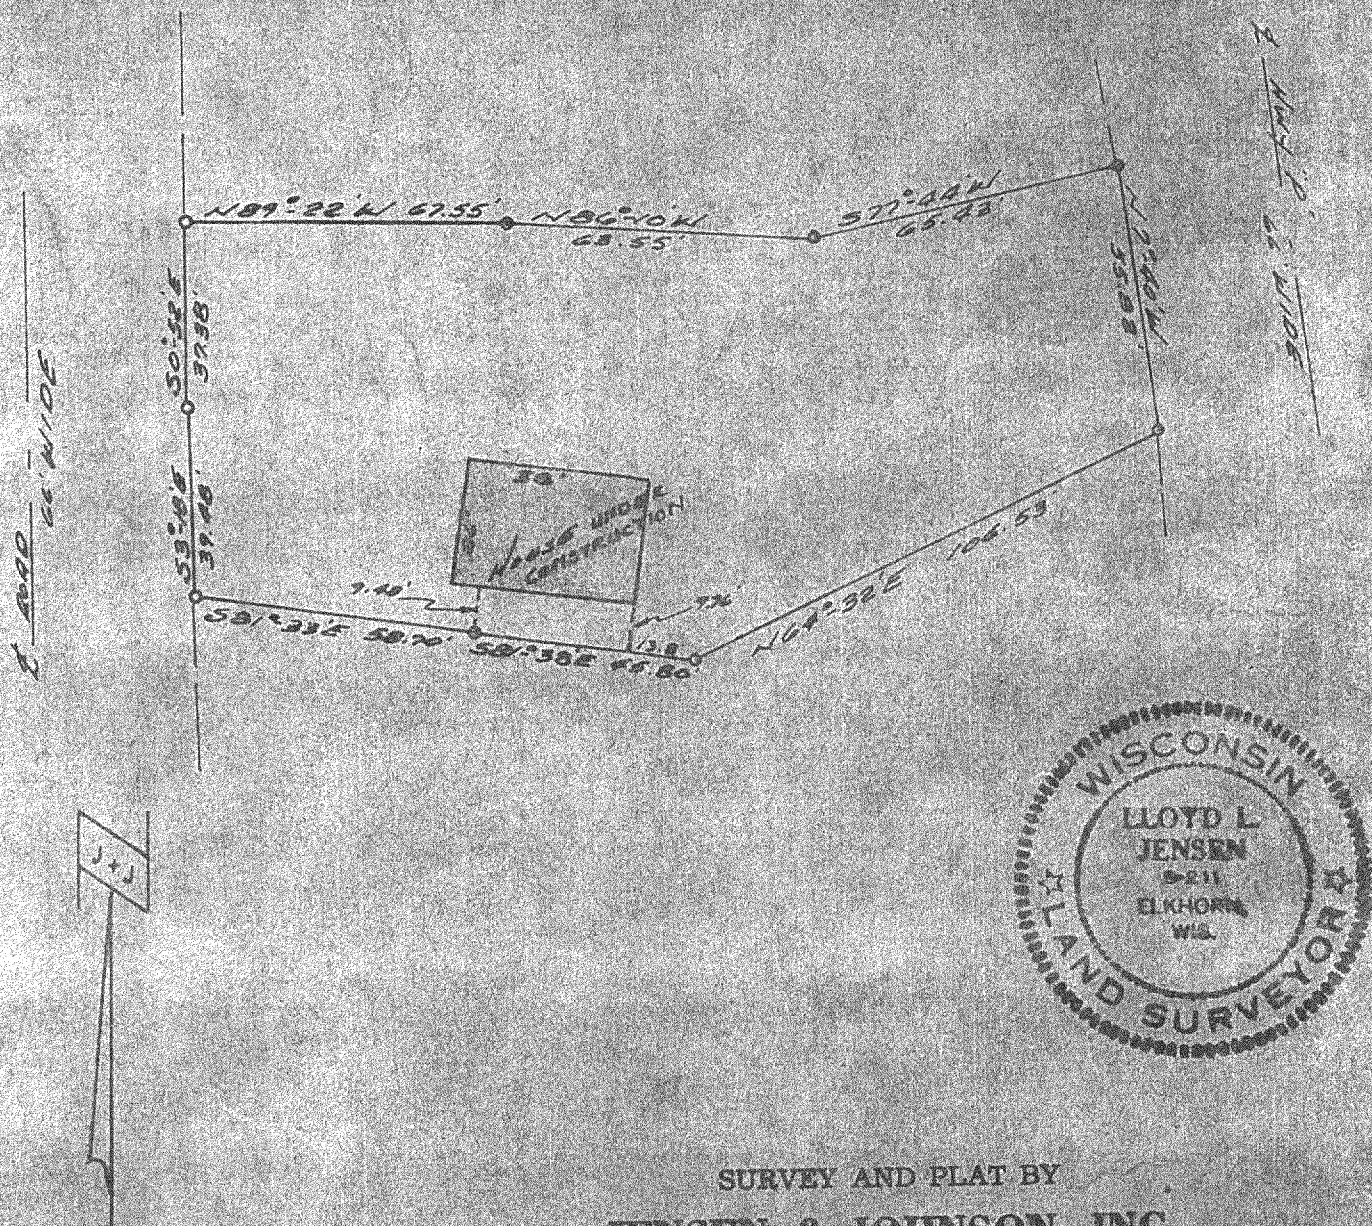

LEGEND

- — Iron Pipe FOUND
 - — Concrete Monument
- Scale 1" = 40'

WE CERTIFY: That we have surveyed the above described property and that the plat shown hereon is an accurate survey and a true representation thereof and correctly shows the exterior boundary lines and all divisions of said property, AND ALL BUILDINGS HEREON.

Date Aug 4, 1970

Lloyd L. Jensen
LLOYD L. JENSEN,

Wisconsin Registered Land Surveyor, No. S-211

D65-23

415-93 J⁶