


1140 SEQUOIA STREET • DELAVAN, WISCONSIN 53115
262-728-6737

LOT 7 IN BLOCK 3 IN MORaine HEIGHTS SUBDIVISION, TOWN OF WHITEWATER, WALWORTH COUNTY, WISCONSIN, ACCORDING TO THE RECORDED PLAT THEREOF, AS RECORDED IN VOLUME 12 OF PLATS ON PAGES 19, 20 AND 21, WALWORTH COUNTY, WISCONSIN RECORDS.

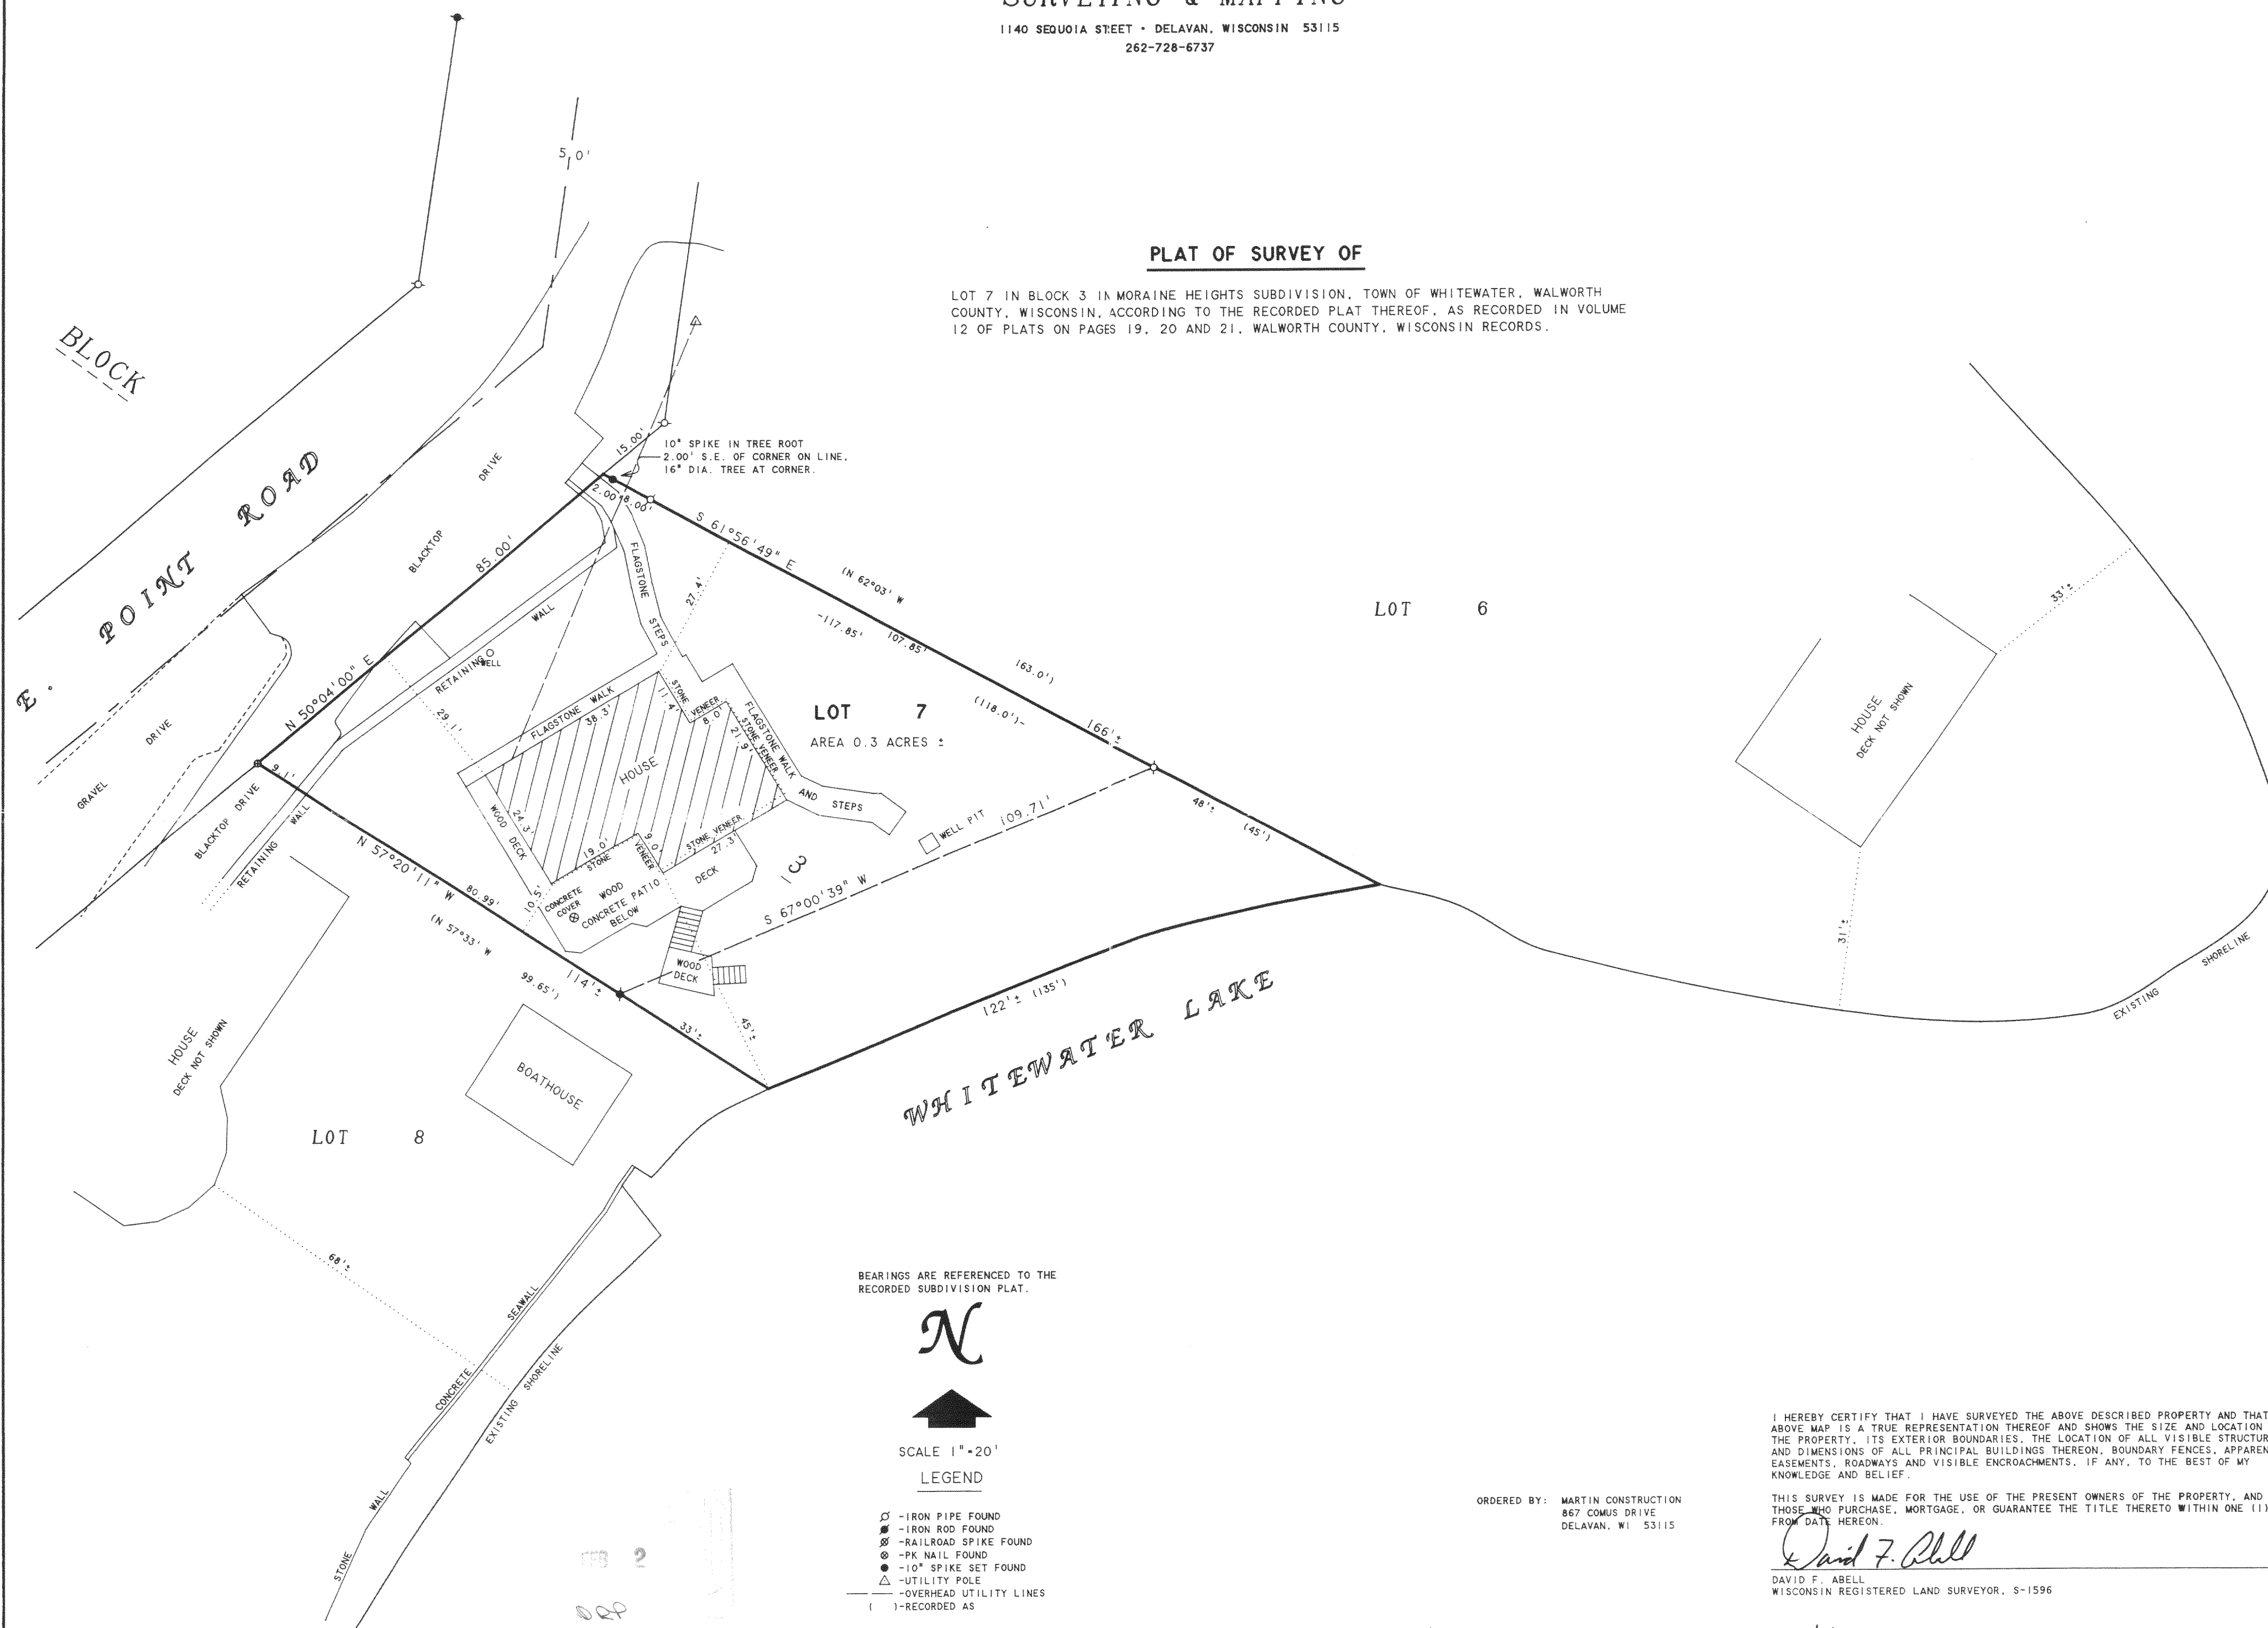

BEARINGS ARE REFERENCED TO THE
RECORDED SUBDIVISION PLAT.



SCALE 1" = 20'

LEGEND

- - IRON PIPE FOUND
 ● - IRON ROD FOUND
 ⊗ - RAILROAD SPIKE FOUND
 ⊙ - PK NAIL FOUND
 ● - 10" SPIKE SET FOUND
 △ - UTILITY POLE
 ——— - OVERHEAD UTILITY LINES
 () - RECORDED AS

ORDERED BY: MARTIN CONSTRUCTION
867 COMUS DRIVE
DELAVER, WI 53115

I HEREBY CERTIFY THAT I HAVE SURVEYED THE ABOVE DESCRIBED PROPERTY AND THAT THE ABOVE MAP IS A TRUE REPRESENTATION THEREOF AND SHOWS THE SPOT LOCATION OF THE PROPERTY AND ITS EXTERIOR BOUNDARIES. THE LOCATION OF ALL VISIBLE STRUCTURES AND DIMENSIONS OF ALL PRINCIPAL BUILDINGS THEREON, BOUNDARY FENCES, APPARENT EASEMENTS, ROADWAYS AND VISIBLE ENCROACHMENTS, IF ANY, TO THE BEST OF MY KNOWLEDGE AND BELIEF.

THIS SURVEY IS MADE FOR THE USE OF THE PRESENT OWNERS OF THE PROPERTY, AND ALSO THOSE WHO PURCHASE, MORTGAGE, OR GUARANTEE THE TITLE THERETO WITHIN ONE (1) YEAR FROM DATE HEREON.

David F. Phil

DAVID F. ABELL
WISCONSIN REGISTERED LAND SURVEYOR, S-1596

October 1, 2003

DATE: October 1, 2003 JOB NUMBER - 01139A
NOTE: THIS IS NOT A CERTIFIED COPY UNLESS SEALED.

DMH-77

415-943