


ABELL
SURVEYING & MAPPING

ELAVAN, WISCONSIN 53115

262-728-6737

NOTE: BEARINGS ARE REFERENCED TO THE
RECORDED SUBDIVISION PLAT.

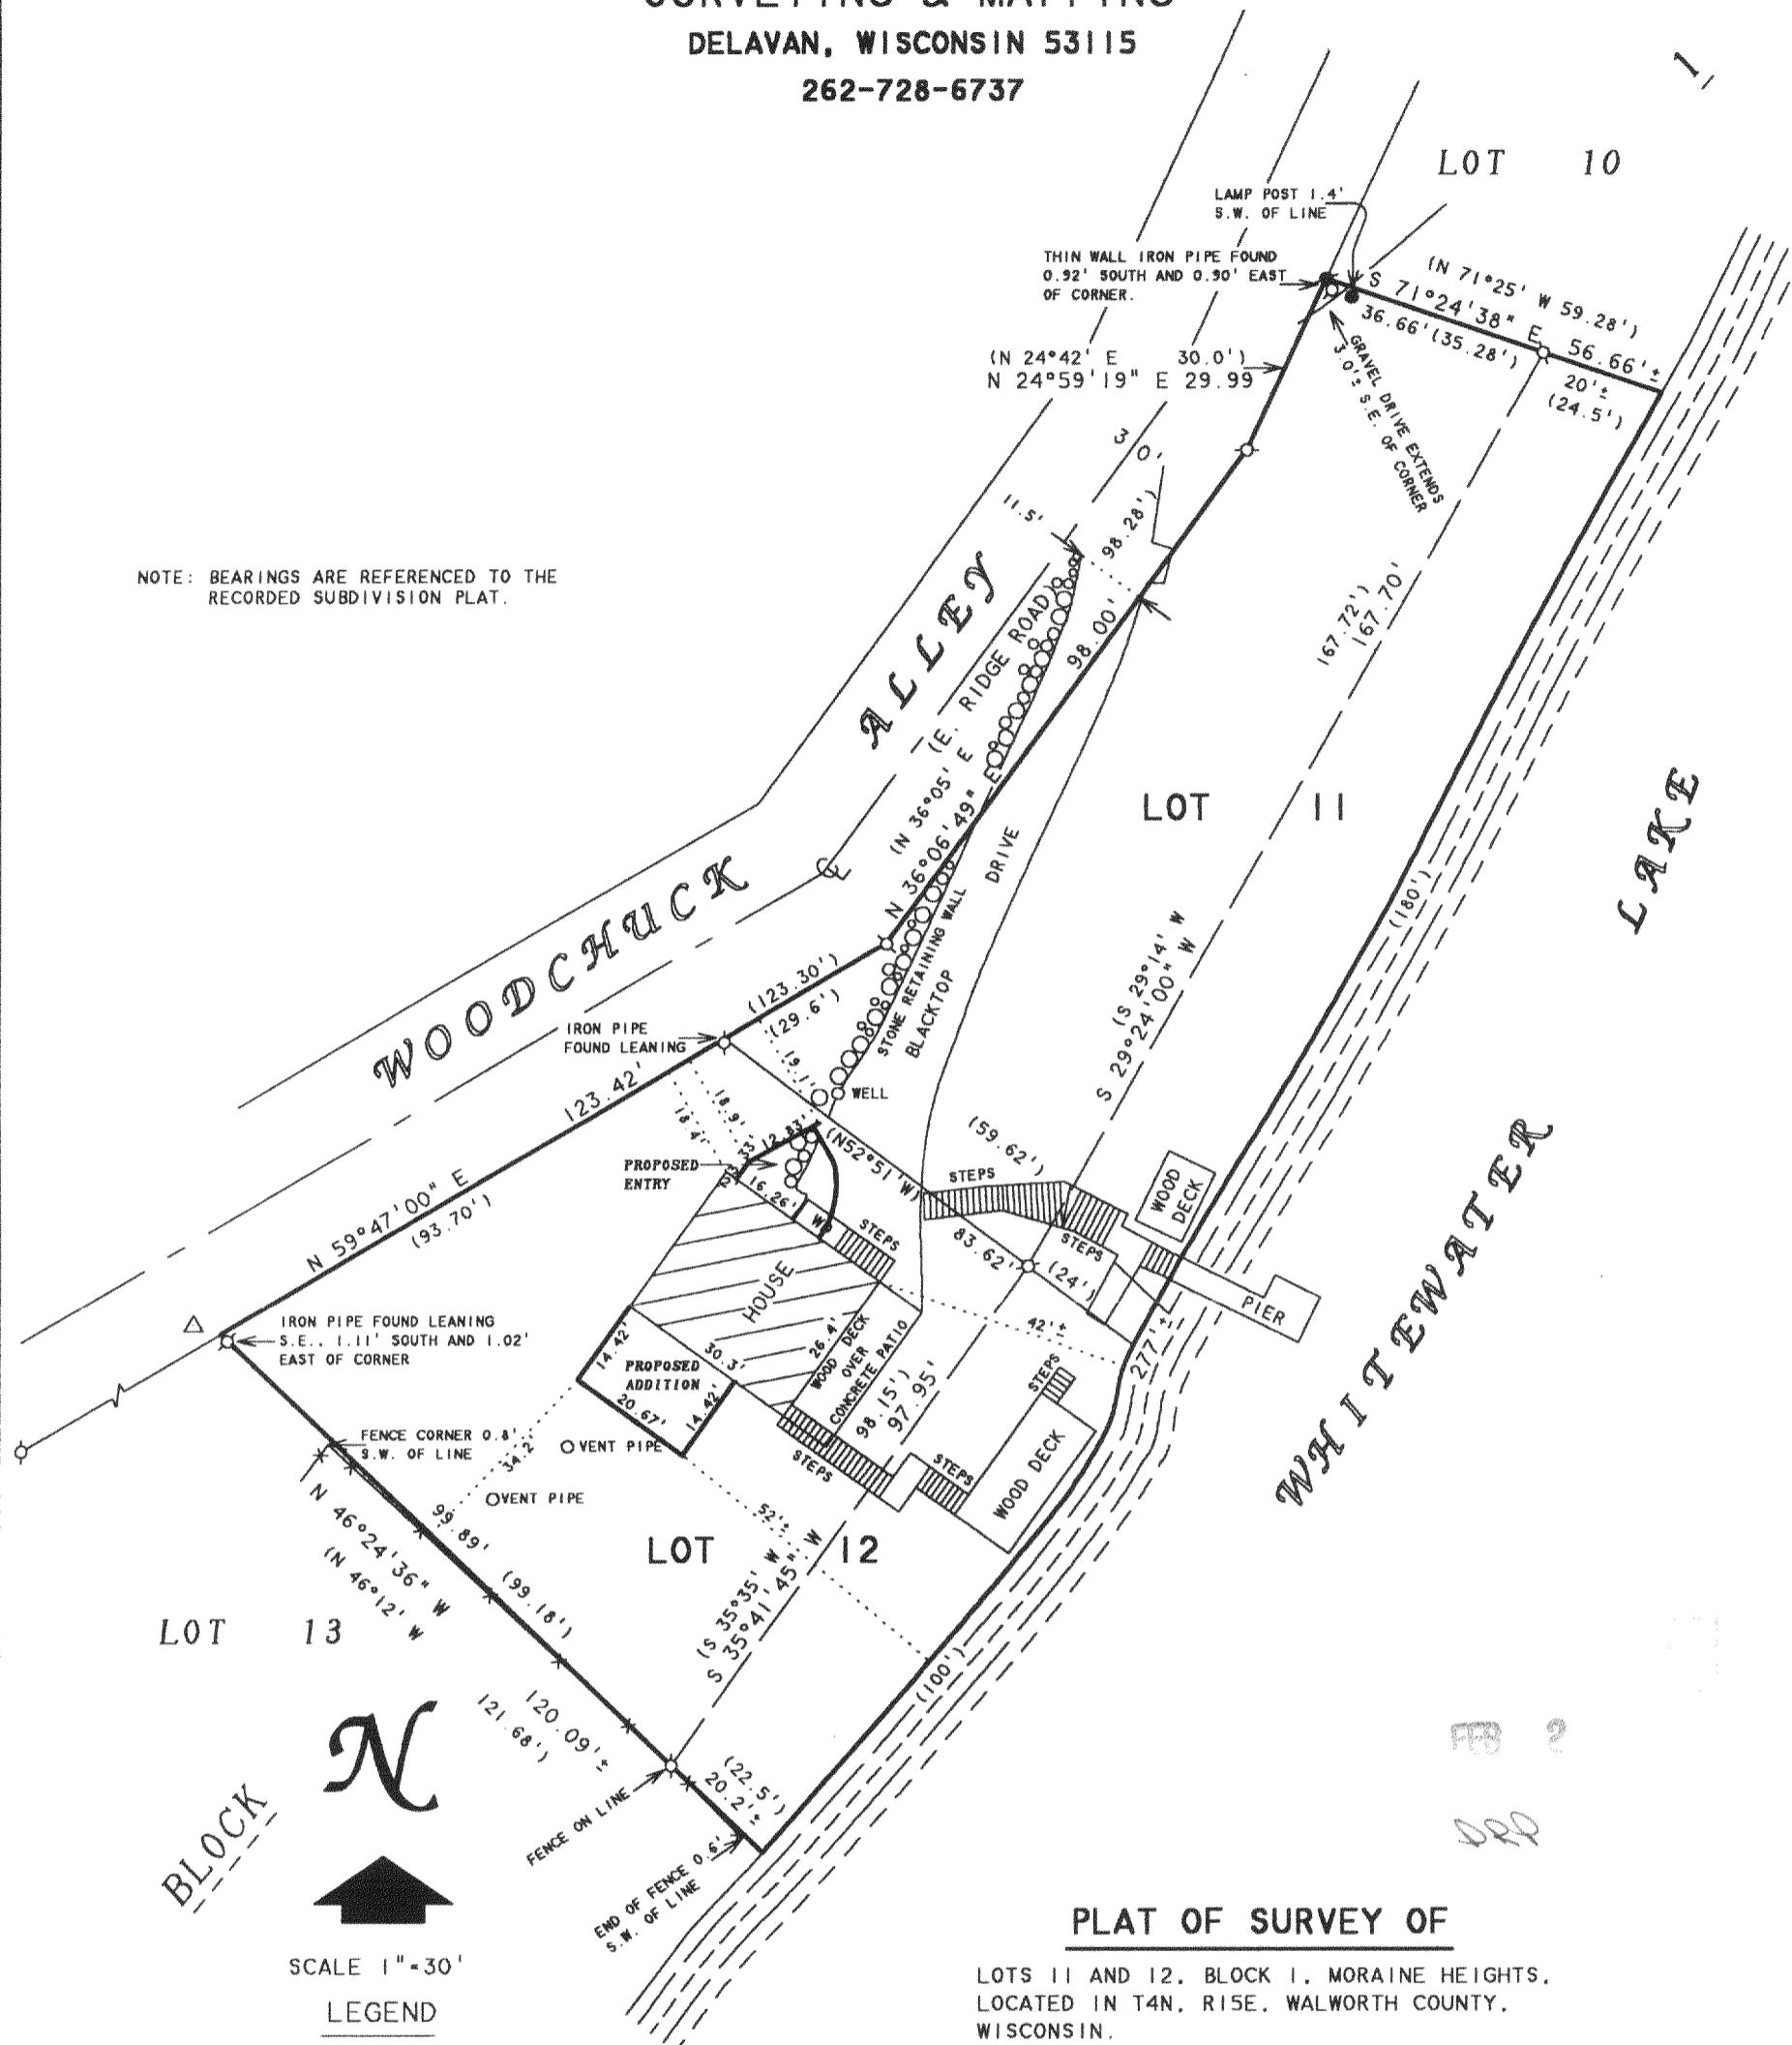

PLAT OF SURVEY OF

LOTS 11 AND 12. BLOCK 1. MORaine HEIGHTS.
LOCATED IN T4N. R15E. WALWORTH COUNTY.
WISCONSIN.

ORDERED BY: DWIGHT SWARTWOOD
11 STONEWOOD DRIVE

ORDERED BY: DWIGHT SWARTWOOD
11 STONEWOOD DRIVE

REVISED: MARCH 19, 1996 TO SHOW
WOOD STEPS AND STONE

RETAINING WALL.

ORDERED BY: RE/MAX - HEARTLAND REALTY
238 E. MILWAUKEE STREET

239 E. MILWAUKEE STREET
WHITEWATER, WI 53190

REVISED: NOVEMBER 10, 2003 TO SHOW

PROPOSED ADDITIONS.
ORDERED BY: DESCHNER BUILDING CO.
N2305 COUNTY ROAD "O"

WISCONSIN COUNTY, WISCONSIN
DELAVAN, WI 53115

I HEREBY CERTIFY THAT I HAVE SURVEYED THE ABOVE DESCRIBED PROPERTY AND THAT THE ABOVE MAP IS A TRUE REPRESENTATION THEREOF AND SHOWS THE SIZE AND LOCATION OF THE PROPERTY, ITS EXTERIOR BOUNDARIES, THE LOCATION OF ALL VISIBLE STRUCTURES AND DIMENSIONS OF ALL PRINCIPAL BUILDINGS THEREON, BOUNDARY FENCES, APPARENT EASEMENTS, ROADWAYS AND VISIBLE ENCROACHMENTS, IF ANY, TO THE BEST OF MY KNOWLEDGE AND BELIEF.

THIS SURVEY IS MADE FOR THE USE OF THE PRESENT OWNERS OF THE PROPERTY, AND ALSO
THOSE WHO PURCHASE, MORTGAGE, OR GUARANTEE THE TITLE THERETO WITHIN ONE (1) YEAR
FROM DATE HEREON.

David F. Abell
DAVID F. ABELL

DAVID F. ABELL
WISCONSIN REGISTERED LAND SURVEYOR. S-1596

December 7, 1995

DATE 10-10-86 JOB NUMBER - 95191C
NOTE: THIS IS NOT A CERTIFIED COPY UNLESS SEALED.

DMH-11

415-945