

O - INDICATES IRON PIPE

DESCRIPTION:

Lot 144, 2nd Addition to Bubbling Springs Subdivision, Section 34, T4n, R16E, Walworth County, Wisconsin.

CERTIFICATE:


I, James F. Biagi, Surveyor, do hereby certify that I have surveyed the lands hereon described.

September 15, 1971



James F. Biagi

RLS 272

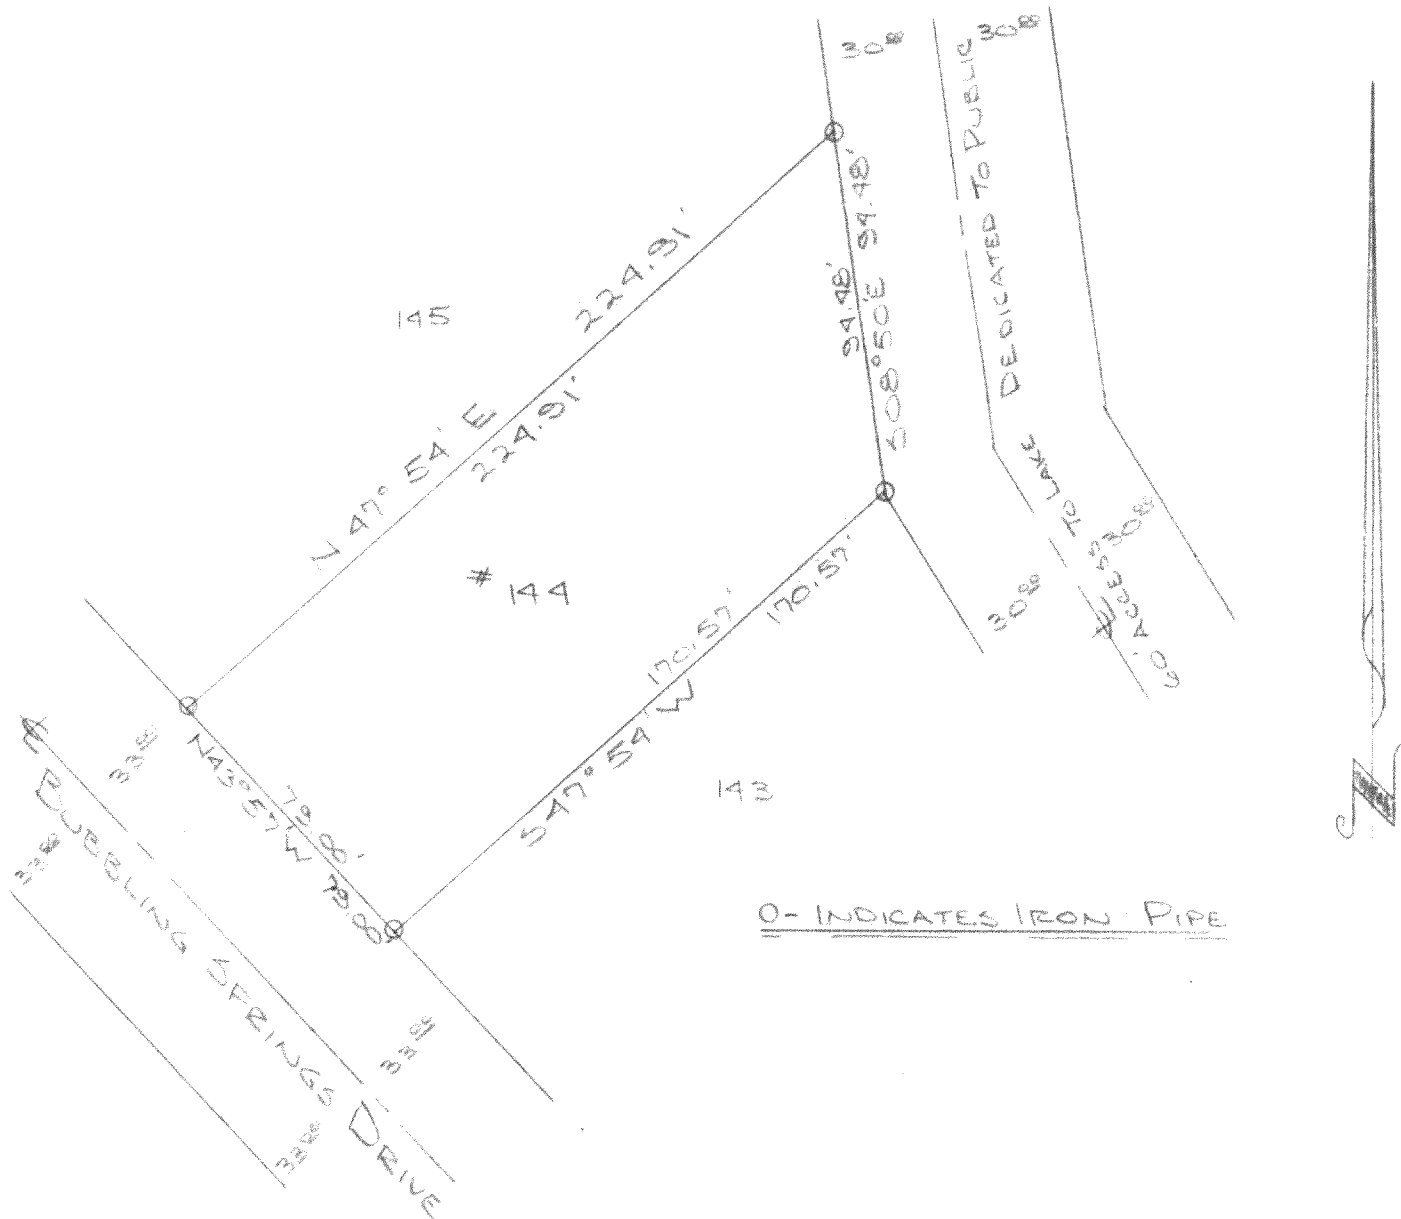


DESCRIPTION:

Lot 144, 2nd Addition to Bubbling Springs Subdivision, Section 34, T4n, R16E, Walworth County, Wisconsin.

CERTIFICATE:

I, James F. Biagi, Surveyor, do hereby certify that I have surveyed the lands hereon described.

September 15, 1971

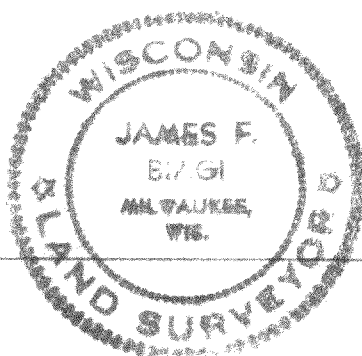

James F. Biagi

RLS / 272

416-105