


KOLB LAND CONSULTING, INC.

LAND SURVEYING • SUBDIVIDING • LAND PLANNING

929 WILLIAMS STREET LAKE GENEVA, WISCONSIN 53147 414 248-3697

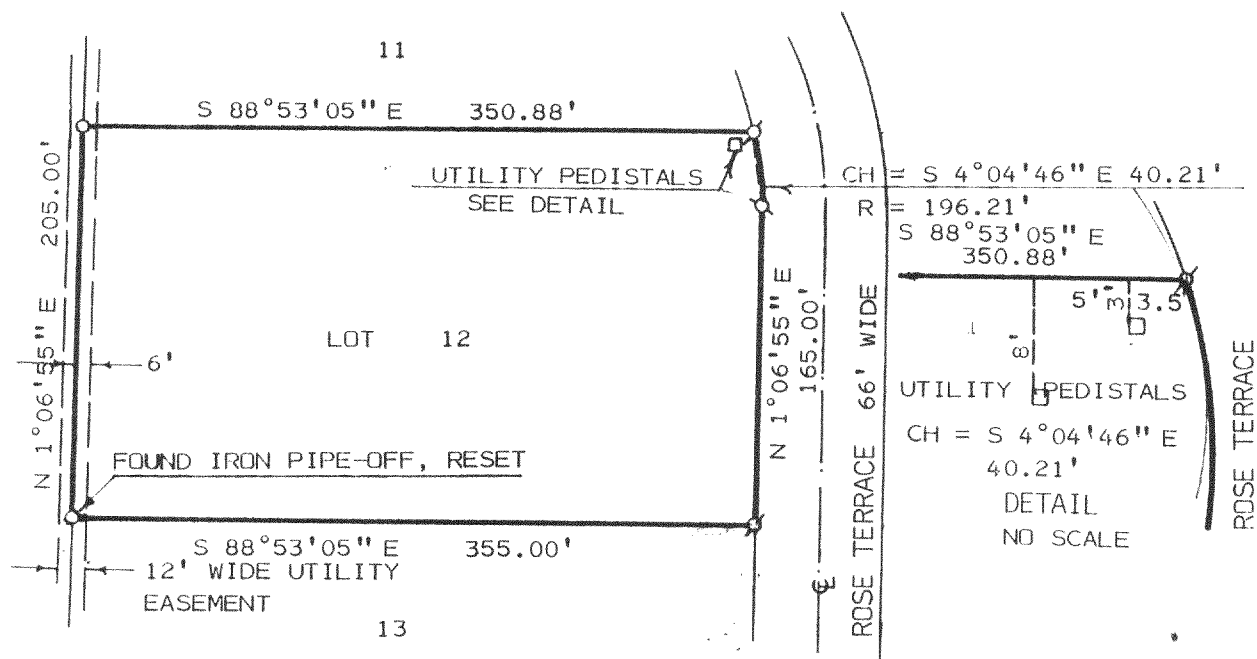


PLAT OF SURVEY OF

NOTE: BEARINGS ARE ASSUMED AS SHOWN
ON RECORDED SUBDIVISION
PLAT.

LOT 12 OF GLADHURST SUBDIVISION LOCATED IN THE
SOUTHEAST 1/4 OF SECTION 23, THE SOUTHWEST 1/4
OF SECTION 24, THE NORTHWEST 1/4 OF SECTION 25
AND THE NORTHEAST 1/4 OF SECTION 26 ALL IN T4N,
R16E, TOWN OF LAGRANGE, WALWORTH COUNTY, WIS-
CONSIN.

ORDERED BY: DAVID WILLIAMS
P.O. BOX 760
LAKE GENEVA, WI. 53147

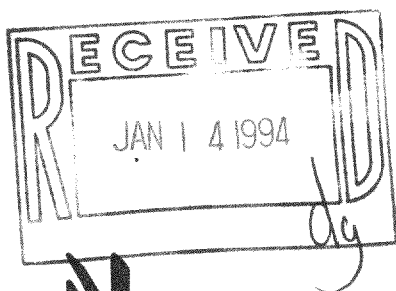

SCALE: 1" = 100'

LEGEND

- ⊗ - IRON PIPE FOUND
- - IRON PIPE SET

I HEREBY CERTIFY THAT I HAVE SURVEYED THE
ABOVE DESCRIBED PROPERTY AND THAT THE ABOVE
MAP IS A TRUE REPRESENTATION THEREOF AND
SHOWS THE SIZE AND LOCATION OF THE PROPERTY,
ITS EXTERIOR BOUNDARIES, THE LOCATION OF ALL
VISIBLE STRUCTURES AND DIMENSIONS OF ALL
PRINCIPAL BUILDINGS THEREON, BOUNDARY FENCES,
APPARENT EASEMENTS, ROADWAYS AND VISIBLE
ENCROACHMENTS, IF ANY, TO THE BEST OF MY
KNOWLEDGE AND BELIEF.

THIS SURVEY IS MADE FOR THE USE OF THE PRESENT
OWNERS OF THE PROPERTY AND ALSO THOSE WHO
PURCHASE, MORTGAGE OR GUARANTEE THE TITLE
THERETO WITHIN ONE (1) YEAR FROM DATE HEREOF.
SURVEY NOT VALID UNLESS SURVEYOR'S SIGNATURE
IS IN RED.

HAROLD H. KOLB

WISCONSIN REGISTERED LAND SURVEYOR, S-187

DATE JULY 8, 1993

REVISED

REVISED