
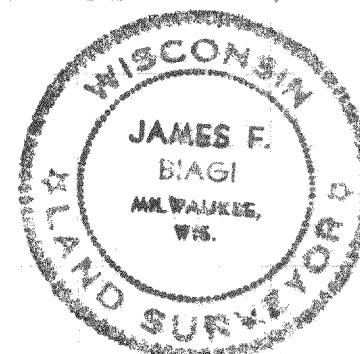



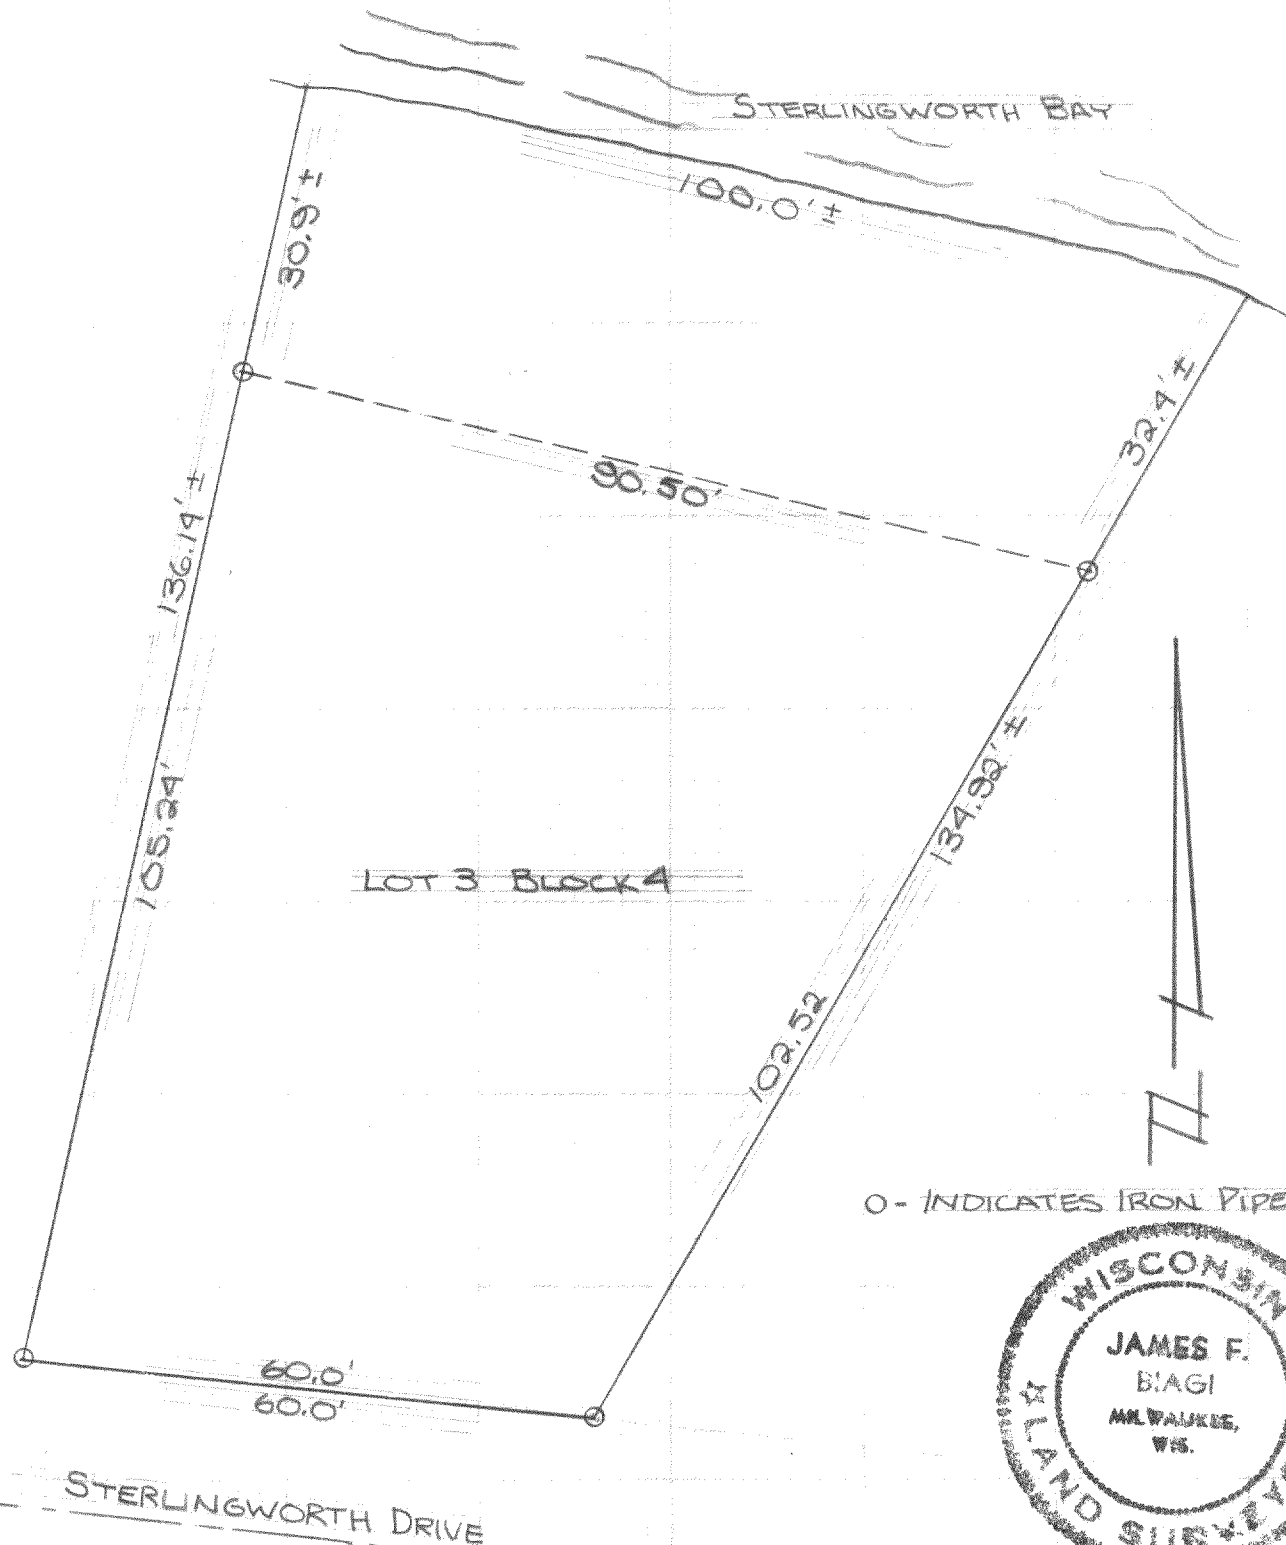


DESCRIPTION: Lot 3 Block 4, Bay View Manor Subdivision, located in Section 36, T. 4 N., R. 16 E., Walworth County, Wisconsin.

CERTIFICATE: I, James F. Biagi, surveyor, do hereby certify that I have surveyed the property hereon described.

June 7, 1971

James F. Biagi RLS/272

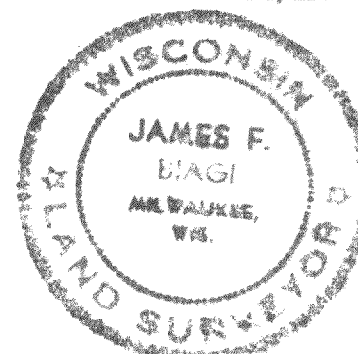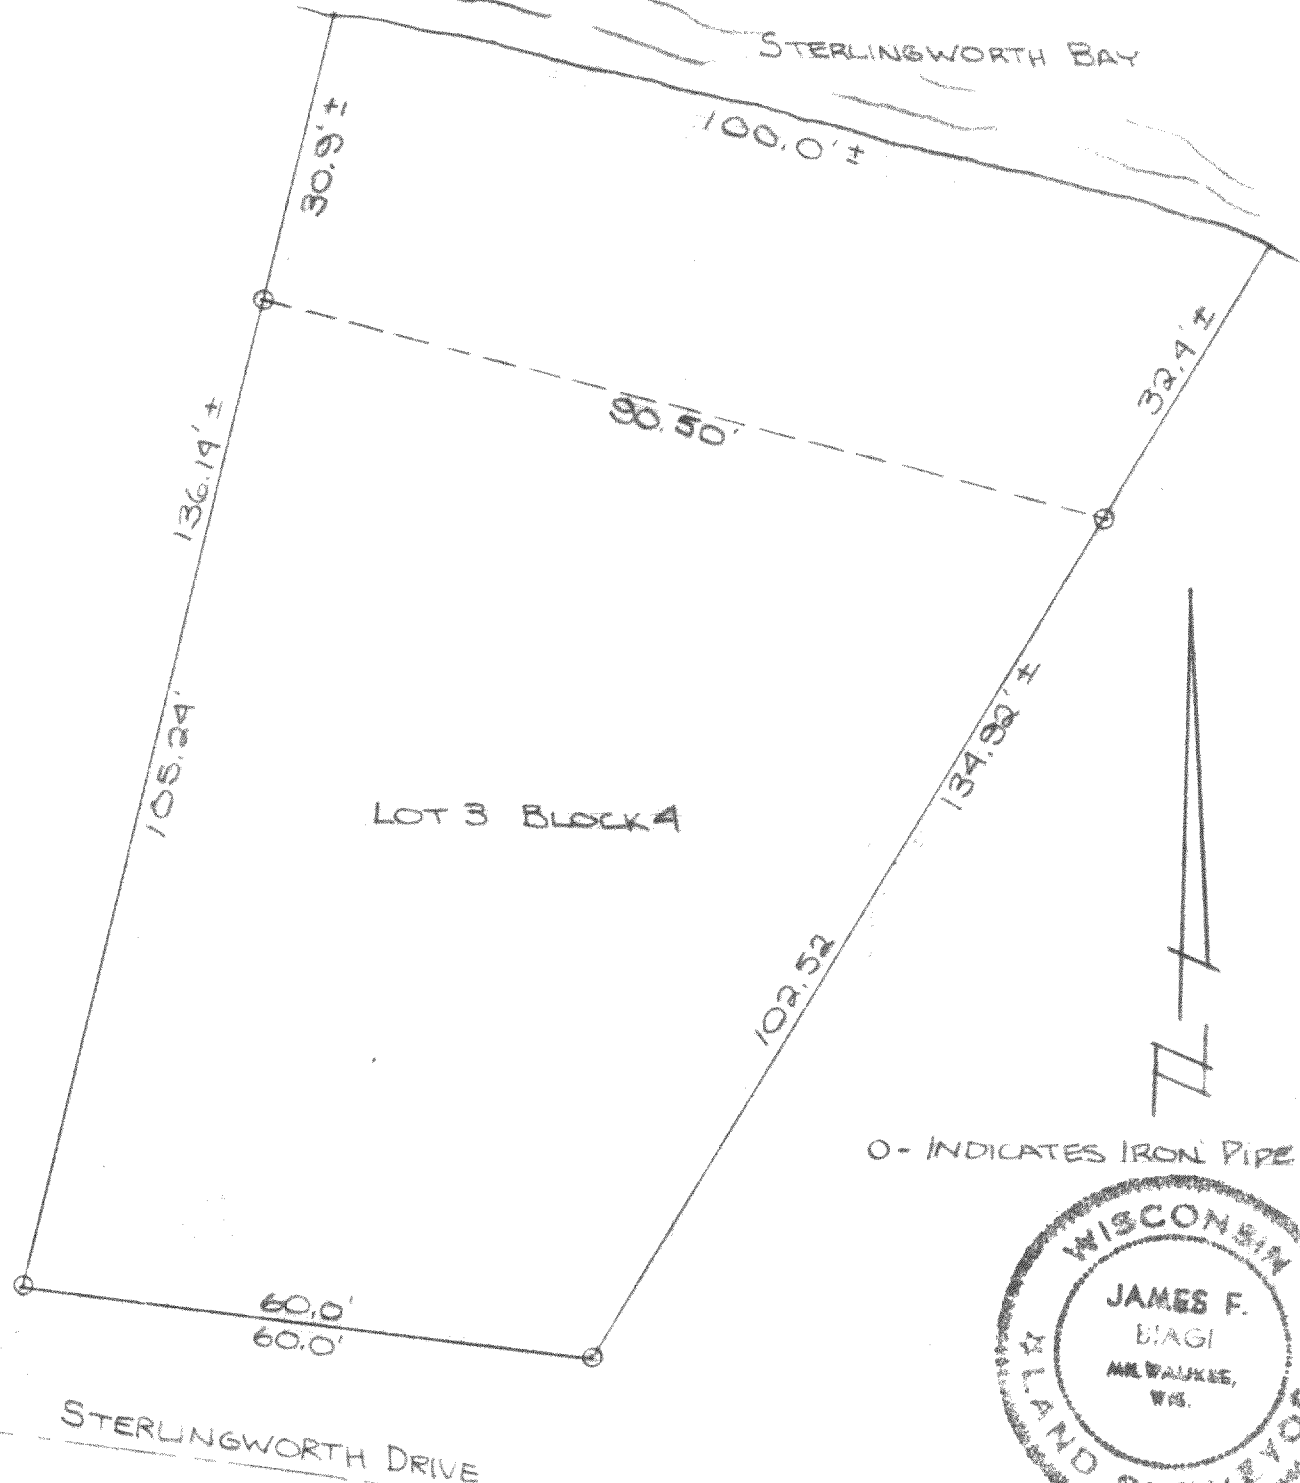

DESCRIPTION: Lot 3 Block 4, Bay View Manor Subdivision, located in Section 36, T. 4 N., R. 16 E., Walworth County, Wisconsin.

CERTIFICATE: I, James F. Biagi, surveyor, do hereby certify that I have surveyed the property hereon described.

June 7, 1971

James F. Biagi RLS/272