




Plat of Survey

Survey For **John Spragia**
Location **Lauderdale Chain of Lakes**

Description **LOT 6 BLOCK 2, in COOL HILL PARK, a subdivision in the N.W. 1/4 and the S.W. 1/4 of Section 35, Town 4 North, Range 16 East, Walworth County, Wisconsin.**

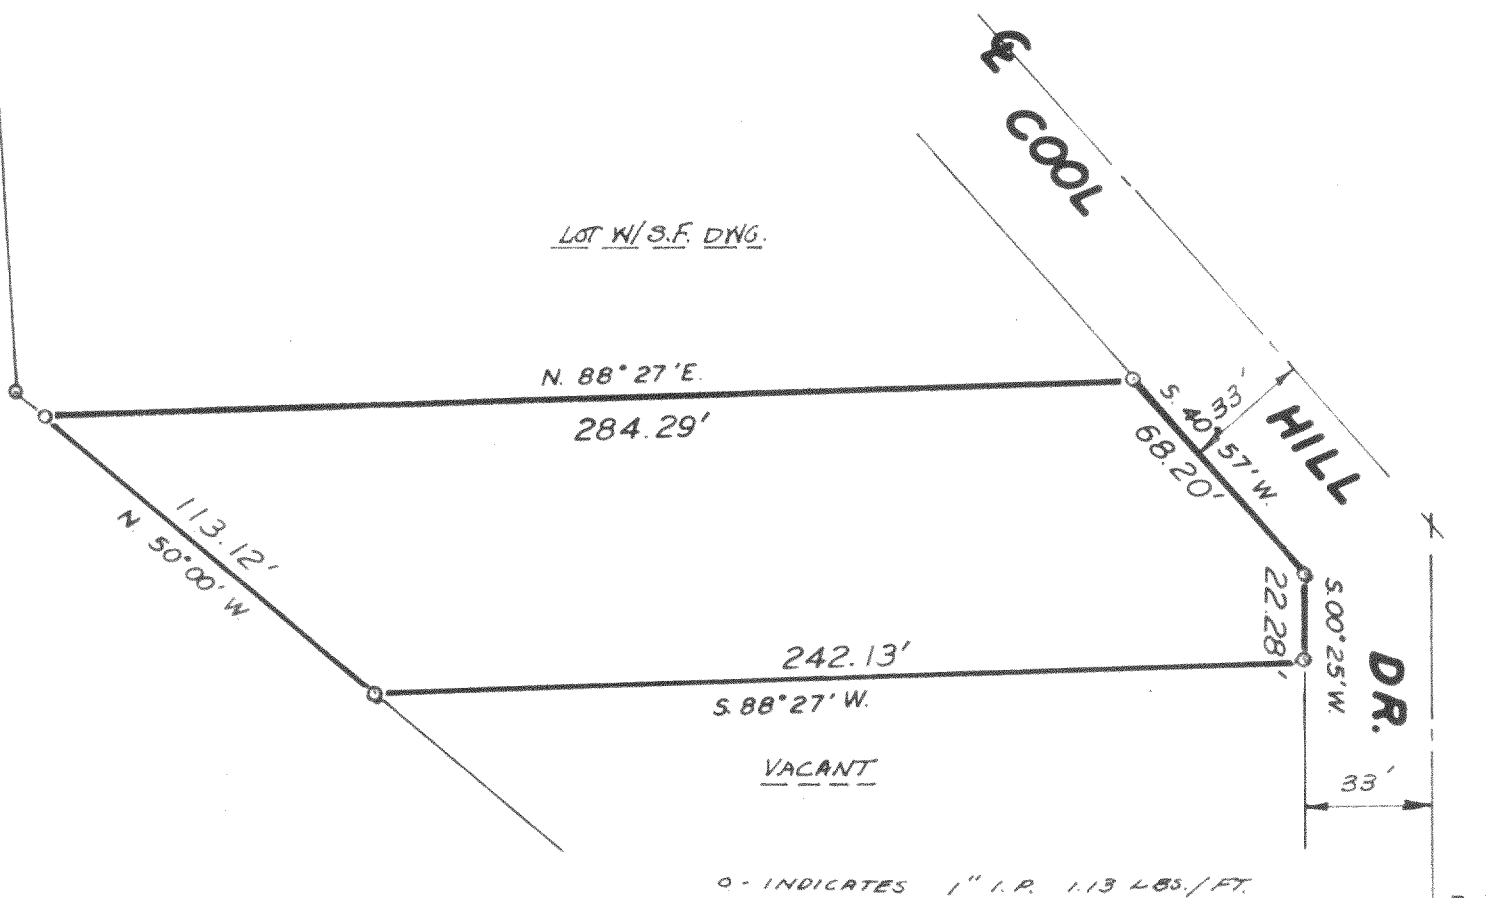

Scale: 1" = 50'

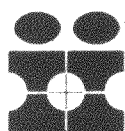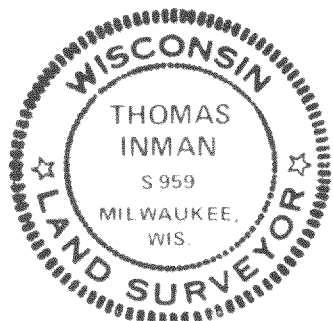

inman, inc.
ENGINEERS
SURVEYORS
LAND PLANNERS

State of Wisconsin)
Milwaukee County) ss I hereby certify that I have surveyed the above described property, that the above plat is a true representation thereof and correctly shows the exterior boundary lines, location of principal buildings and other visible improvements relative to said boundary lines.

Thomas Inman
Thomas Inman, Registered Land Surveyor

Date: 8/23/72
Job No: 5906

Hc 4-12

416-108