


DUNHAM SURVEYING, S.C.
SURVEYING & SUBDIVIDING
DELAVER, WISCONSIN 53115

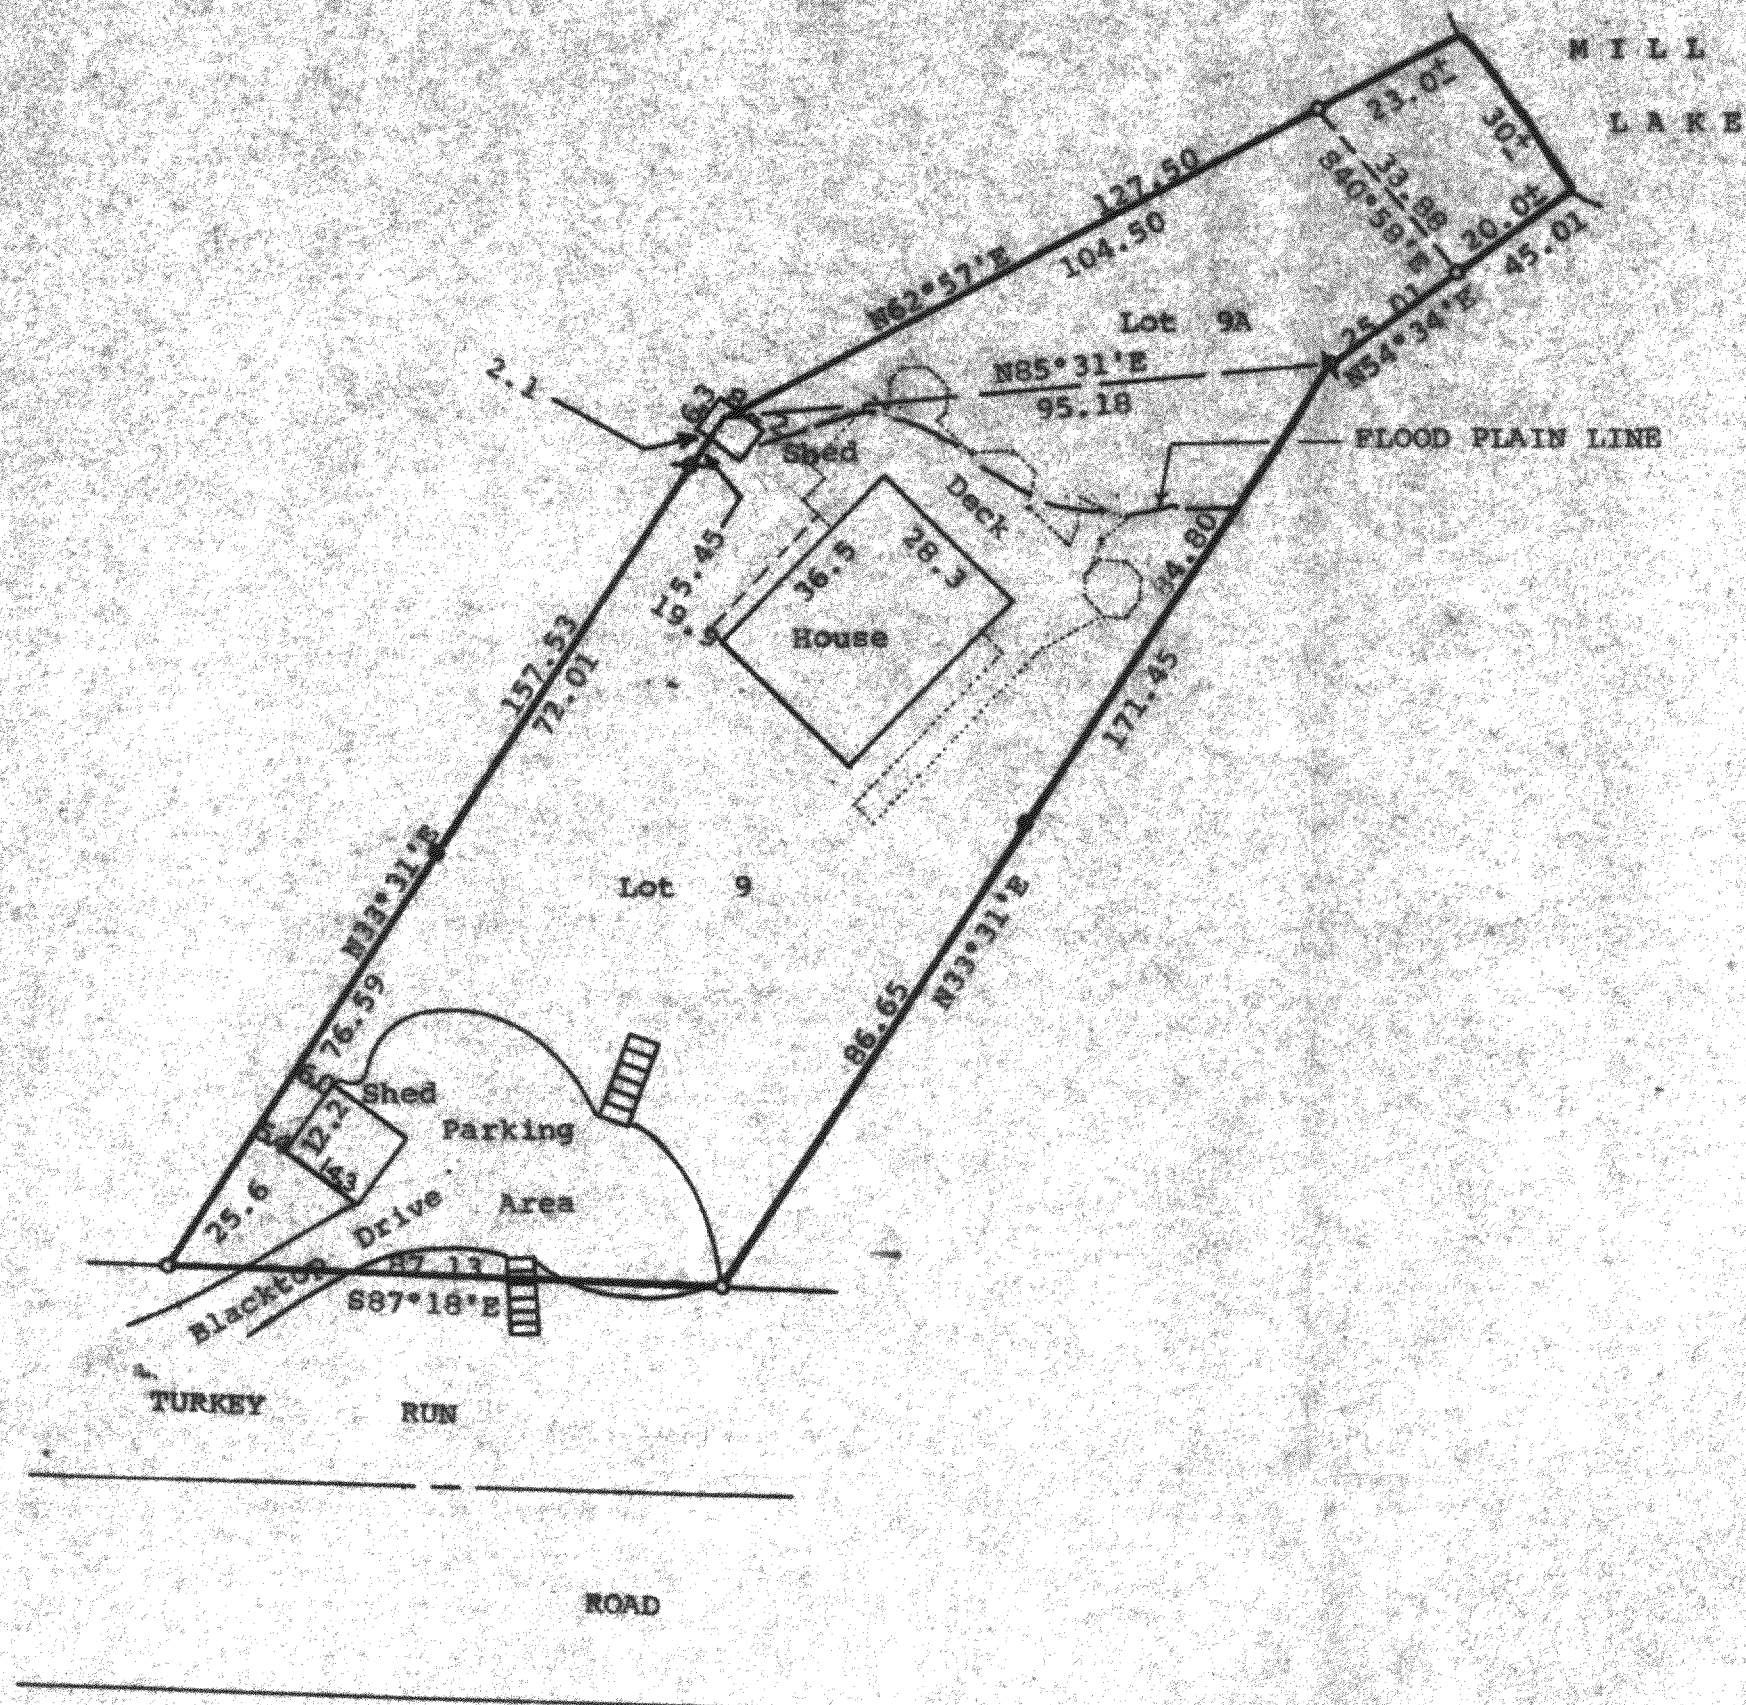

Scale - 1" = 30'

● = 1 1/4" Dia. Iron Pipe Found
○ = 1" Dia. Iron Pipe Found
⊙ = 3/4" Dia. Iron Pipe Found
⊙ = 3/4"x24" Iron Pipe Set

Bearings used are those of record.

Survey Ordered By:
Kenosha Savings and Loan Association
410 Broad Street
Lake Geneva, Wisconsin 53147
Updating and recertification ordered by:
Rome Design MFG. Corp.
Highway 67 North
Fontana, WI 53125

STATE OF WISCONSIN)
COUNTY OF WALWORTH) SS


I, George T. Dunham, Surveyor, certify that I have surveyed the property described as follows,

Lots 9 and 9A of Arrowhead Park, a subdivision located in Government Lot 3 in the Northwest 1/4 of the Southeast 1/4 of Section 35, T4N, R16E, Walworth County, Wisconsin, and that the map shown hereon is a correct representation thereof and shows the size and location of the property, its exterior boundaries, the location of all visible structures and dimensions of all principal buildings thereon, boundary fences, apparent easements, roadways and visible encroachments, if any, and that I have surveyed the property hereon described according to the official records, to the best of my knowledge and belief.

March 17, 1988.

Updated and recertified to this
7th day of March, 1994

George T. Dunham
George T. Dunham, Surveyor

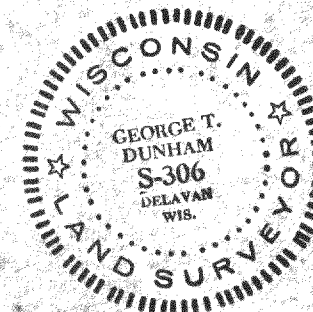

HAP-13
HAP-14

416-1115

416-124