


ABELL
SURVEYING & MAPPING
DELAVAN, WISCONSIN 53115
414-728-6737

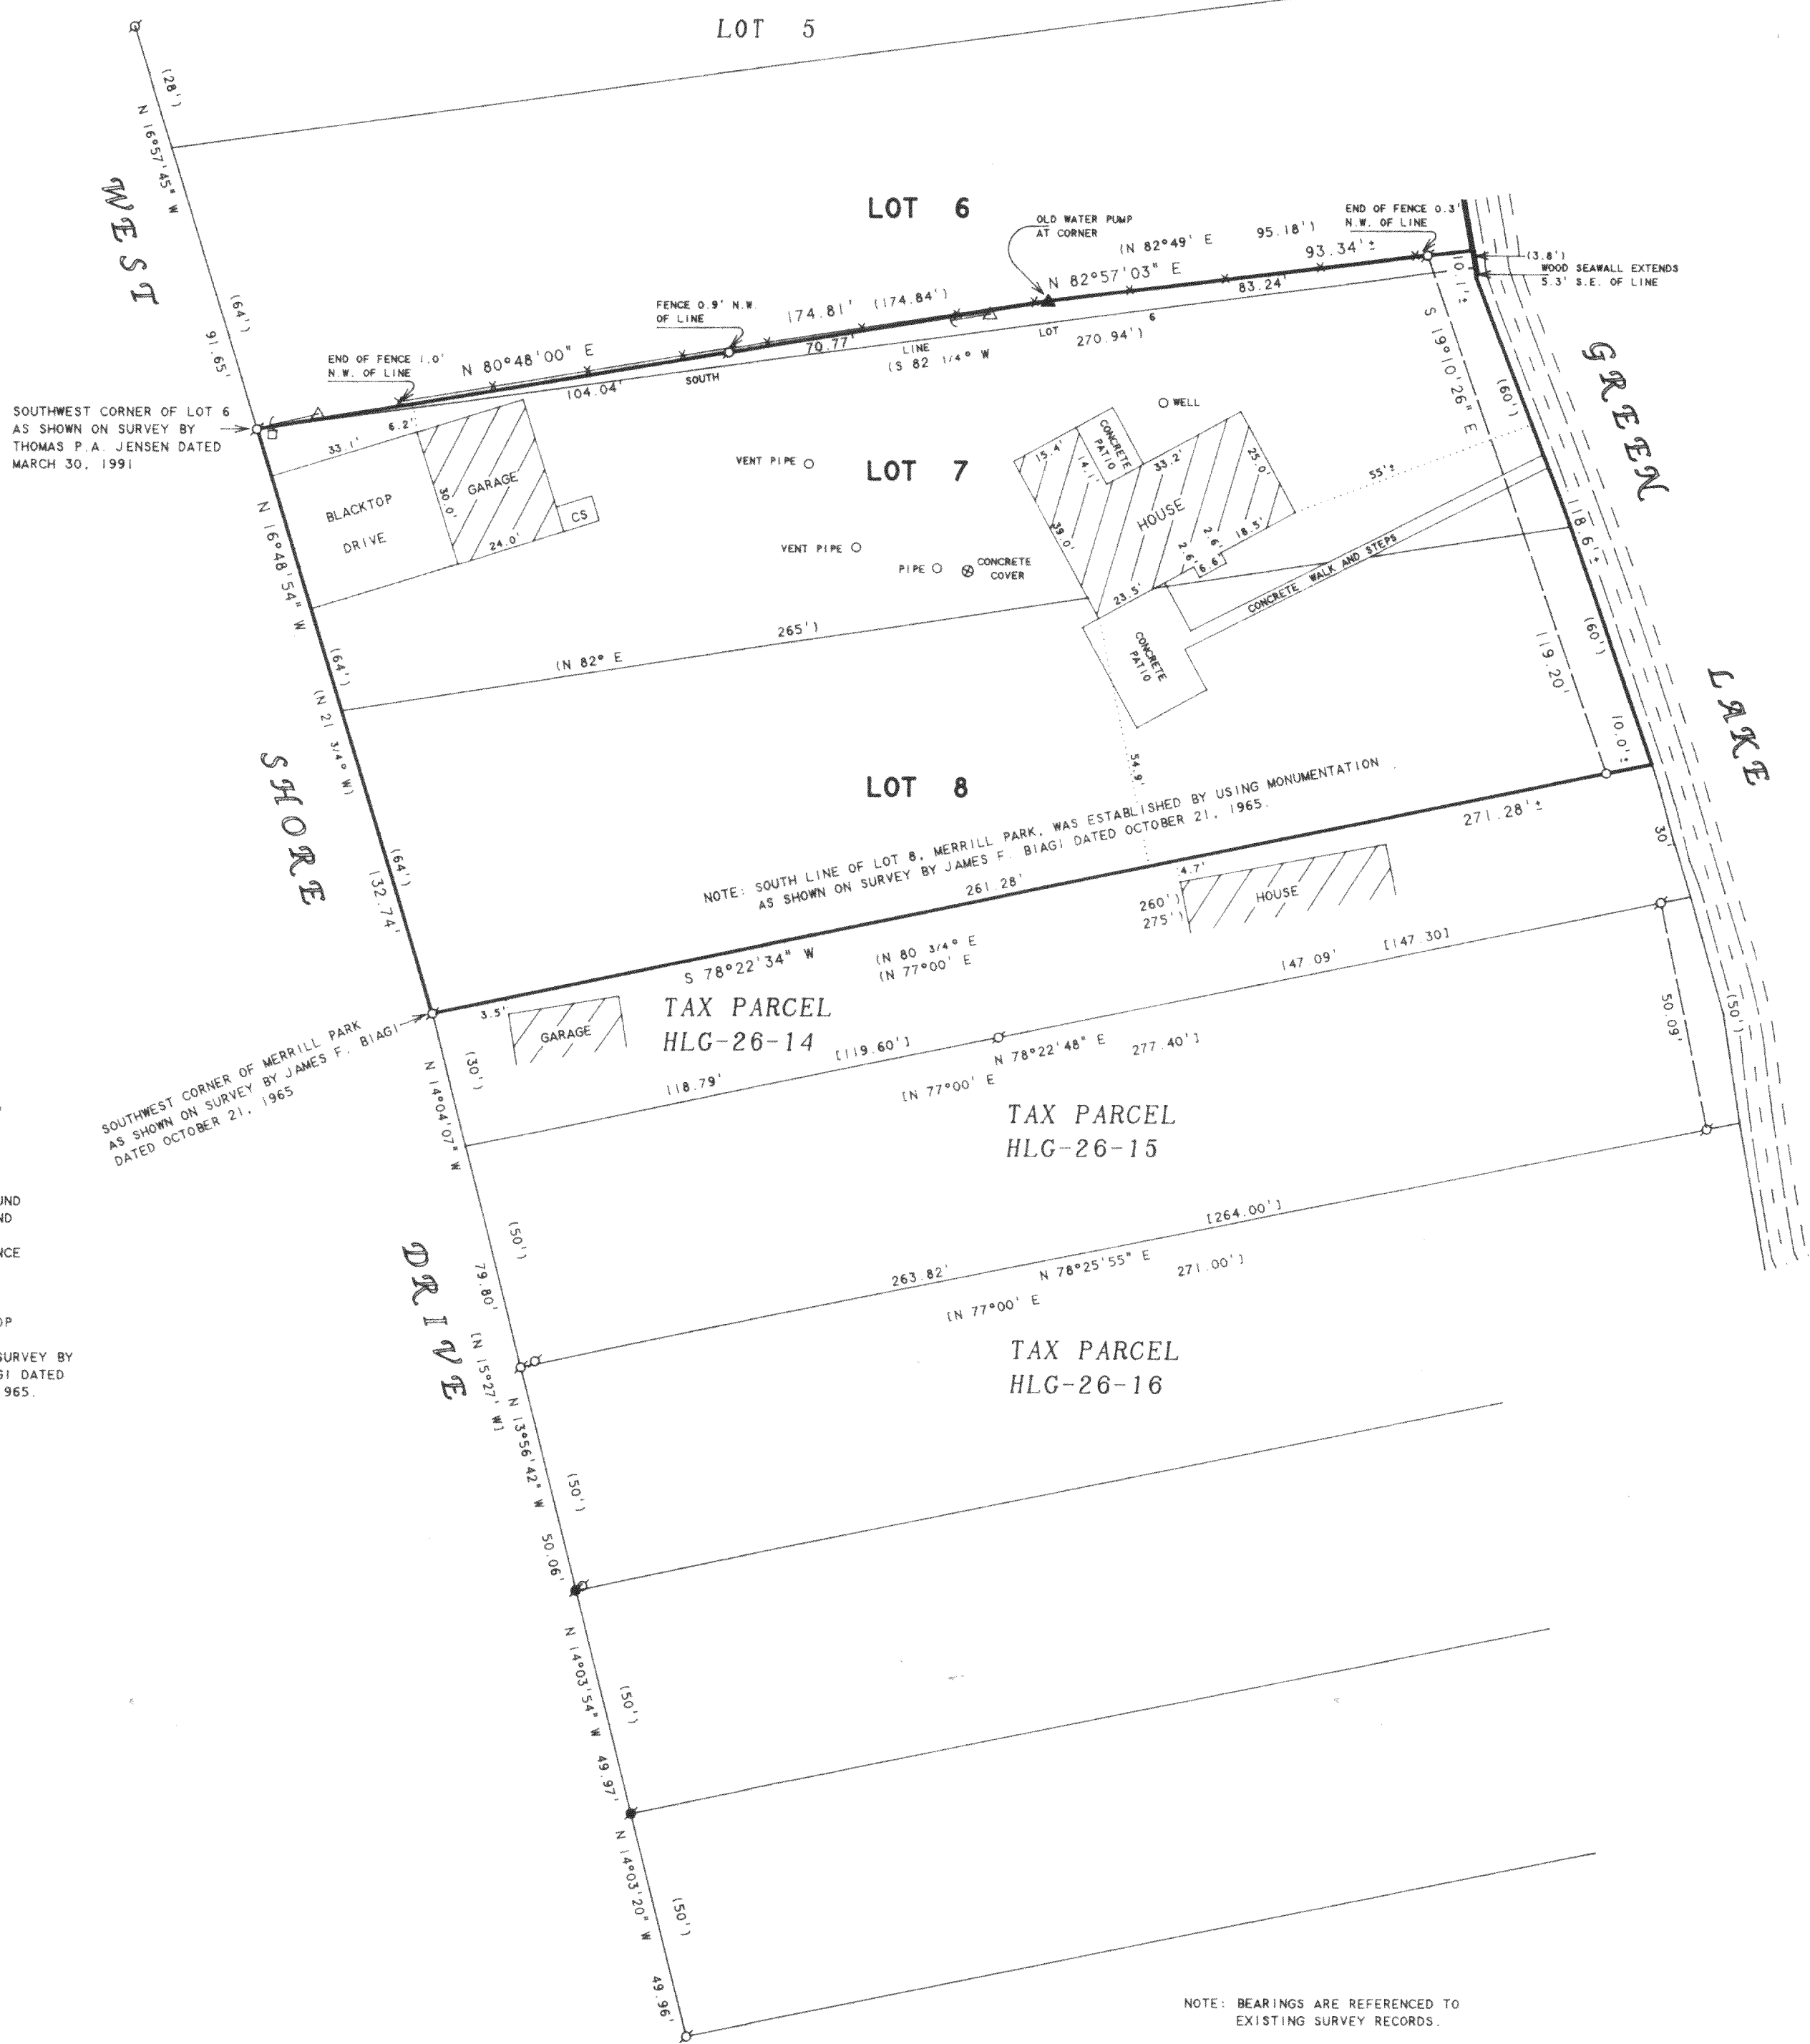

SCALE 1"=30'
LEGEND


- -IRON PIPE FOUND
- -IRON ROD FOUND
- -IRON ROD SET
- △ -CHAINLINK FENCE
- △ -UTILITY POLE
- GUY WIRE
- -UTILITY PED.
- CS -CONCRETE STOOP
- () -RECORDED AS
- () -AS SHOWN ON SURVEY BY JAMES F. BIAGI DATED OCTOBER 21, 1965.

PLAT OF SURVEY OF

LOTS 7 AND 8 AND THAT PORTION OF LOT 6 DESCRIBED AS FOLLOWS: BEGINNING AT THE SOUTHWEST CORNER OF SAID LOT 6; THENCE N 80°48' E 174.84 FEET; THENCE N 82°49' E 95.18 FEET TO THE SHORE OF GREEN LAKE; THENCE SOUTHERLY 3.8 FEET ALONG SHORE; THENCE S 82 1/4° W 270.94 FEET TO THE PLACE OF BEGINNING, ALL IN MERRILL PARK LOCATED IN T4N, R16E, WALWORTH COUNTY, WISCONSIN.

NOTE: BEARINGS ARE REFERENCED TO EXISTING SURVEY RECORDS.

ORDERED BY: CENTURY 21 - WALTON REALTY
202 EAST MAIN STREET
WHITEWATER, WI. 53190

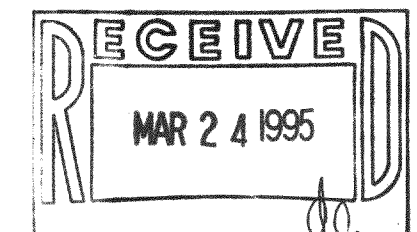

I HEREBY CERTIFY THAT I HAVE SURVEYED THE ABOVE DESCRIBED PROPERTY AND THAT THE ABOVE MAP IS A TRUE REPRESENTATION THEREOF AND SHOWS THE SIZE AND LOCATION OF THE PROPERTY, ITS EXTERIOR BOUNDARIES, THE LOCATION OF ALL VISIBLE STRUCTURES AND DIMENSIONS OF ALL PRINCIPAL BUILDINGS THEREON, BOUNDARY FENCES, APPARENT EASEMENTS, ROADWAYS AND VISIBLE ENCROACHMENTS, IF ANY, TO THE BEST OF MY KNOWLEDGE AND BELIEF.

THIS SURVEY IS MADE FOR THE USE OF THE PRESENT OWNERS OF THE PROPERTY, AND ALSO THOSE WHO PURCHASE, MORTGAGE, OR GUARANTEE THE TITLE THERETO WITHIN ONE (1) YEAR FROM DATE HEREON.

David F. Abell
DAVID F. ABELL
WISCONSIN REGISTERED LAND SURVEYOR, S-1596

November 3, 1994

DATE: NOVEMBER 3, 1994
JOB NUMBER - 94188
NOTE: THIS IS NOT A CERTIFIED COPY UNLESS SEALED.

HME-4A
416-1117