


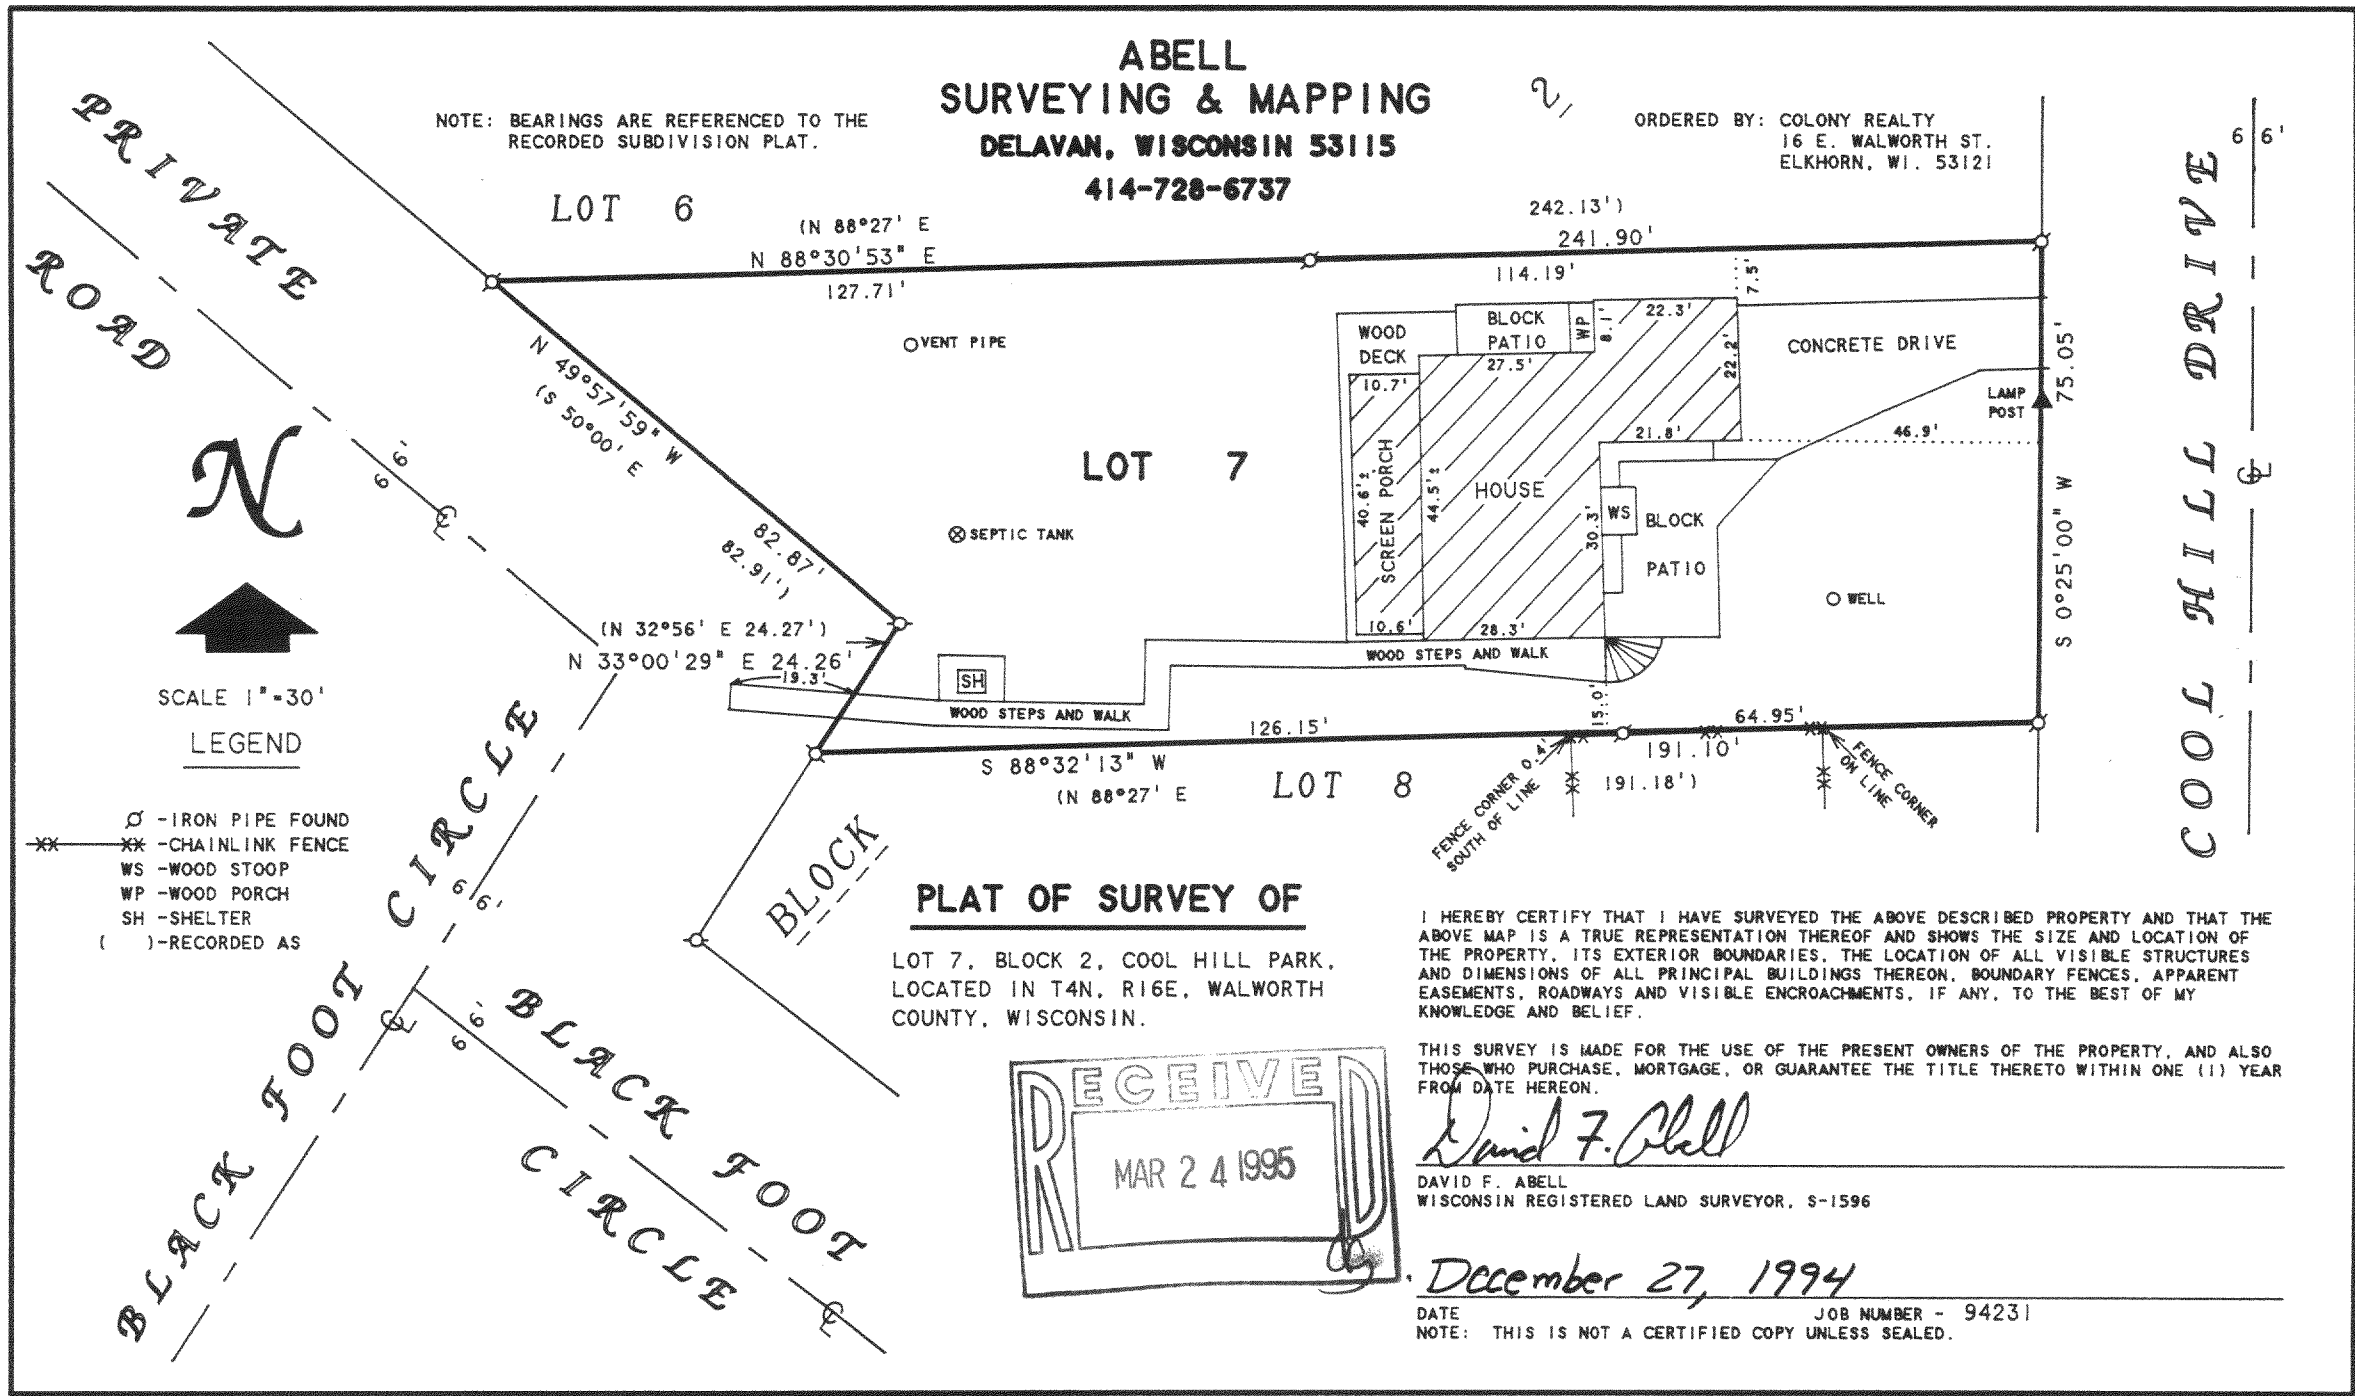

HCH-13

416-1118