

FARRIS, HANSEN & ASSOCIATES, INC.

7 RIDGEWAY COURT, P.O. BOX 437
ELKHORN, WISCONSIN 53121

PLAT OF SURVEY


PHONE: (414) 723-2098
FAX: (414) 723-5886

LOCATION:
LOT 32 OF LAUDERDALE HEIGHTS
SEC. 36, T. 4 N., R. 16 E.
WALWORTH COUNTY, WI.

WORK ORDERED BY:
WILLIAM SCHUBERT
9446 W. DEE ROAD
DES PLAINES, IL.

MAP LEGEND

- = IRON PIPE STAKE FOUND
- = IRON PIPE STAKE SET
- = IRON ROD STAKE FOUND
- = IRON ROD STAKE SET
- = CONCRETE MONUMENT FOUND
- = RECORD DIMENSION
- ✱ = SET RR SPIKE IN PAVEMENT

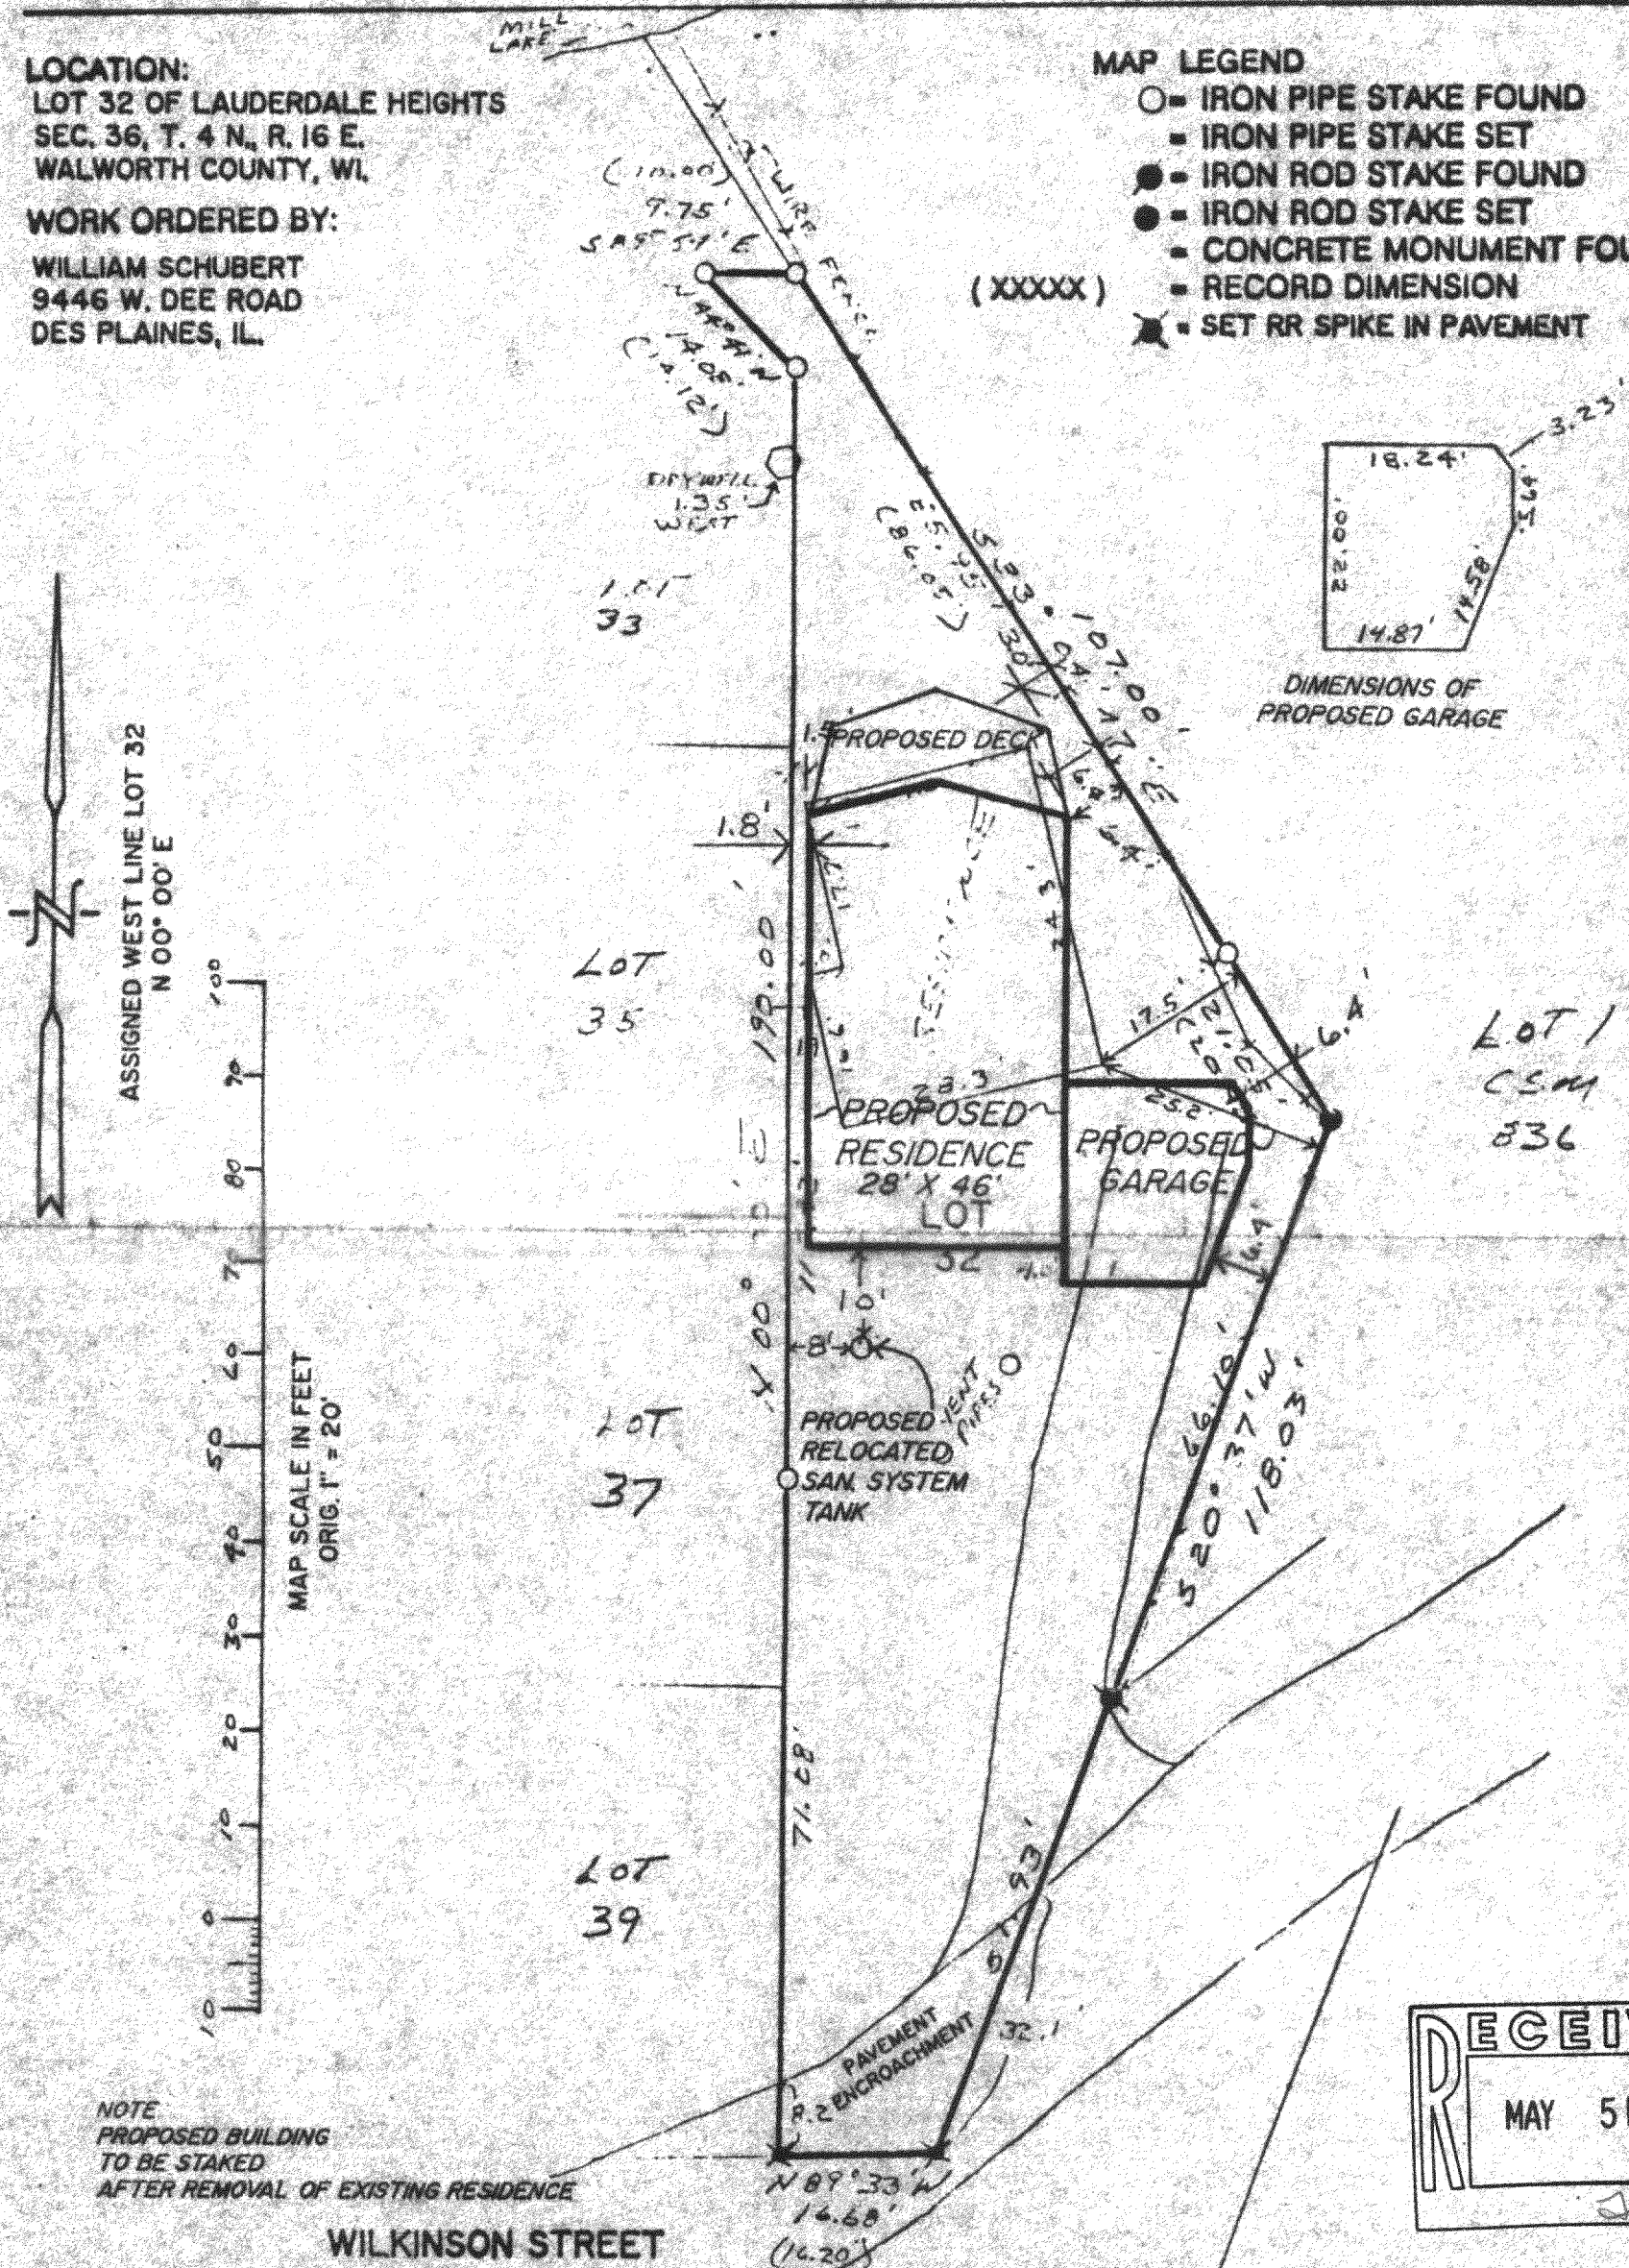

NOTE: COPIES OF THIS MAP TO WHICH THE FOLLOWING CERTIFICATE WILL APPLY ARE BLUE LINE PRINTS SHOWING SURVEYOR'S ORIGINAL SEAL AND SIGNATURE IN BLACK INK. COPIES BY ANY OTHER MEANS MAY HAVE ALTERATIONS WHICH DO NOT REPRESENT THE SURVEYOR'S WORK PRODUCT.


I HEREBY CERTIFY THAT THE ABOVE DESCRIBED PROPERTY HAS BEEN SURVEYED UNDER MY DIRECTION AND THAT THE ABOVE MAP IS A TRUE REPRESENTATION THEREOF AND SHOWS THE SIZE AND LOCATION OF THE PROPERTY AND ITS EXTERIOR BOUNDARIES. THIS SURVEY IS MADE FOR THE USE OF THE PRESENT OWNERS OF THE PROPERTY, AND ALSO THOSE WHO PURCHASE, MORTGAGE, OR GUARANTEE THE TITLE THERETO WITHIN ONE YEAR FROM THE DATE HEREOF.

DATED: 06/15/95

REVISED 4/13/94

SHOW SIZE AND LOCATION OF PROPOSED RES. & GARAGE

REVISED 4-24-95 TO SHOW DECKS + GARAGE AS BUILT (SEE SHEET 3)

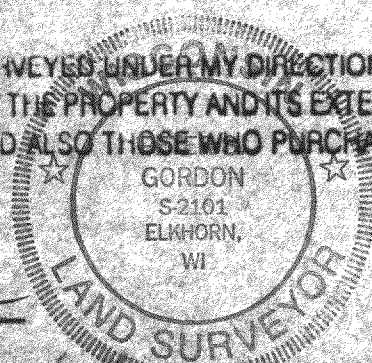


PROJECT NO. 3853

SHEET 1 OF 2

FARRIS, HANSEN & ASSOCIATES, INC.
ENGINEERING, ARCHITECTURE, SURVEYING
7 RIDGWAY COURT - P.O. BOX 437, ELKHORN, WISCONSIN 53121
PHONE: (414) 723-2098 FAX: (414) 723-5886

ADDENDUM TO SURVEY DATED 04-19-1994

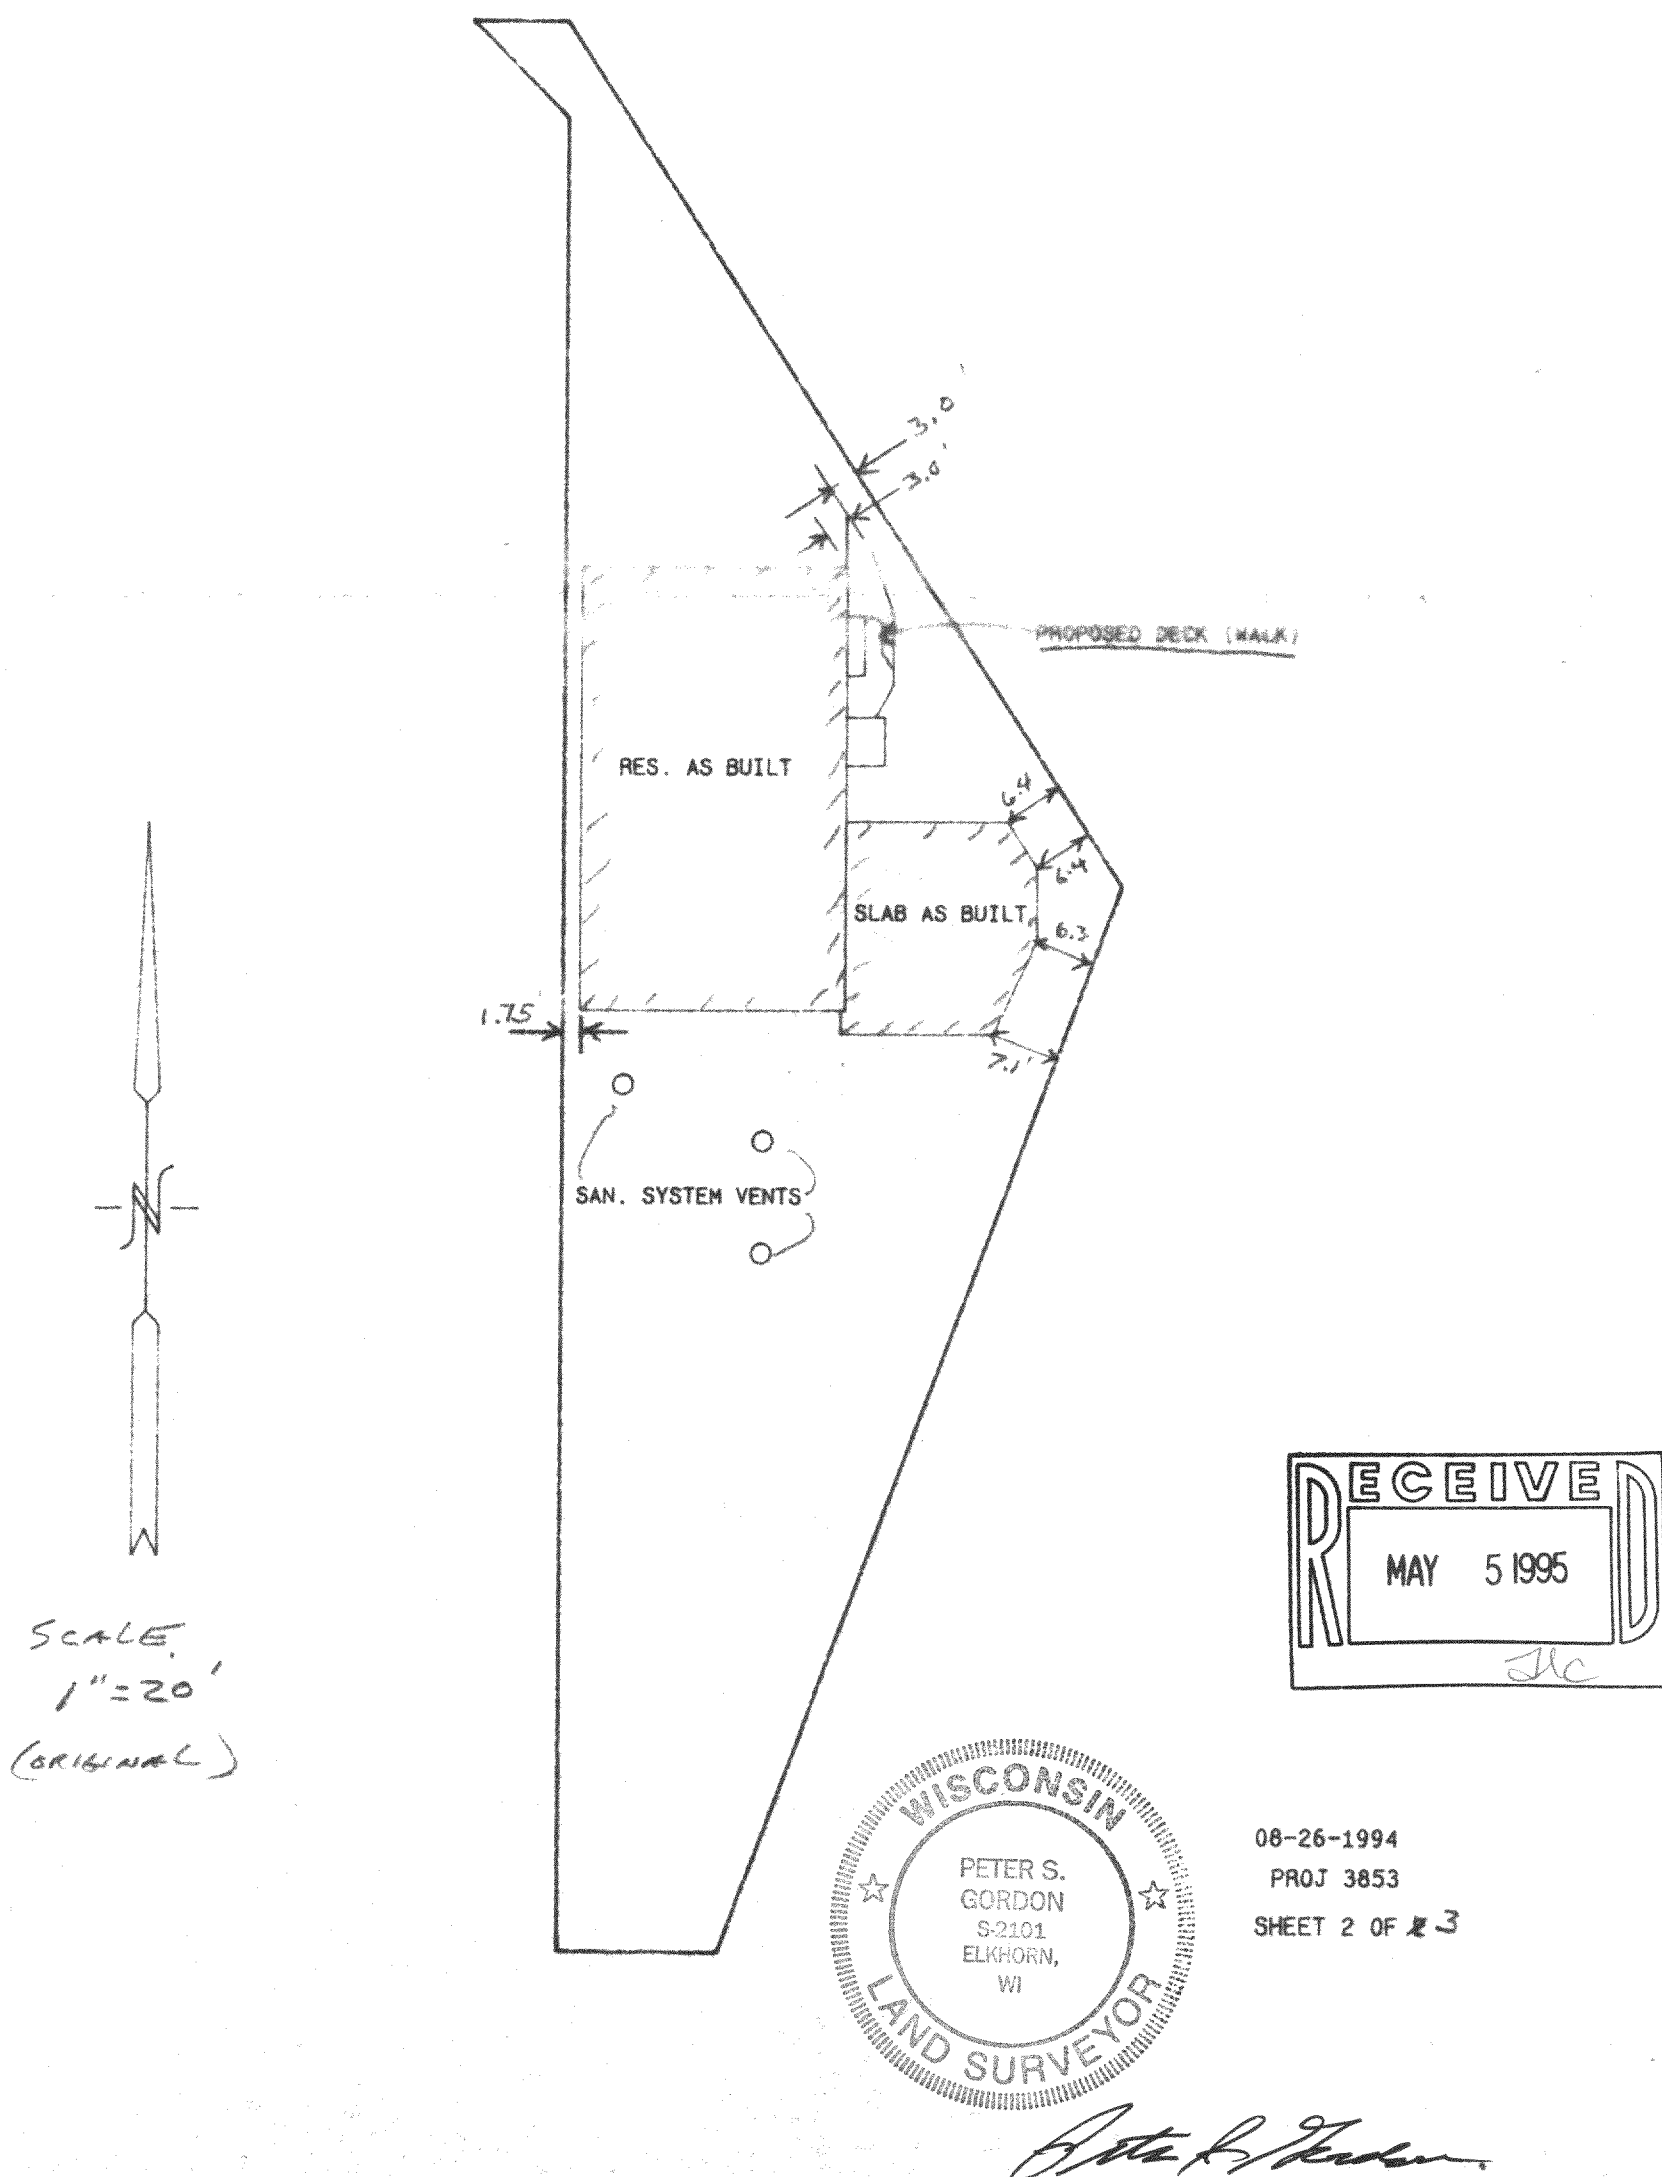


HCH-7




416-1121

FARRIS, HANSEN & ASSOCIATES, INC.
 ENGINEERING, ARCHITECTURE, SURVEYING
 7 RIDGWAY COURT - P.O. BOX 437, ELKHORN, WISCONSIN 53121
 PHONE: (414) 723-2098 FAX: (414) 723-5886

ADDENDUM TO SURVEY DATED 4-19-95
 TO SHOW DECKS AND GARAGE AS BUILT

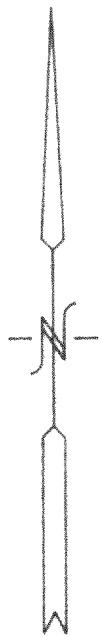

SKETCH SCALE 1" = 10'

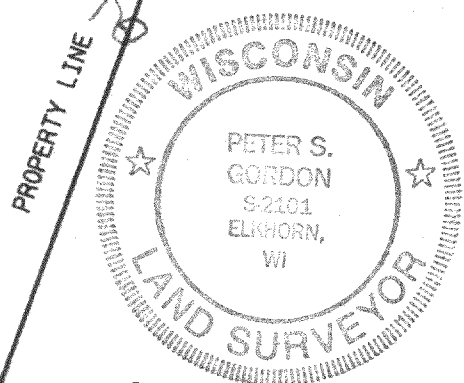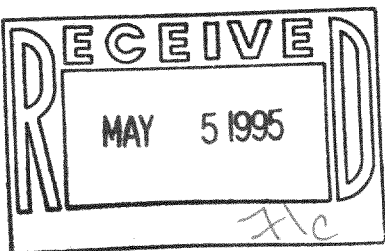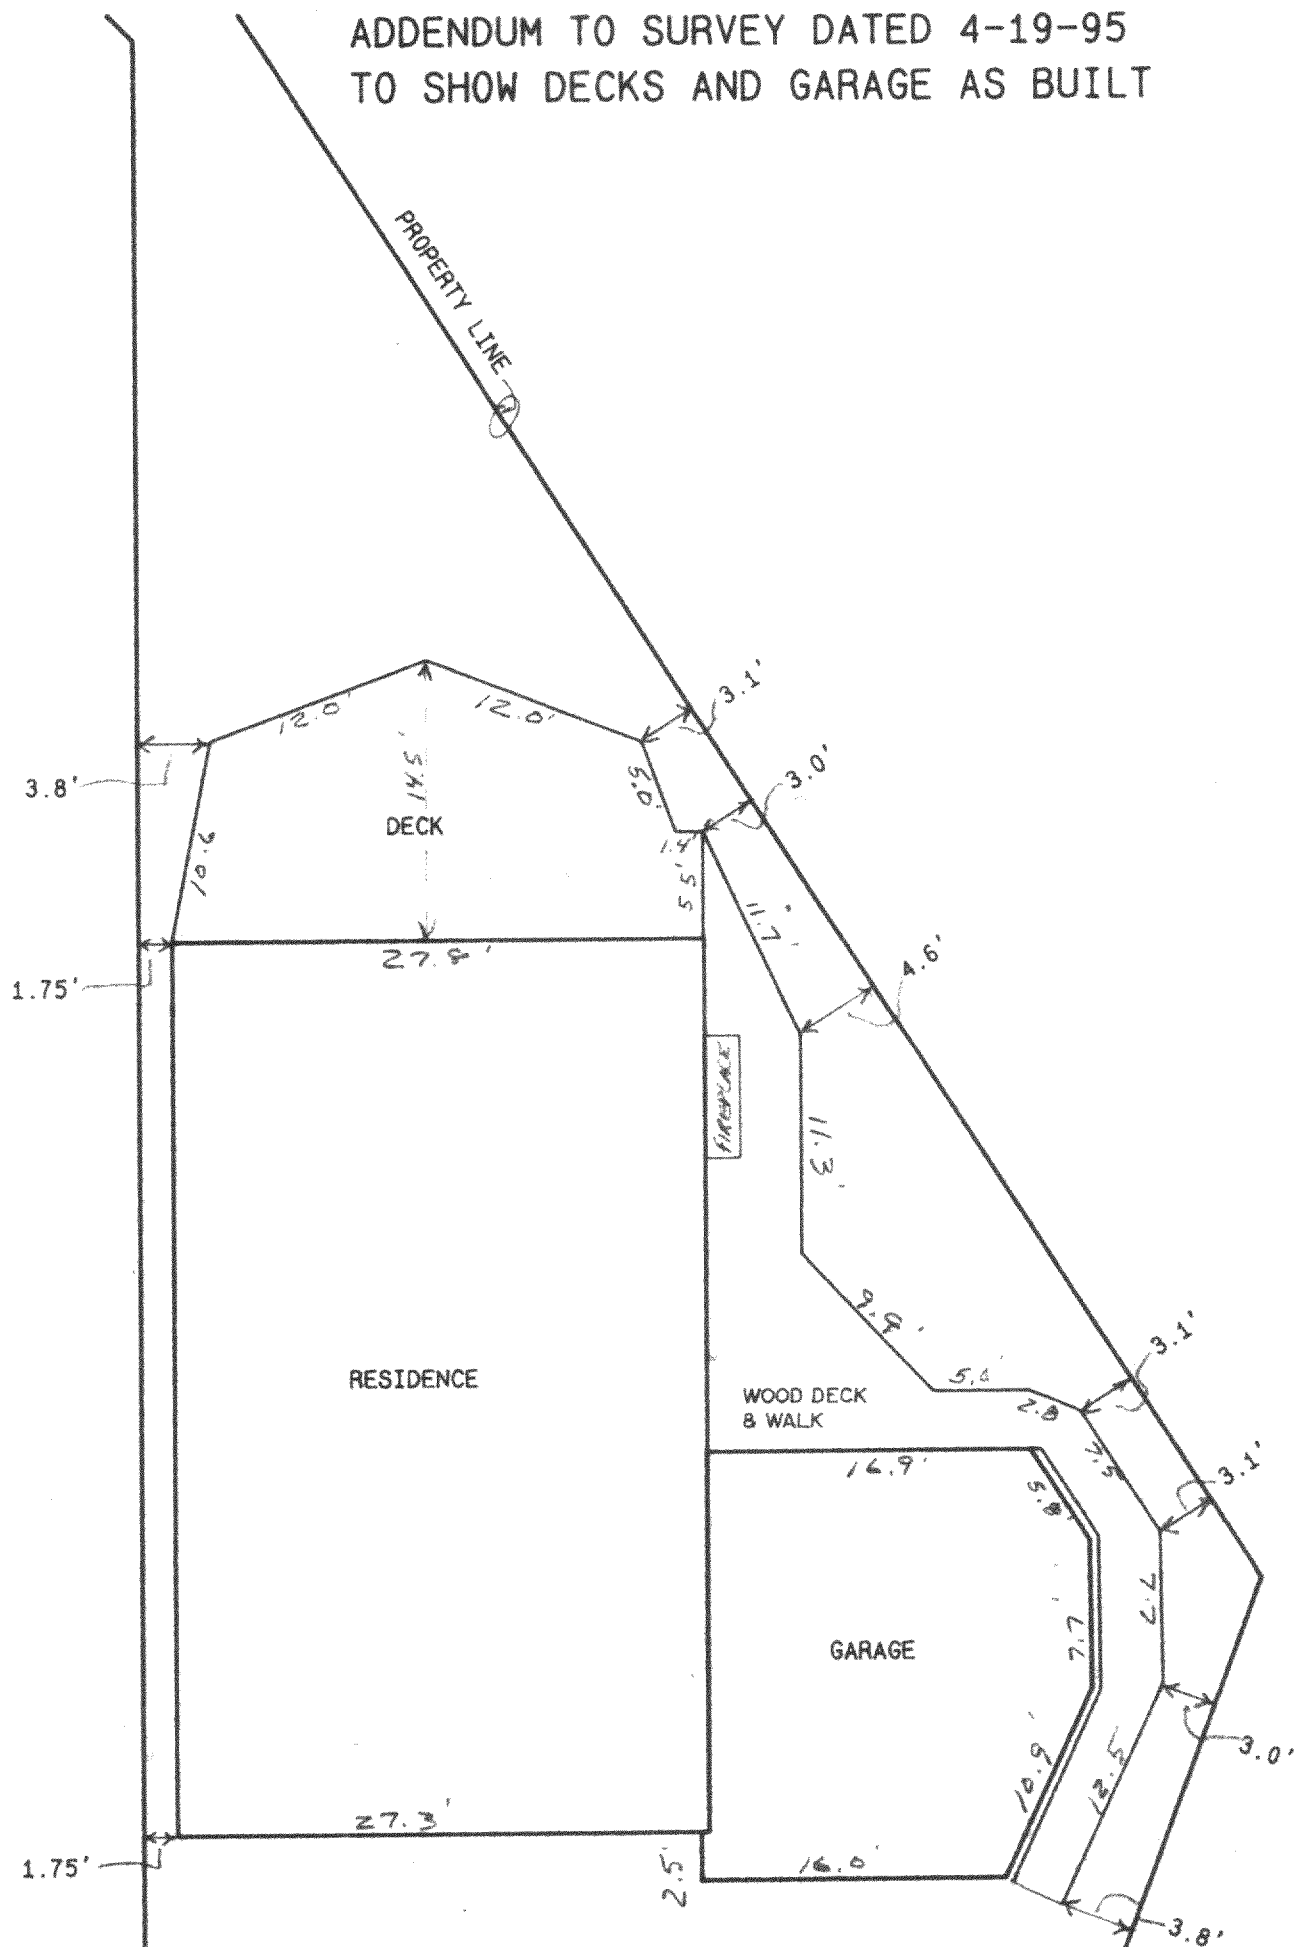

Peter S. Gordon

PROJ 3853
 04-24-1995
 SHEET 3 OF 3

416-1121

HLH-7