


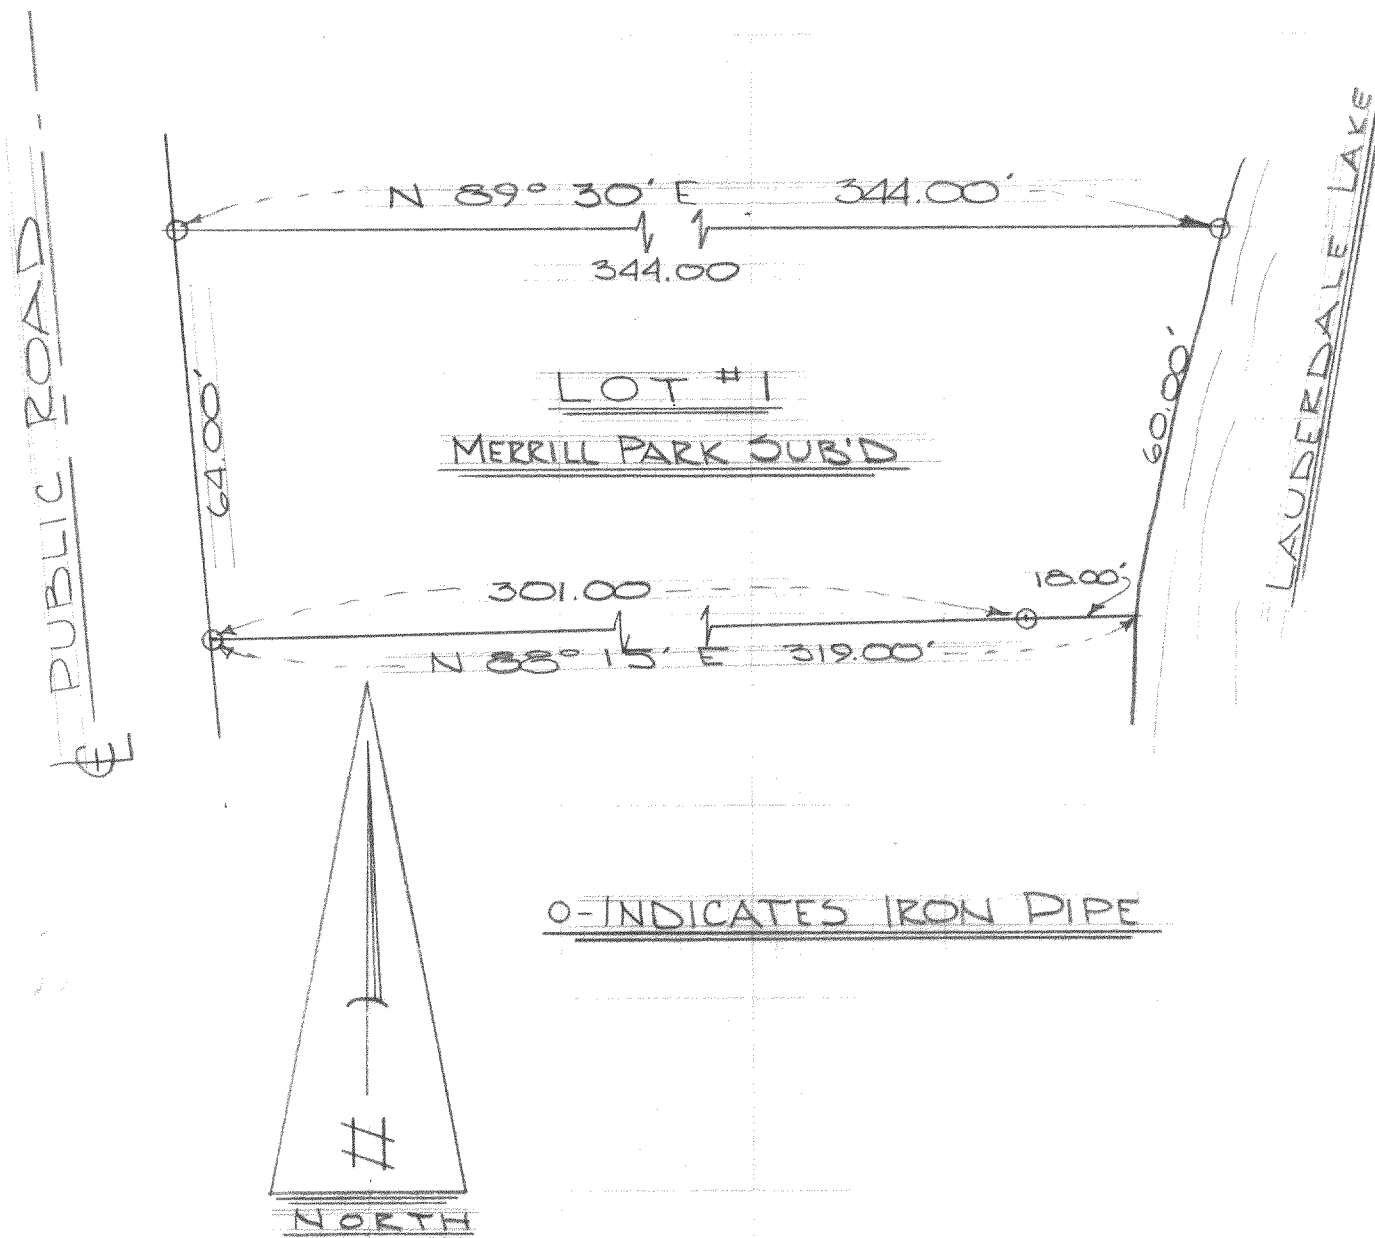

DESCRIPTION; Lot #1 of Merrill Park located in Section 26 of T. 4 N.,
R. 16 E. Walworth County, Wisconsin.

Plat of survey by James F. Biagi, Oct 21, 1965.

James F. Biagi
James F. Biagi RLS 272

