


TOPOGRAPHIC SURVEY
SITE GRADING & EROSION CONTROL PLAN

LOT 25 AND PART OF LOT 24, DROUGHTVILLE PARK,
LOCATED IN SECTION 25 & 36, TOWN 4 NORTH,
RANGE 16 EAST, WALWORTH COUNTY, WISCONSIN

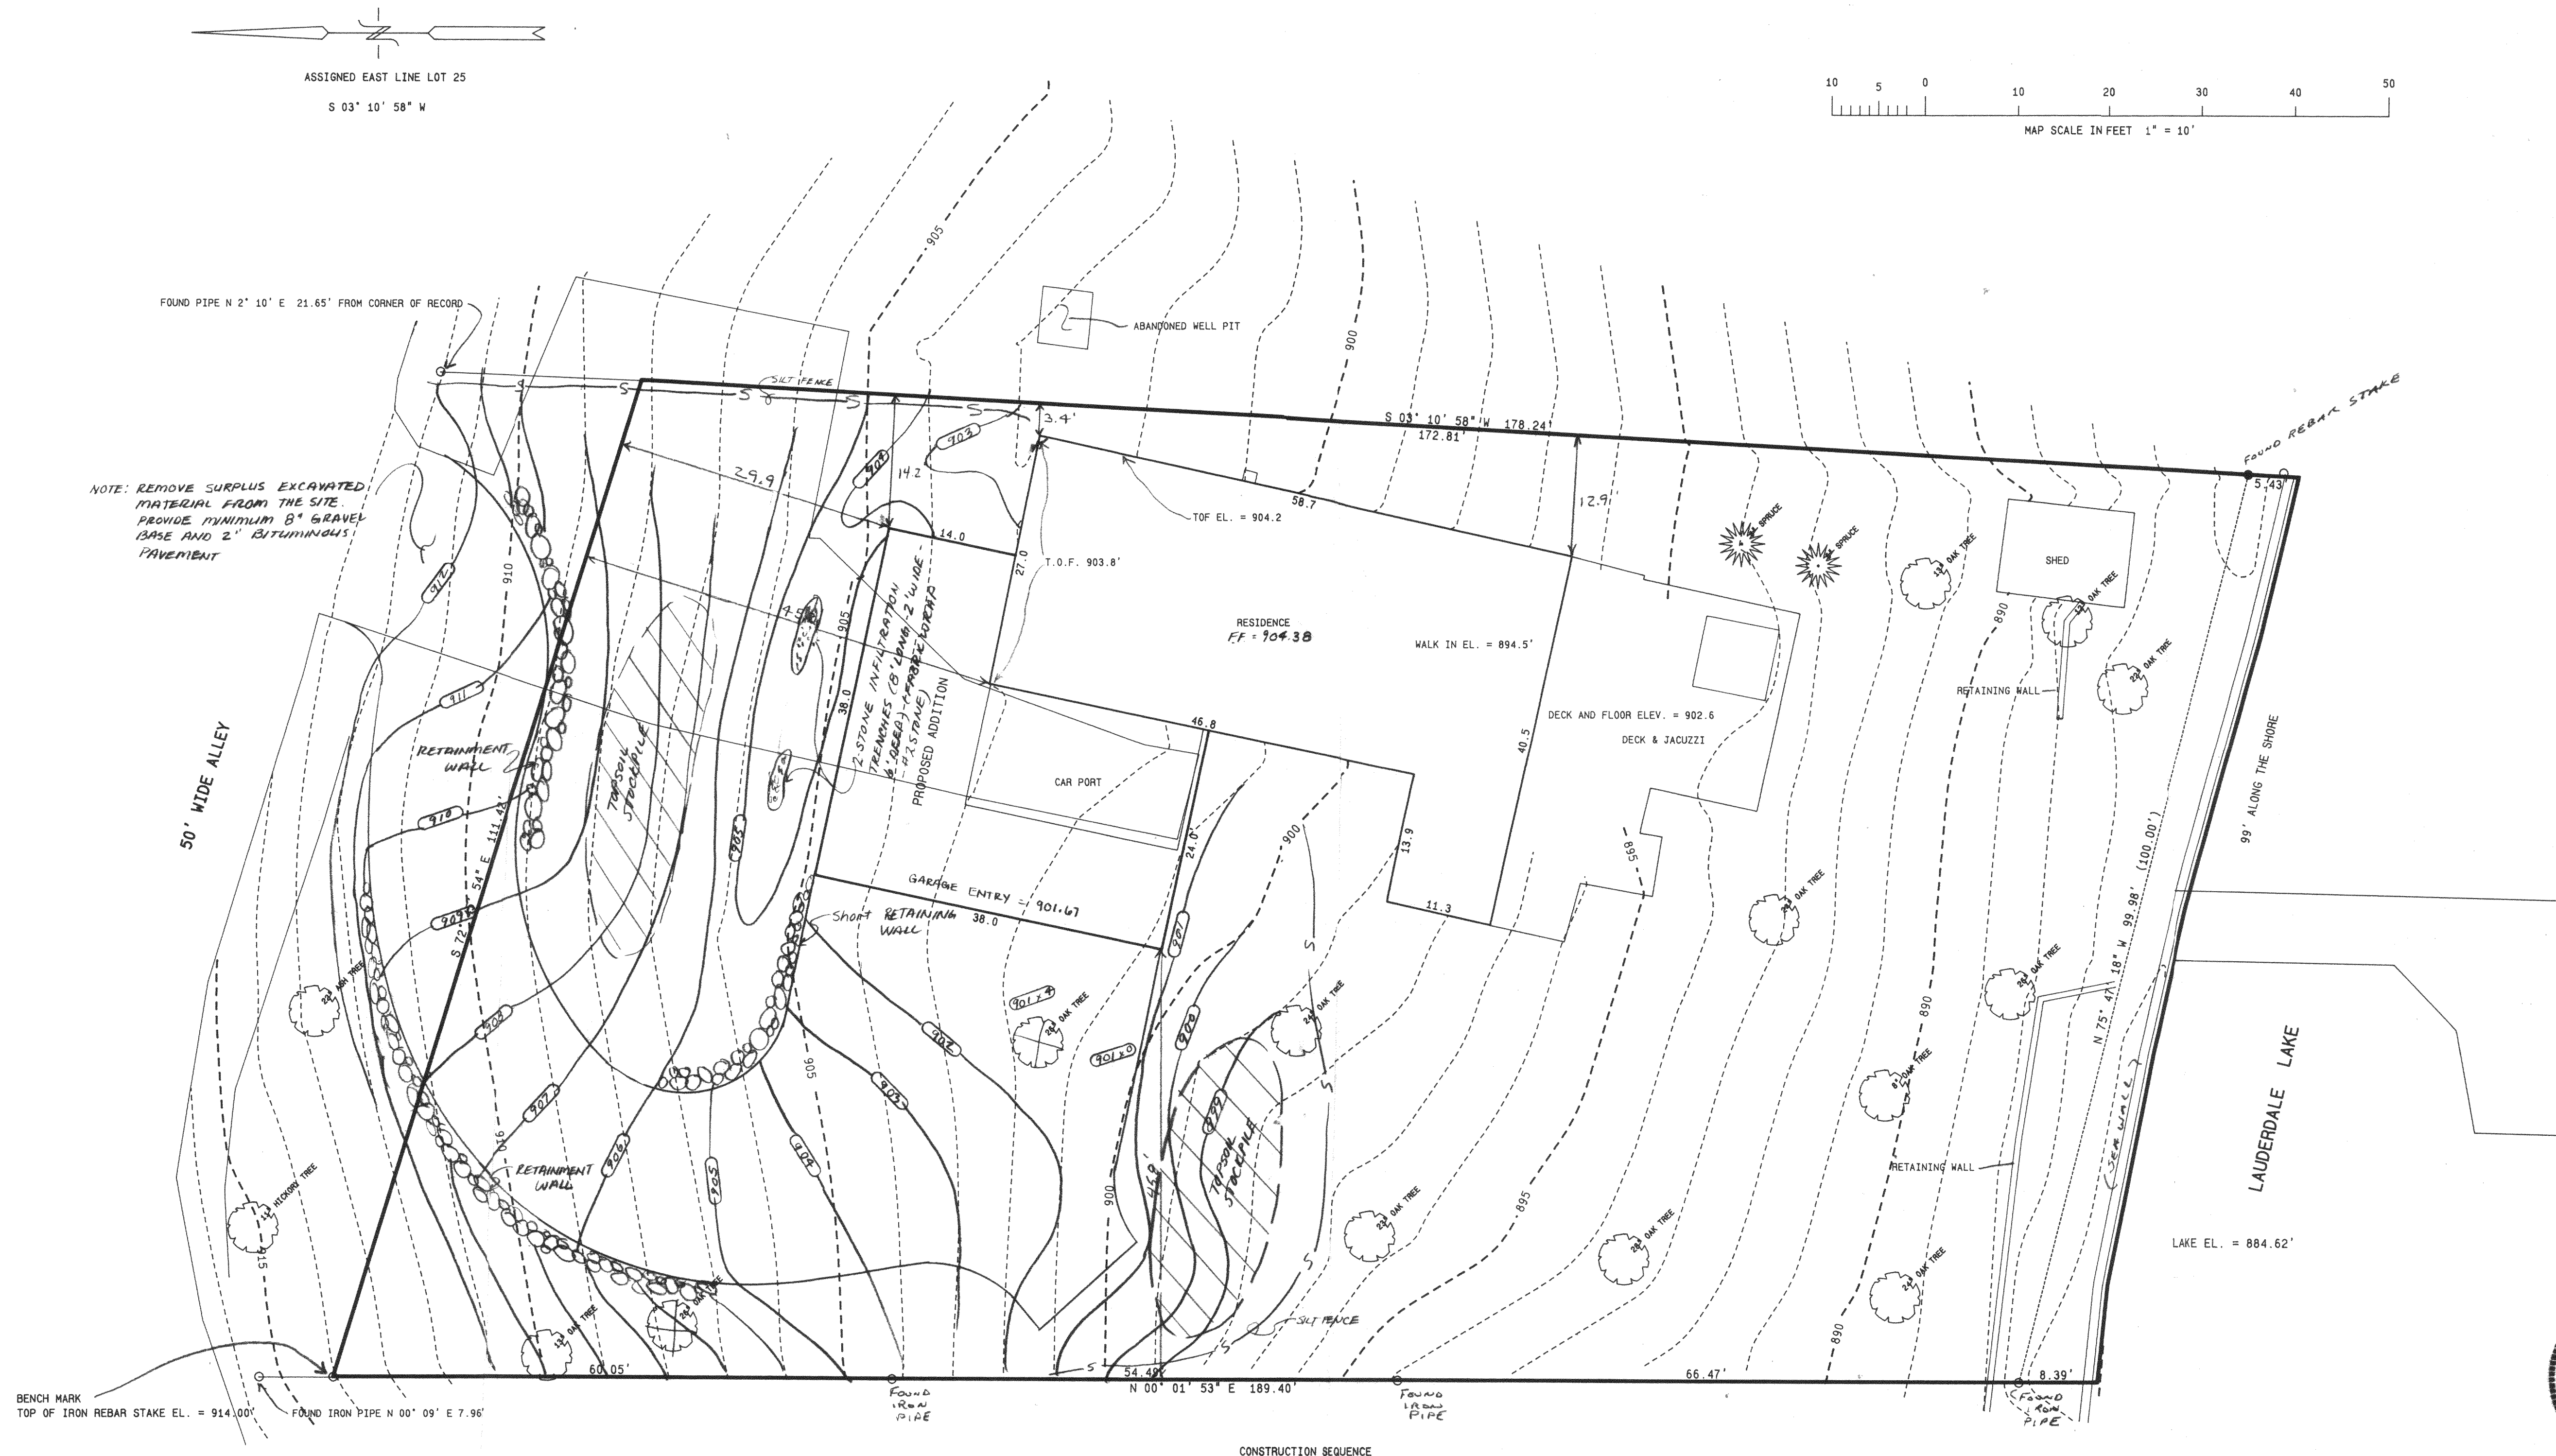

NOTE: ALL SILT FENCING AND BAILE CHECKS SHALL BE MAINTAINED IN A STABLE CONDITION FULLY BRACED AND STAKED TO PREVENT MOVEMENT BY RUNOFF UNTIL A DENSE TURF IS ESTABLISHED OVER ALL DISTURBED GROUND SURFACES. DURING OR AFTER EVERY STORM THEY SHALL BE CHECKED. ACCUMULATIONS OF SILT TOPSOIL AND ANY OTHER CONSTRUCTION DEBRIS SHALL BE ROUTINELY REMOVED.

- 1.) SILT FENCING & BAILE CHECKS INSTALLED.
- 2.) VEGETATION TO BE CLEARED.
- 3.) TOPSOIL STRIPPED.
- 4.) FOUNDATIONS DUG & POURED.
- 5.) WALLS BACKFILLED.
- 6.) SIDES TOPSOILED.
- 7.) FRAMING & HOME CONSTRUCTION COMPLETED.
- 8.) DRIVE & LANDSCAPING COMPLETED.

AREA TO BE RESTORED WITH TOPSOIL AS SOON AFTER FOUNDATION AND FRAMING AS POSSIBLE FOLLOWED WITH GRASS SEEDING AND MULCH.

NO LARGE TRIBUTARY DRAINAGE CROSSES THIS, ONLY LOCALIZED LOT DRAINAGE.

AREA WITHIN SILT FENCING TO BE CLEARED OF UNDERBRUSH WITH ONLY NECESSARY LARGE TREES REMOVED.


NO WETLAND OR FLOODPLAIN EXISTS ON THIS LOT.

NOTE: COPIES OF THIS MAP TO WHICH THE FOLLOWING CERTIFICATE WILL APPLY ARE BLUE LINE PRINTS SHOWING SURVEYOR'S ORIGINAL SEAL AND SIGNATURE IN BLACK INK. COPIES BY ANY OTHER MEANS MAY HAVE ALTERATIONS WHICH DO NOT REPRESENT THE SURVEYOR'S WORK PRODUCT.

I HEREBY CERTIFY THAT THIS MAP IS A TRUE REPRESENTATION OF THE PHYSICAL FEATURES OF THE SUBJECT PARCEL. THE BOUNDARY SURVEY IS A RETRACEMENT OF A PLAT OF SURVEY BY HAROLD H. KOLB, DATED APRIL 16, 1991. NO TITLE FOR BOUNDARY PURPOSES WAS PROVIDED.

DATED: 6-16-95

PETER S. GORDON
R.L.S. 2101

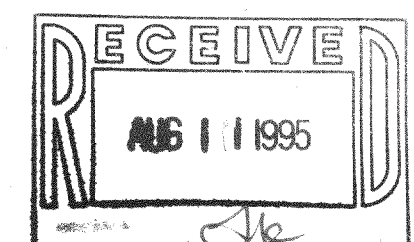

WORK ORDERED BY: GEORGE & KAREN BUENGER
8801 WEDGEWOOD DRIVE
BURR RIDGE, IL. 60521

FARRIS, HANSEN & ASSOCIATES, INC.
Engineering, Architecture, Surveying
7 Ridgeway Court, P.O. Box 437
ELKHORN, WISCONSIN 53121
Office: (414) 723-2096
Fax: (414) 723-5866

REVISIONS

PROJECT NO. 4311
DATE 06/16/95
SHEET NO. 1 OF 1