

ABERNATHY and ASSOCIATES

Kenneth B. Abernathy Jr.

Wisconsin Registered Land Surveyor S-1594

Rt. 3, Box 273
Elkhorn, Wisconsin 53121
Phone: (414) 723-4260 (office)
(414) 723-7209 (FAX)

PLAT OF SURVEY

LOT 26 OF DUNBAR ESTATES
SUBDIVISION, LOCATED IN
SECTION 36, TOWN 4 NORTH,
RANGE 16 EAST, TOWN OF
LAGRANGE, WALWORTH COUNTY,
WISCONSIN.

ORDERED BY: SCHAUDER BUILDERS, INC.
4115 US HWY 51 NORTH
JANESVILLE, WI. 53545

OWNER: JOHN & DORIS REYNHOUT
16213 JOYCE CIRCLE
SOUTH HOLLAND, ILL. 60473

NOTE:



WOOD STAKES HAVE BEEN PLACED AT BUILDING CORNERS. BUILDER IS TO
VERIFY DIMENSIONS WHICH HAVE BEEN ROUNDED TO THE NEAREST TENTH OF A
FOOT TO INSURE PROPER PLAN INTERPRETATION AND CONTACT THIS OFFICE
IMMEDIATELY IF ANY DISCREPANCY EXISTS.

PLEASANT LAKE ROAD

66' WIDE


N 89°41'05" E 235.00'

SET P.K. NAIL IN BLACKTOP DRIVEWAY

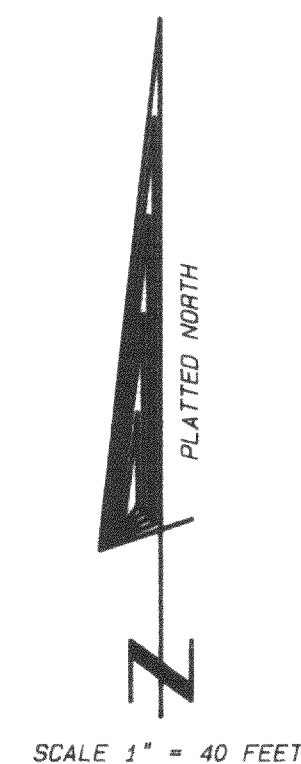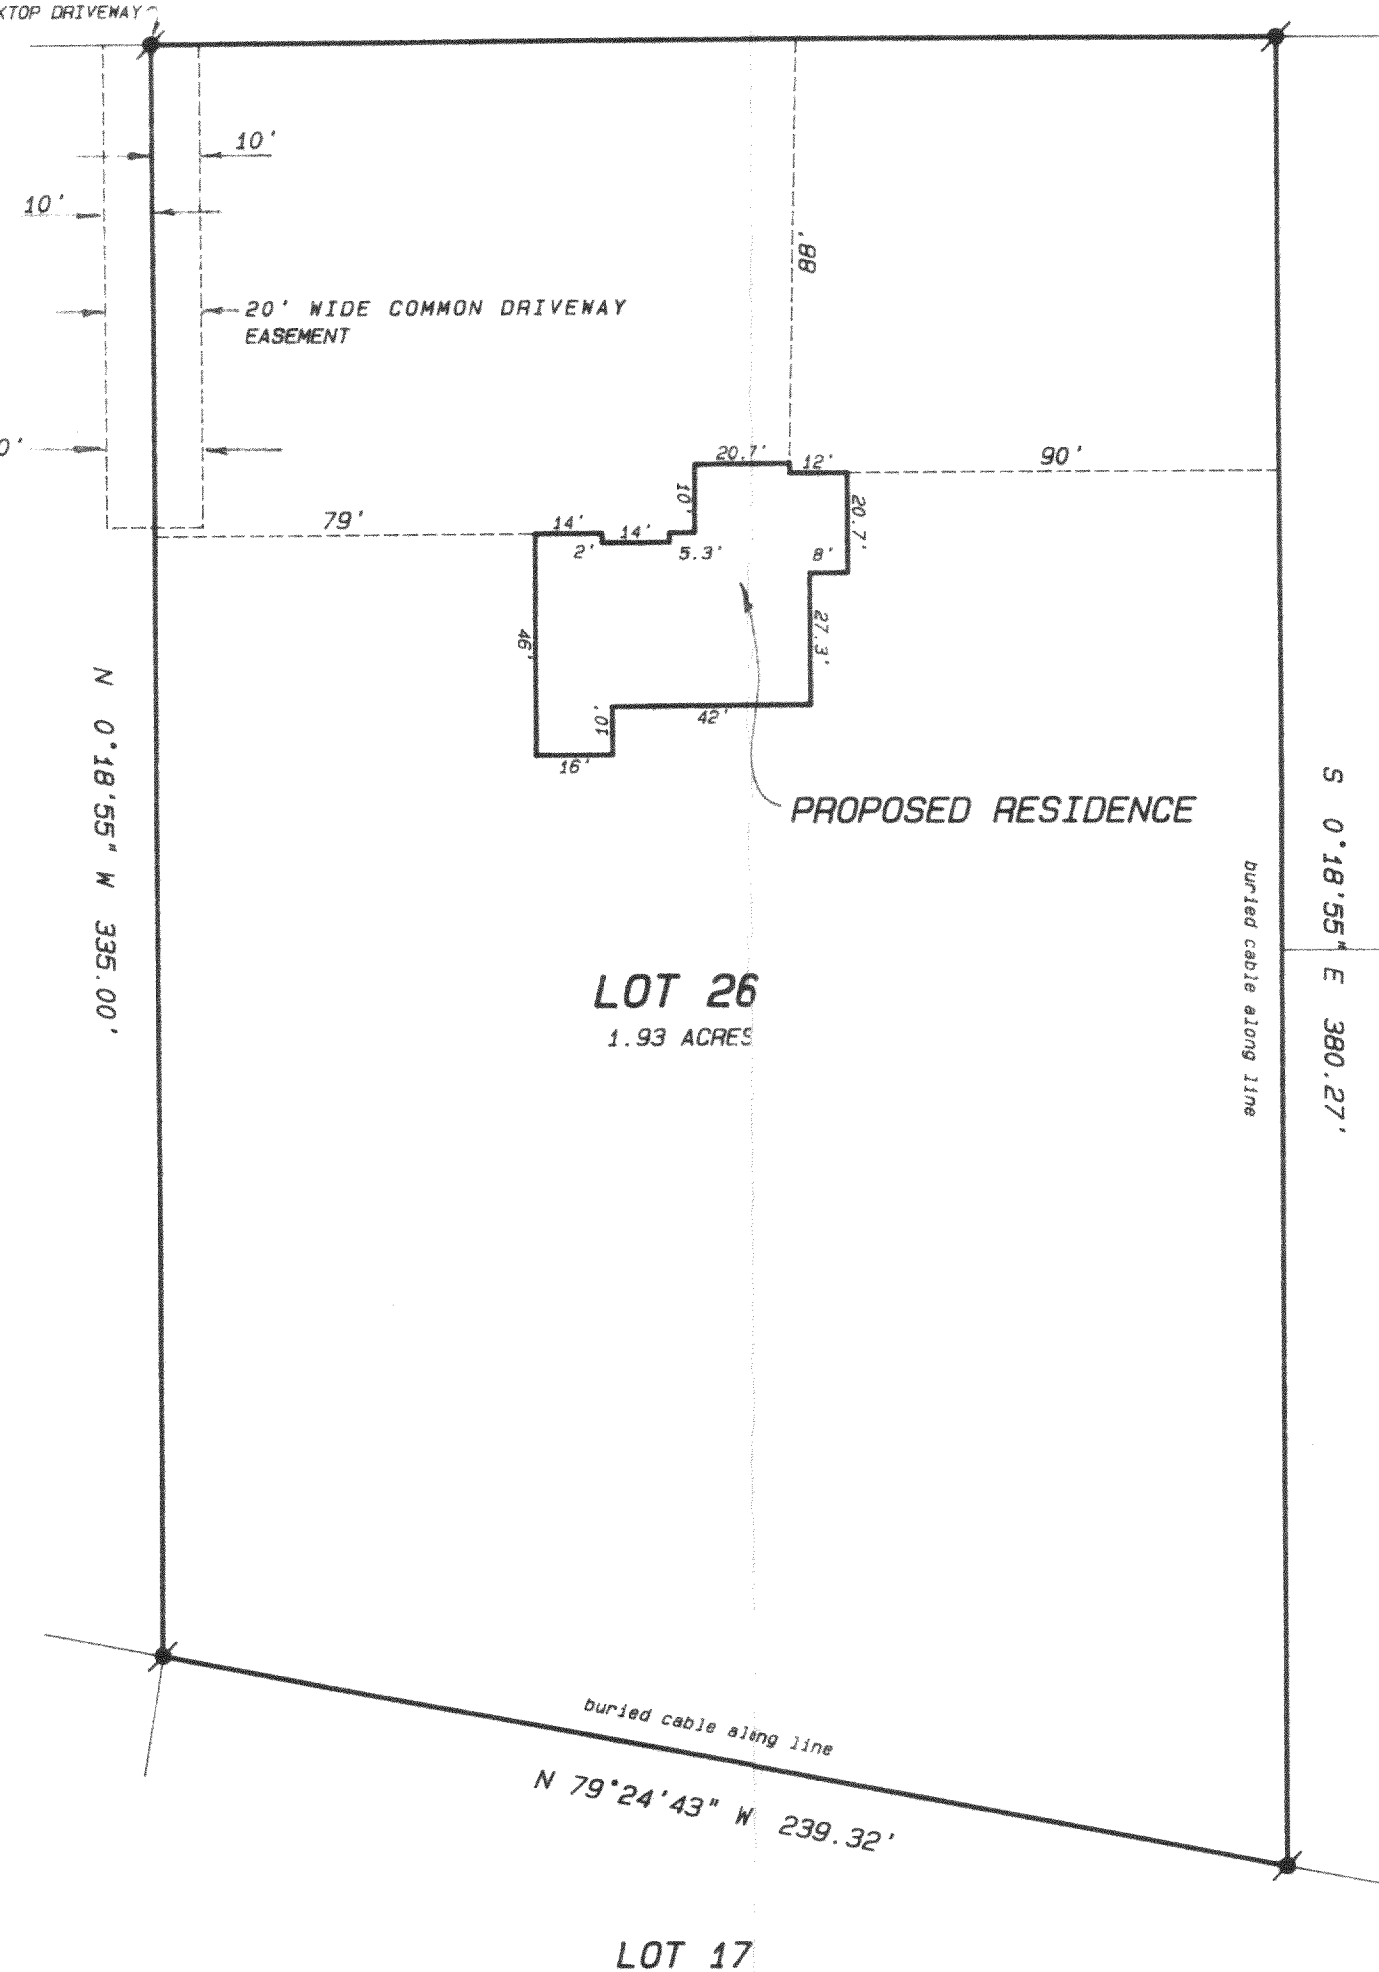


Legend

- FOUND IRON PIPE
- FOUND IRON ROD
- FOUND BRASS CAPPED MONUMENT
- FOUND CONCRETE MONUMENT
- + CHISEL CUT IN CONCRETE
- SET IRON ROD, 24" LONG, WEIGHING 1.5 LBS./LINEAL FT., 3/4" DIA.
- SET IRON ROD, 30" LONG, WEIGHING 4.5 LBS./LINEAL FT., 1-11/16" DIA.
- (xx) RECORDED AS DIMENSION
- X-X- EXISTING FENCE

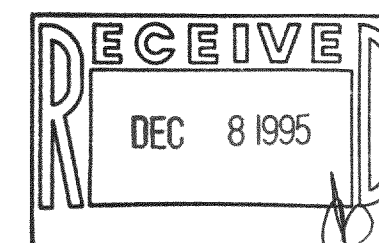

SCALE: 1" = 40 FEET

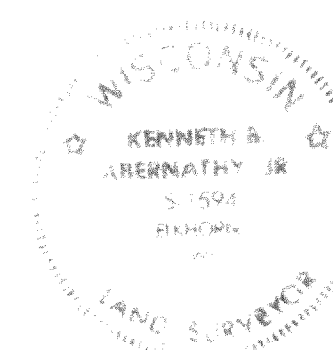

"I hereby certify that the above described property has been surveyed
by me or under my direction and that the above map is a true
representation thereof and shows the size and location of the property, its
exterior boundaries, the location of all visible structures and dimensions of
all principal buildings thereon, boundary fences, apparent easements,
roadways and visible encroachments, if any."

"This survey is made for the use of the present owners of the property,
and also those who purchase, mortgage, or guarantee the title thereto within
one year from date hereof."

KENNETH B. ABERNATHY, JR.
WISCONSIN REGISTERED LAND SURVEYOR,
S-1594

Date: 10/6/95 Job No. 95.918

ABERNATHY and ASSOCIATES

Kenneth B. Abernathy Jr.

Wisconsin Registered Land Surveyor S-1594



Rt. 3, Box 273
Elkhorn, Wisconsin 53121
Phone: (414) 723-4260 (office)
(414) 723-7209 (FAX)

PLAT OF SURVEY

LOT 26 OF DUNBAR ESTATES
SUBDIVISION, LOCATED IN
SECTION 36, TOWN 4 NORTH,
RANGE 16 EAST, TOWN OF
LAGRANGE, WALWORTH COUNTY,
WISCONSIN.


ORDERED BY: SCHAUDER BUILDERS, INC.
4115 US HWY 51 NORTH
JANESVILLE, WI. 53545

OWNER: JOHN & DORIS REYNHOUT
16213 JOYCE CIRCLE
SOUTH HOLLAND, ILL. 60473

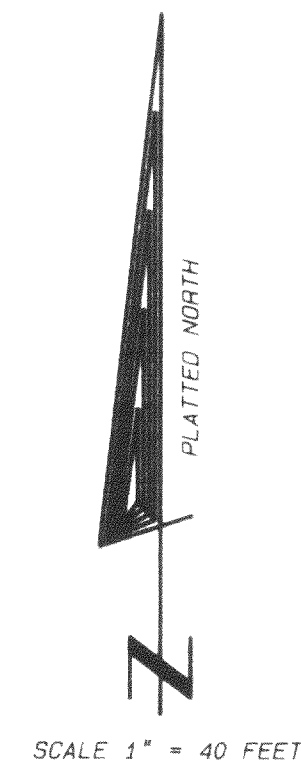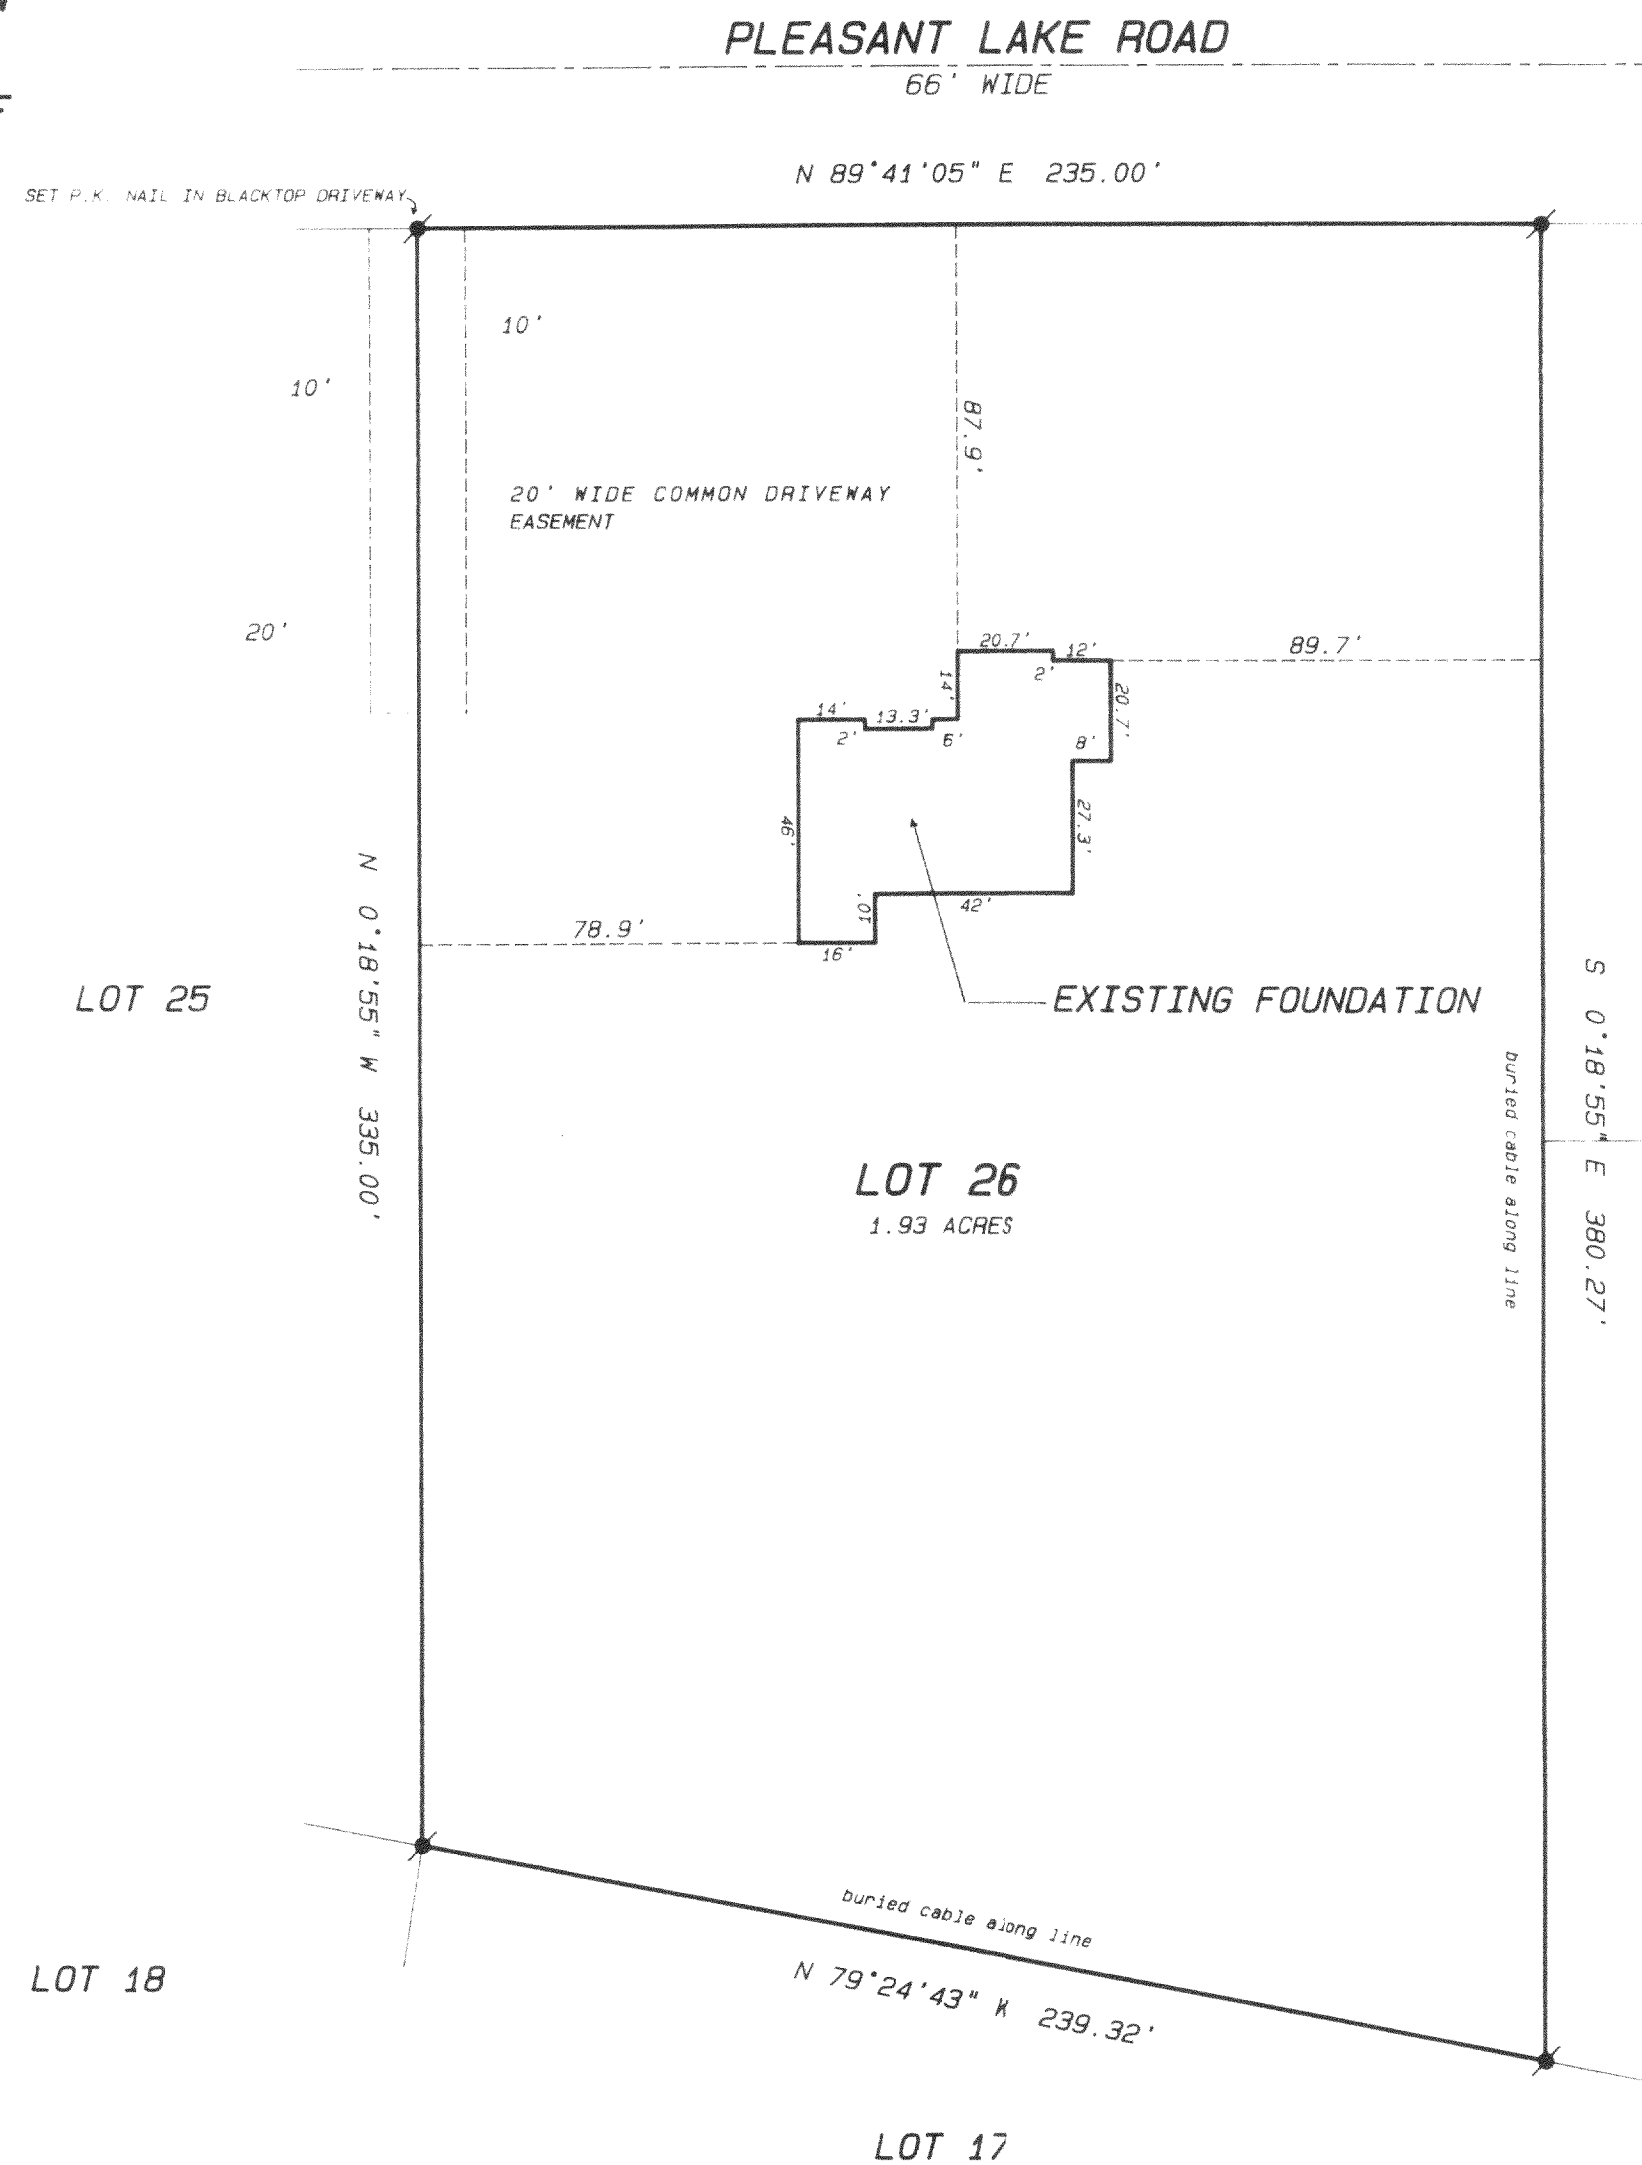

Legend

- FOUND IRON PIPE
- FOUND IRON ROD
- FOUND BRASS CAPPED MONUMENT
- ✱ FOUND CONCRETE MONUMENT
- ✱ CHISEL CUT IN CONCRETE
- SET IRON ROD, 24" LONG, WEIGHING 1.5 LBS., LINEAL FT., 3/4" DIA.
- SET IRON ROD, 30" LONG, WEIGHING 4.5 LBS., LINEAL FT., 1-11/16" DIA.
- (---) RECORDED AS DIMENSION
- - - - - EXISTING FENCE

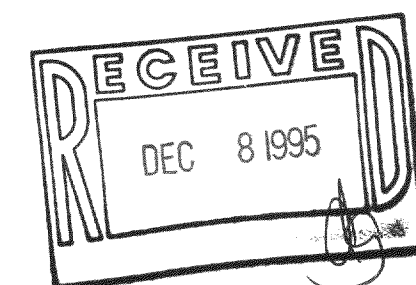

SCALE: 1" = 40 FEET



"I hereby certify that the above described property has been surveyed by me or under my direction and that the above map is a true representation thereof and shows the size and location of the property, its exterior boundaries, the location of all visible structures and dimensions of all principal buildings thereon, boundary fences, apparent easements, roadways and visible encroachments, if any.
This survey is made for the use of the present owners of the property and also those who purchase, mortgage or guarantee the title thereto within one year from date hereof."

Kenneth B. Abernathy, Jr.
KENNETH B. ABERNATHY, JR.
WISCONSIN REGISTERED LAND SURVEYOR,
S-1594

Date: NOVEMBER 20, 1995 Job No. 95-918AB

HDS-26

416-1179