


LEGEND

- ⊗ IRON STAKE - FOUND
- IRON STAKE - SET

I hereby certify that on the 21st day of August, 1967,
 that I have located the existing house shown above,
 and that the above plat is a correct representation of
 the exterior boundary lines thereof.

George B. Wilson
 George Bruce Wilson, Surveyor

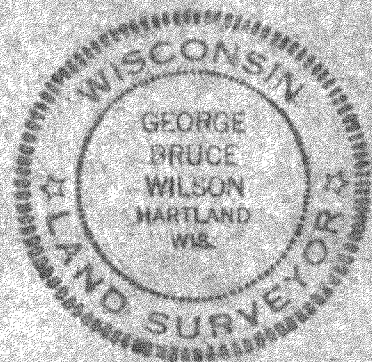

**PLAT OF SURVEY
 OF**

PART OF LOT 70 - 1ST ADDITION
 TO BUBBLING SPRINGS SUBDIVISION
 SE 1/4 SECTION 34, SECTION 35,
 T4N-R16E, WALWORTH
 COUNTY, WISCONSIN.

Lloyd L. Jensen
 SURVEYOR

SCALE 1" = 30'

DATE JULY 1966

BSI-39A

416-118.1