




"RECERTIFICATION"

Plat of Survey

Survey For: WOLTER BROS. BUILDERS
Location: FARM VILLAGE LANE

JACORY

Description: LOT 11 FARM VILLAGE SUBDIVISION, located in the S.F. 1/4 of the S.W. 1/4 and the S.W. 1/4 of the S.F. 1/4 and the S.F. 1/4 of the S.E. 1/4 of Section 25, Town 4 North, Range 16 East, Walworth County, Wisconsin.

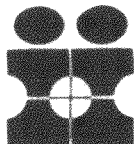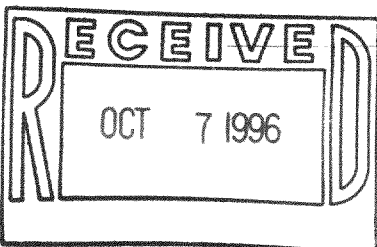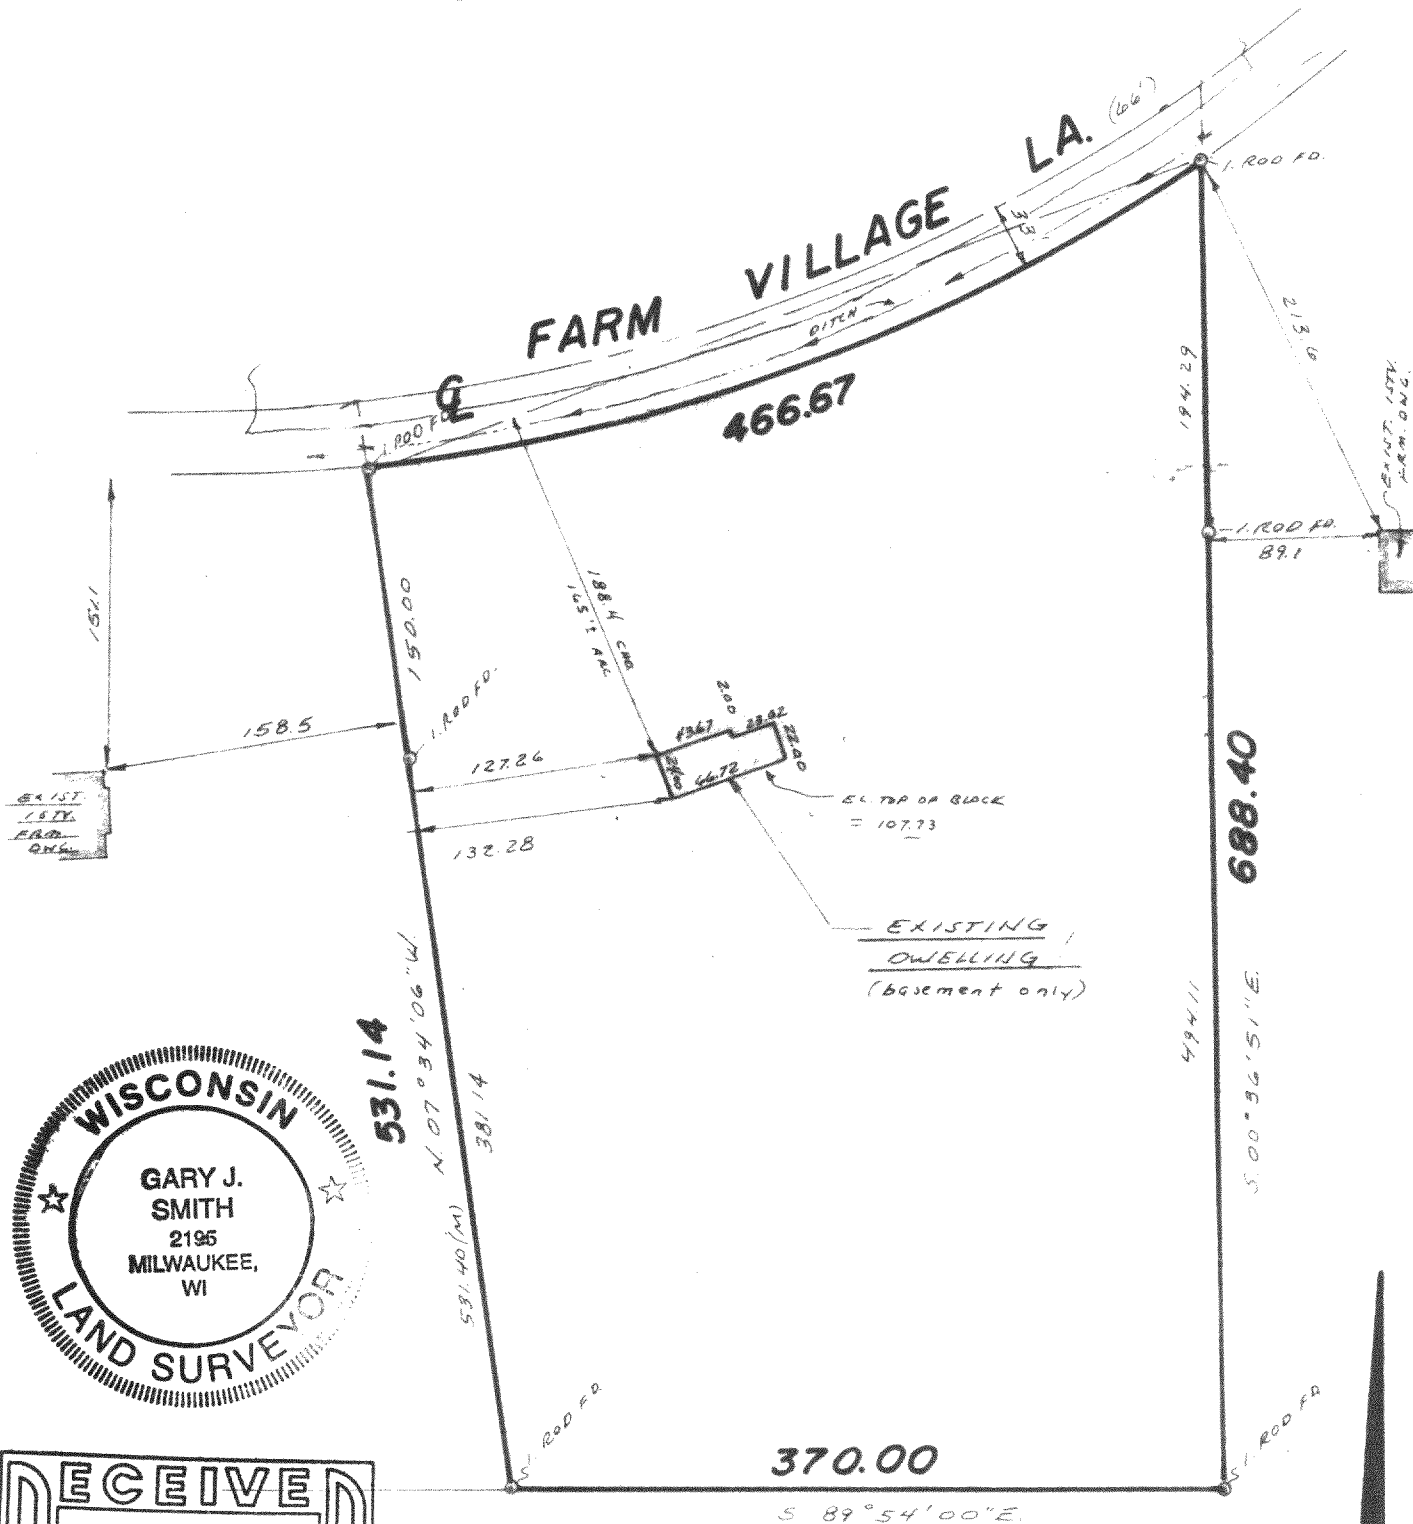

INTERLINE SURVEY
SERVICES, INC.
11221 W. FOREST HOME AVE
HALES CORNERS, WISCONSIN 53130
PHONE 425 2060

SURVEY CERTIFICATE

Scale: 1" = 100'

State of Wisconsin ss
Milwaukee County

We, Interline Survey Services, Inc., certify that we have surveyed the above described property and the above map is a true representation thereof, and shows the size and location of the property, its exterior boundaries, the location and dimensions of all visible structures thereon, fences, apparent easements and roadways and visible encroachments, if any.

This survey is made for the exclusive use of the present owners of the Property, and also those who purchase, mortgage, or guarantee the title thereto, within one (1) year from date hereof.

Gary J. Smith

Wisconsin Registered Land Surveyor


Date: 5/28/96
Job No.: 24631

PLAT OF SURVEY


-OF-

LOT 107, MARINER HILLS SUBDIVISION, located in the Northwest 1/4 of the Southwest 1/4, the Southwest 1/4 of the Southwest 1/4, the Southeast 1/4 of the Southwest 1/4 and the Southwest 1/4 of the Southeast 1/4 of Section 34, Township 4 North, Range 16 East in the Town of La Grange, Walworth County, Wisconsin.

Survey For: Hackbarth Builders


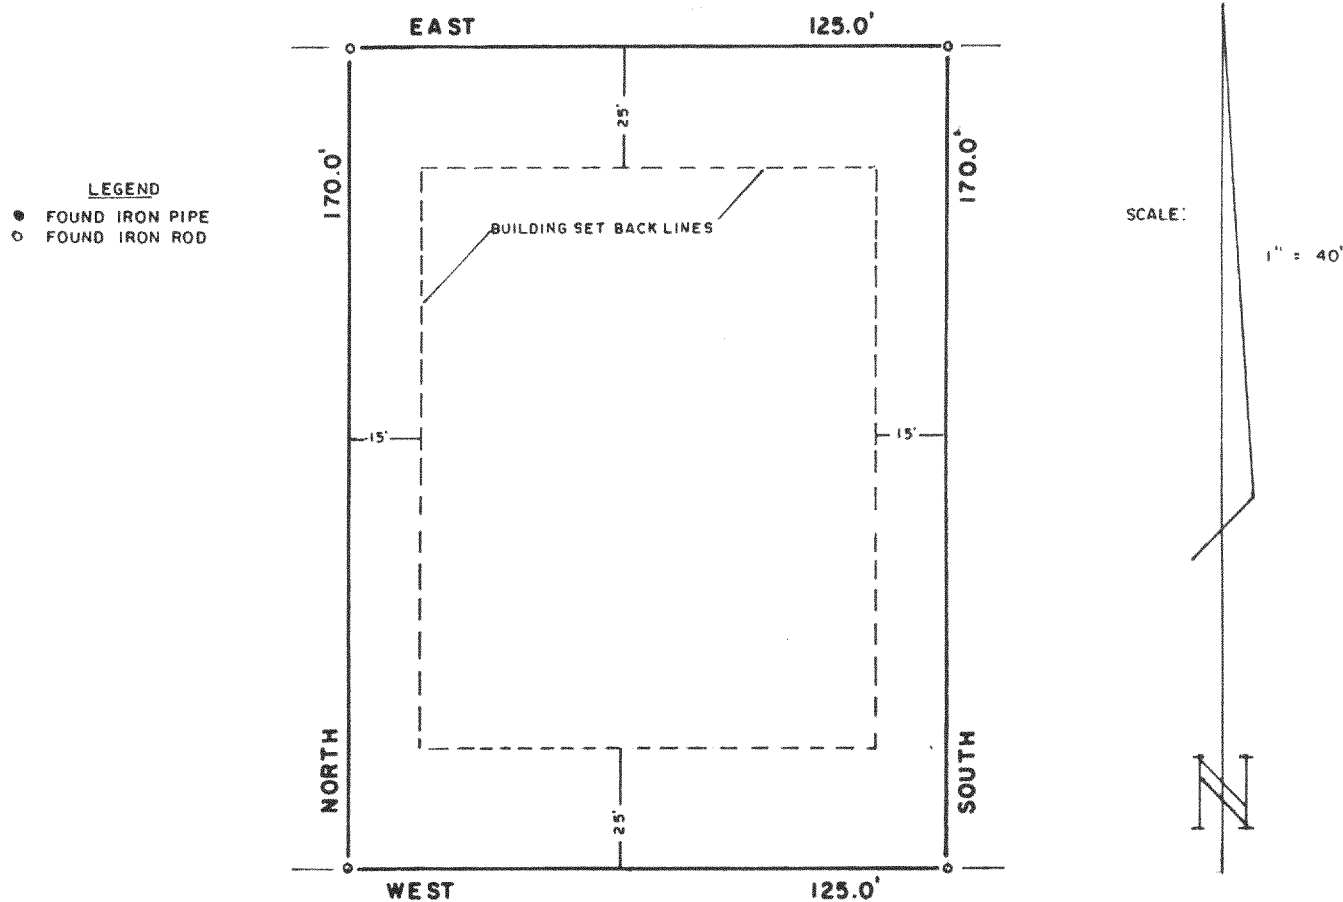


MARINER - HILLS TRAIL
(66' wide)

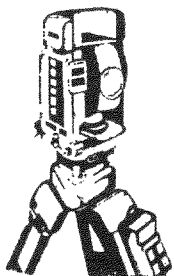

B.W. SURVEYING

Land Surveys
Mapping And Planning
425 Milwaukee Avenue
Burlington, WI 53105
(414) 767-0225

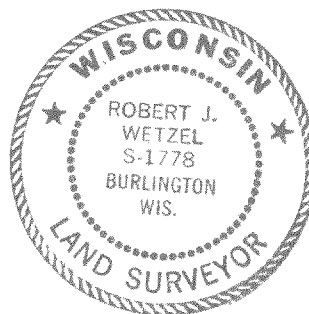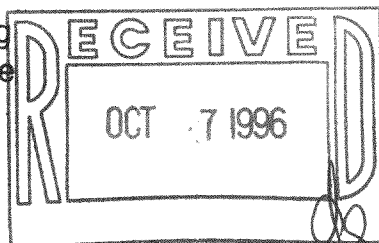

"I hereby certify that I have surveyed the above described property and that the above map is a true representation thereof and shows the size and location of the property, its exterior boundaries, the location of all visible structures and dimensions of all principal buildings thereon, boundary fences, apparent easements, roadways and encroachments, if any."

"This survey is made for the use of the present owners of the property, and those who purchase, mortgage, or guarantee the title thereto within one year from the date hereof."

THIS IS NOT AN ORIGINAL PRINT
UNLESS THIS SEAL IS RED

Robert J. Wetzel
ROBERT J. WETZEL
REGISTERED LAND SURVEYOR - 1778

3/18/96
DATE

2415 B
JOB NUMBER

HMH-107

416-1194