

ABERNATHY and ASSOCIATES

Kenneth B. Abernathy Jr.

Wisconsin Registered Land Surveyor S-1594

W4056 Bray Road
Elkhorn, Wisconsin 53121
Phone (414) 723-4260 (office)
(414) 723-4813 (residence)

PLAT OF SURVEY

Lot 71 of Mariner Hills
Subdivision, located in Section 34,
Town 4 North, Range 16 East, Town of
La Grange, County of Walworth, State
of Wisconsin.

Lot 72

(S 42°00'00" E 195.00')
S 42°02'41" E 194.78'

Utility Box

Septic Vent

Septic

Residence

Well

Utility Pedestals

N 42°01'39" W 227.75'
(N 42°00'00" W 228.00')

Lot 70


Bearing Basis this Plat
S 48°00'00" W 110.00'

66' Wide

Mariner Hills Circle

Legend

- FOUND IRON PIPE
- FOUND IRON ROD
- FOUND BRASS CLAPPED MONUMENT
- FOUND CONCRETE MONUMENT
- CHISEL CUT IN CONCRETE
- SET IRON ROD, 24" LONG, WEIGHING 1.5 LBS., LINEAL FT., 3/4" DIA.
- SET IRON ROD, 30" LONG, WEIGHING 4.5 LBS., LINEAL FT., 1 1/16" DIA.
- RECORDED AS DIMENSION
- EXISTING FENCE

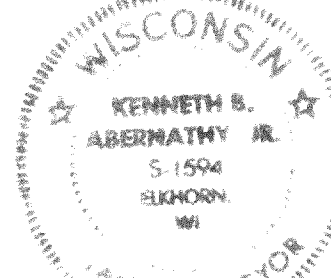


SCALE: 1"=10 FEET

I hereby certify that the above-described property has been surveyed by me or under my direction and that the above map is a true representation thereof and shows the size and location of the property, its exterior boundaries, the location of all visible structures and dimensions of all principal buildings thereon, boundary fences, adjacent easements, roadways and visible encroachments, if any.
This survey is made for the use of the present owners of the property, and also those who purchase, mortgage, or guarantee the title thereto within one year from date hereof.

Kenneth B. Abernathy, Jr.
KENNETH B. ABERNATHY, JR.
WISCONSIN REGISTERED LAND SURVEYOR,
S-1594

Date: July 1, 1993 Job No. 1993.616

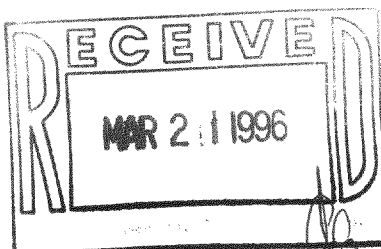

Ordered by: Carl Gustafson
Century 21
Wood Realty
704 North Lincoln Street
Elkhorn, Wisconsin 53121

HMH-71
416-1199