



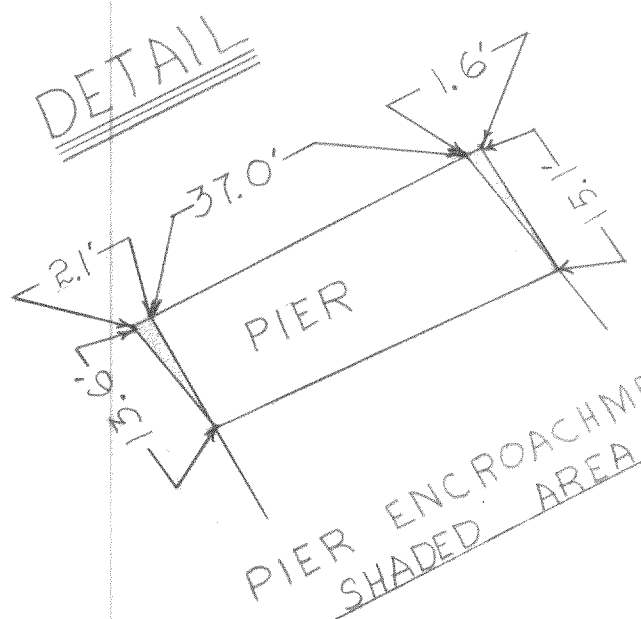

- LEGEND**
- IRON PIPE FOUND
 - IRON PIPE SET
 - EXCEPTED PARCEL
 - () RECORDED AS

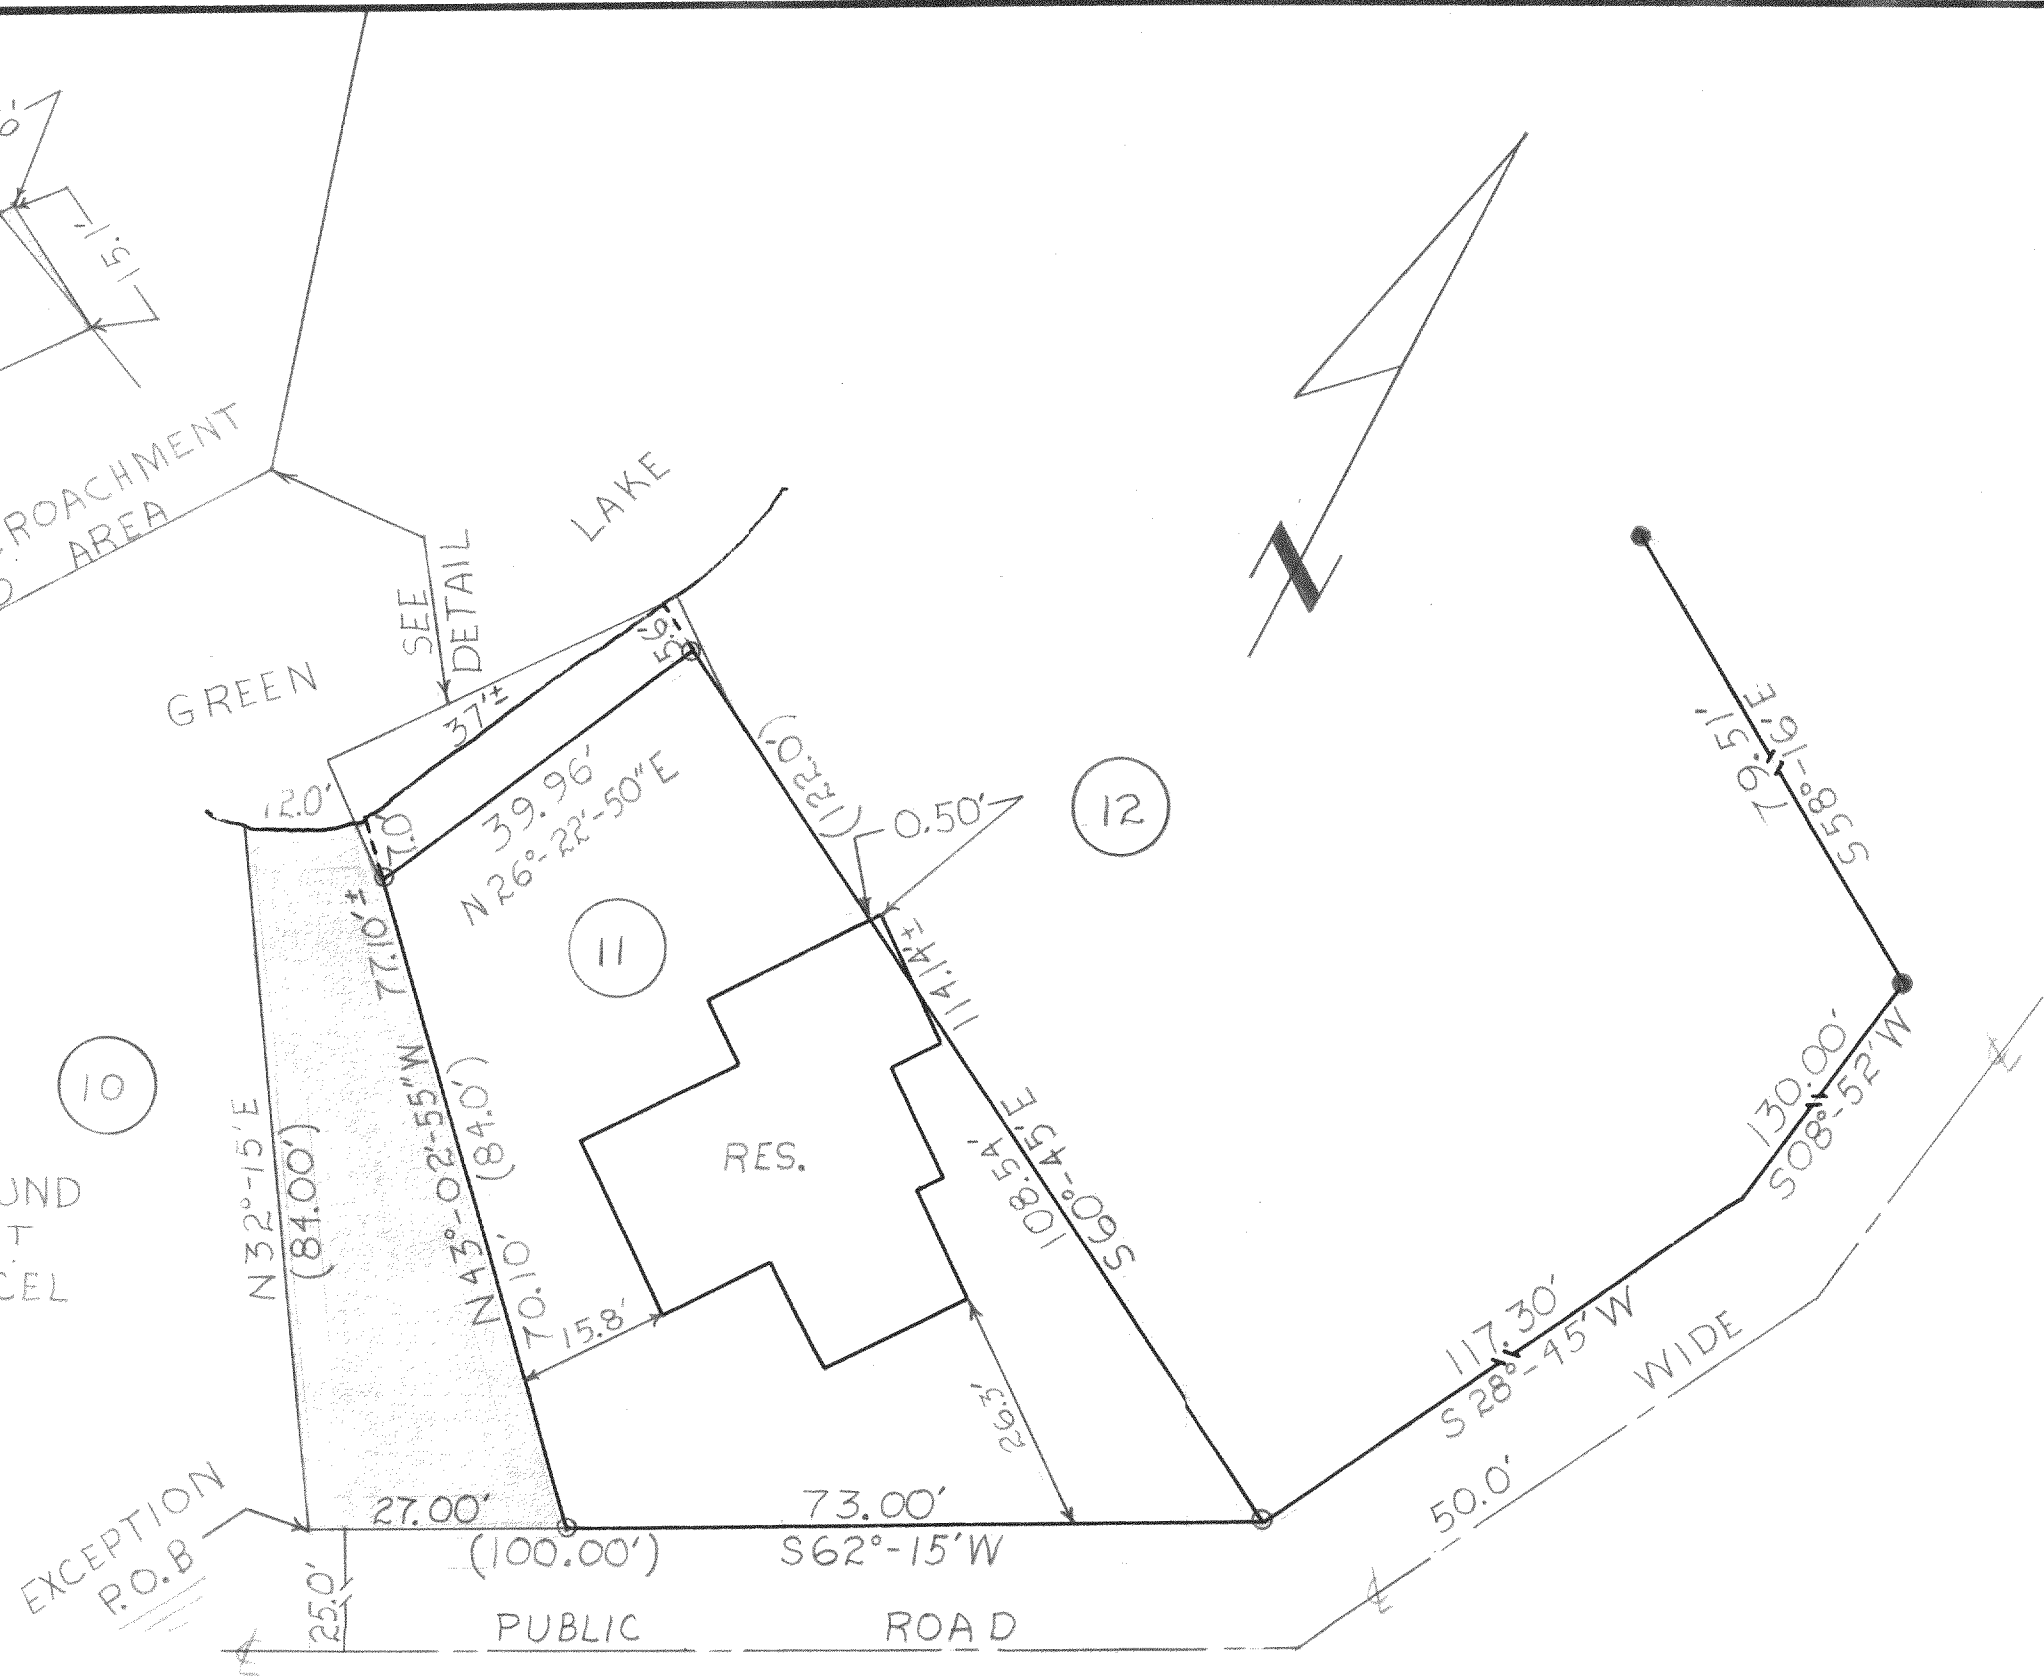


DESCRIPTION:
 ALL OF LOT 11, IN LA SELVA SUBDIVISION, WALWORTH COUNTY, WISCONSIN, EXCEPT THE FOLLOWING DESCRIBED PARCEL; COMMENCING AT THE SOUTHWEST CORNER OF SAID LOT 11, THENCE N 32°-15'E ALONG THE SOUTHWESTERLY LOT LINE OF SAID LOT 11, 84.0' FEET MORE OR LESS TO THE SHORE OF GREEN LAKE; THENCE NORTHEASTERLY ALONG THE SHORE OF GREEN LAKE 12.00' FEET; THENCE S 43°-02'-55"E, 77.10' FEET TO THE SOUTH LINE OF SAID LOT 11; THENCE S 62°-15'W ALONG THE SOUTH LINE OF LOT 11, 27.00' FEET TO THE PLACE OF BEGINNING.

DATE: SEPTEMBER 18 1975

CERTIFICATE:

I, JOSEPH M. BIAGI, SURVEYOR, DO HEREBY CERTIFY THAT I HAVE SUVEYED THE LANDS HEREON DESCRIBED.

Joseph M. Biagi
 JOSEPH M. BIAGI
 REC. # 12

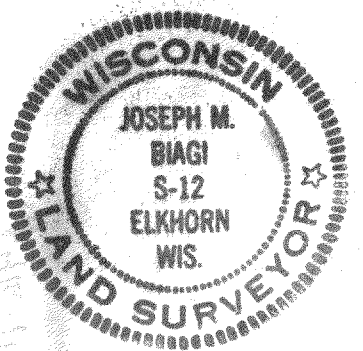

REVISIONS			DONALD VAN SCOTTER	
NO.	DATE	BY	LOT 11 LA SELVA SUB. WALWORTH COUNTY WIS.	
1				
2				
3			DRAWN BY H.WG	SCALE 1"= 20'
4			CHK'D	DATE 9-18-75
5			TRACED	APP'D
			DRAWING NO. # 93-75	