


# PLAT OF SURVEY

### LEGAL DESCRIPTION

LOTS 25 & 26 AND THE N'LY 20 FEET OF LOT 27, FROEDERT'S  
GREEN LAKE PARK SUBDIVISION, LOCATED IN SECTION 26,  
T4N, R16E, WALWORTH COUNTY, WISCONSIN

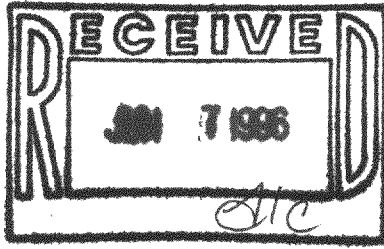


CLIENT: RUTH ALICE DOMINK

## SURVEYOR'S CERTIFICATE

I, JAMES K. LANGONE, REGISTERED LAND SURVEYOR, CERTIFY THAT I HAVE SURVEYED THE PROPERTY DESCRIBED, AND THAT THE PLAT SHOWN HEREON IS A CORRECT REPRESENTATION OF THE BOUNDARIES THEREOF.

DATE: 7/16/96

JAMES K. LANGONE  
REG. LAND SURVEYOR S-1347

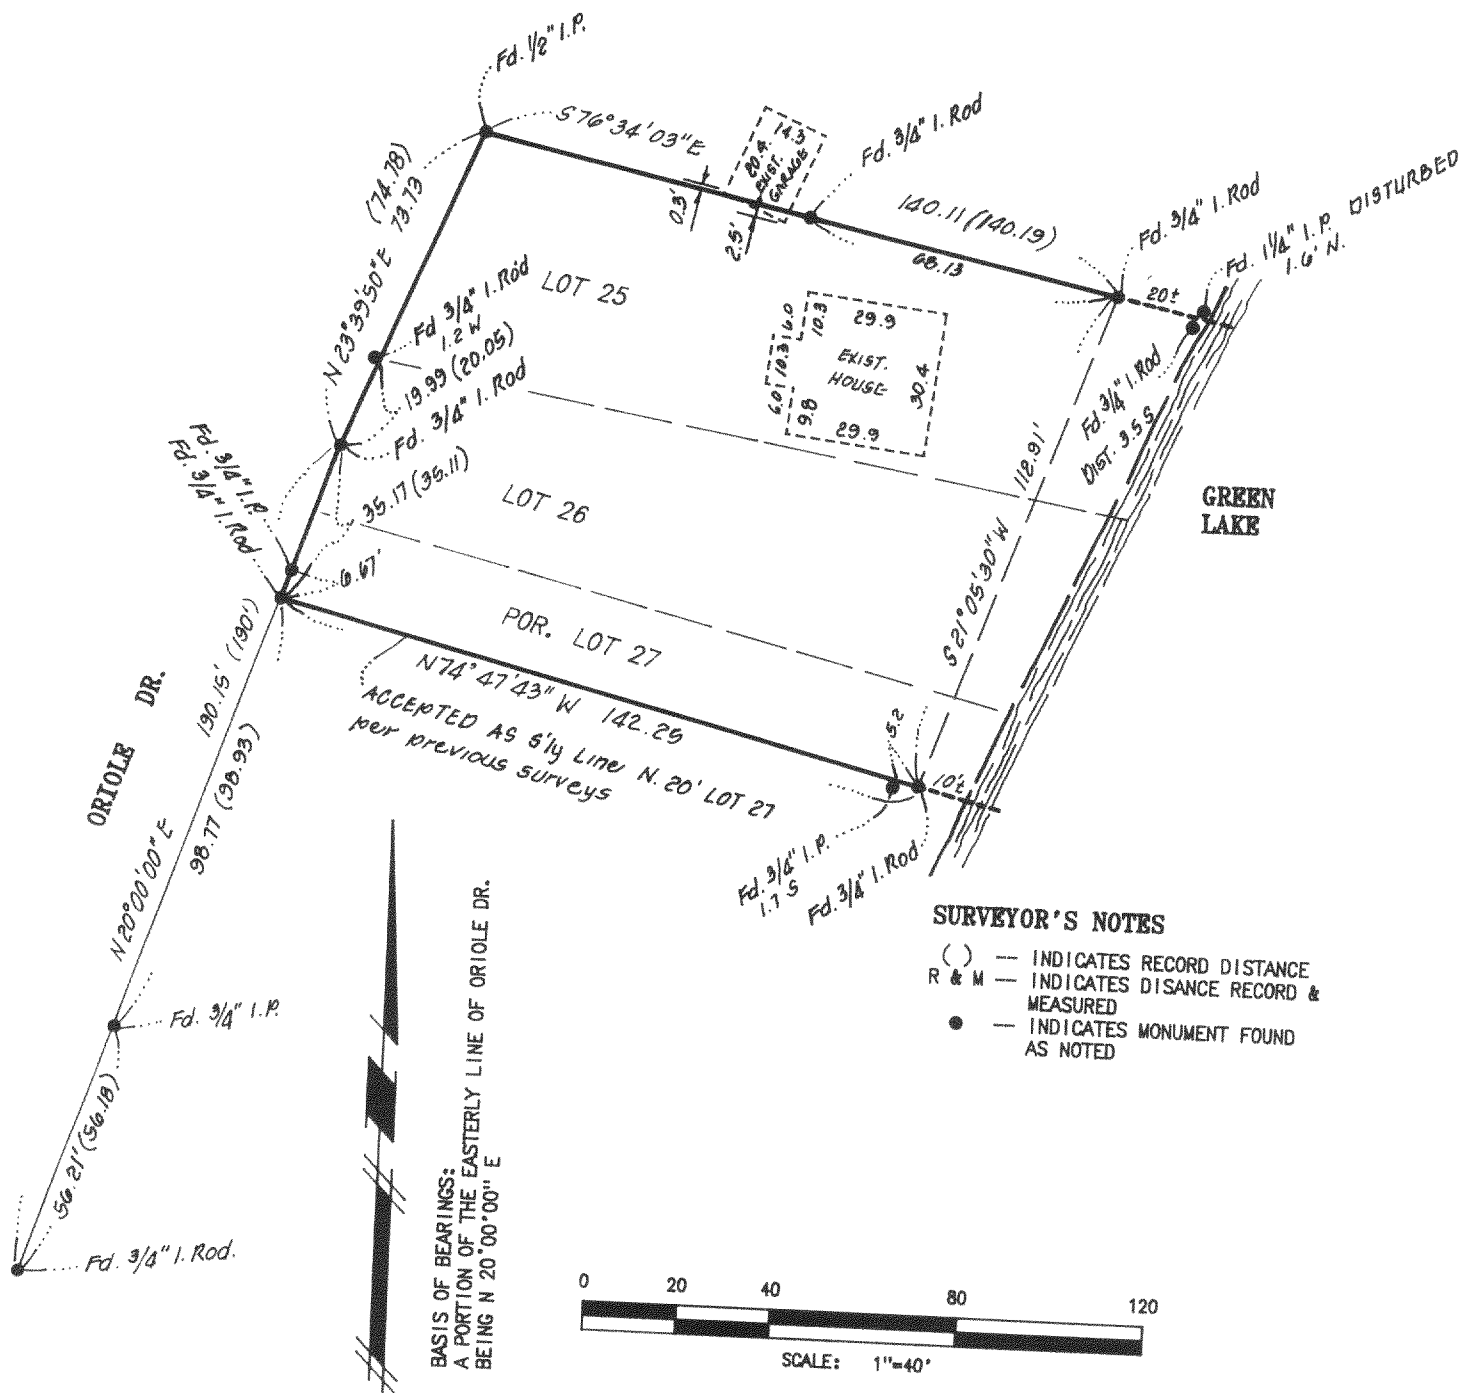

**SURVEYOR'S NOTES**

( ) --- INDICATES RECORD DISTANCE  
R & M --- INDICATES DISTANCE RECORD &  
MEASURED  
● --- INDICATES MONUMENT FOUND  
AS NOTED

HFP-17  
HFP-18

416-1216

**JAMES K. LANGONE**  
**LAND SURVEYS & CIVIL ENGINEERING**

N339 Co. Rd. "N" (Upper)

Whitewater, WI. 53190-2847

JN: 96-114

(414) 473-4119