

ABERNATHY and ASSOCIATES

Kenneth B. Abernathy Jr.

Wisconsin Registered Land Surveyor S-1594

Rt. 3, Box 273
Elkhorn, Wisconsin 53121
Phone: (414) 723-4260 (office)
(414) 723-7209 (FAX)



PLAT OF SURVEY

LOT 103 OF MARINER HILLS SUBD.

LOCATED IN SECTION 34, T.4 N., R.16 E.,
WALWORTH COUNTY, WISCONSIN.


OWNER: MIKE AND JEAN OLSON
W6051 MARINER HILLS
ELKHORN, WI. 53121

NOTE: THIS SURVEY WAS ORIGINALLY PREPARED ON JULY
4, 1990 AND IS ON RECORD WITH THE WALWORTH COUNTY
SURVEYOR'S OFFICE AS PROJECT NO. 90.612. IT HAS
BEEN REVISED ON OCT. 21, 1996 TO SHOW A PROPOSED
ADDITION, AN EXISTING GARAGE AND AN EXISTING
GAZEBO.

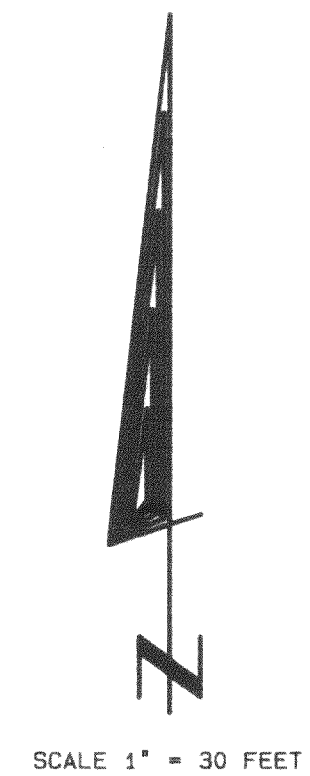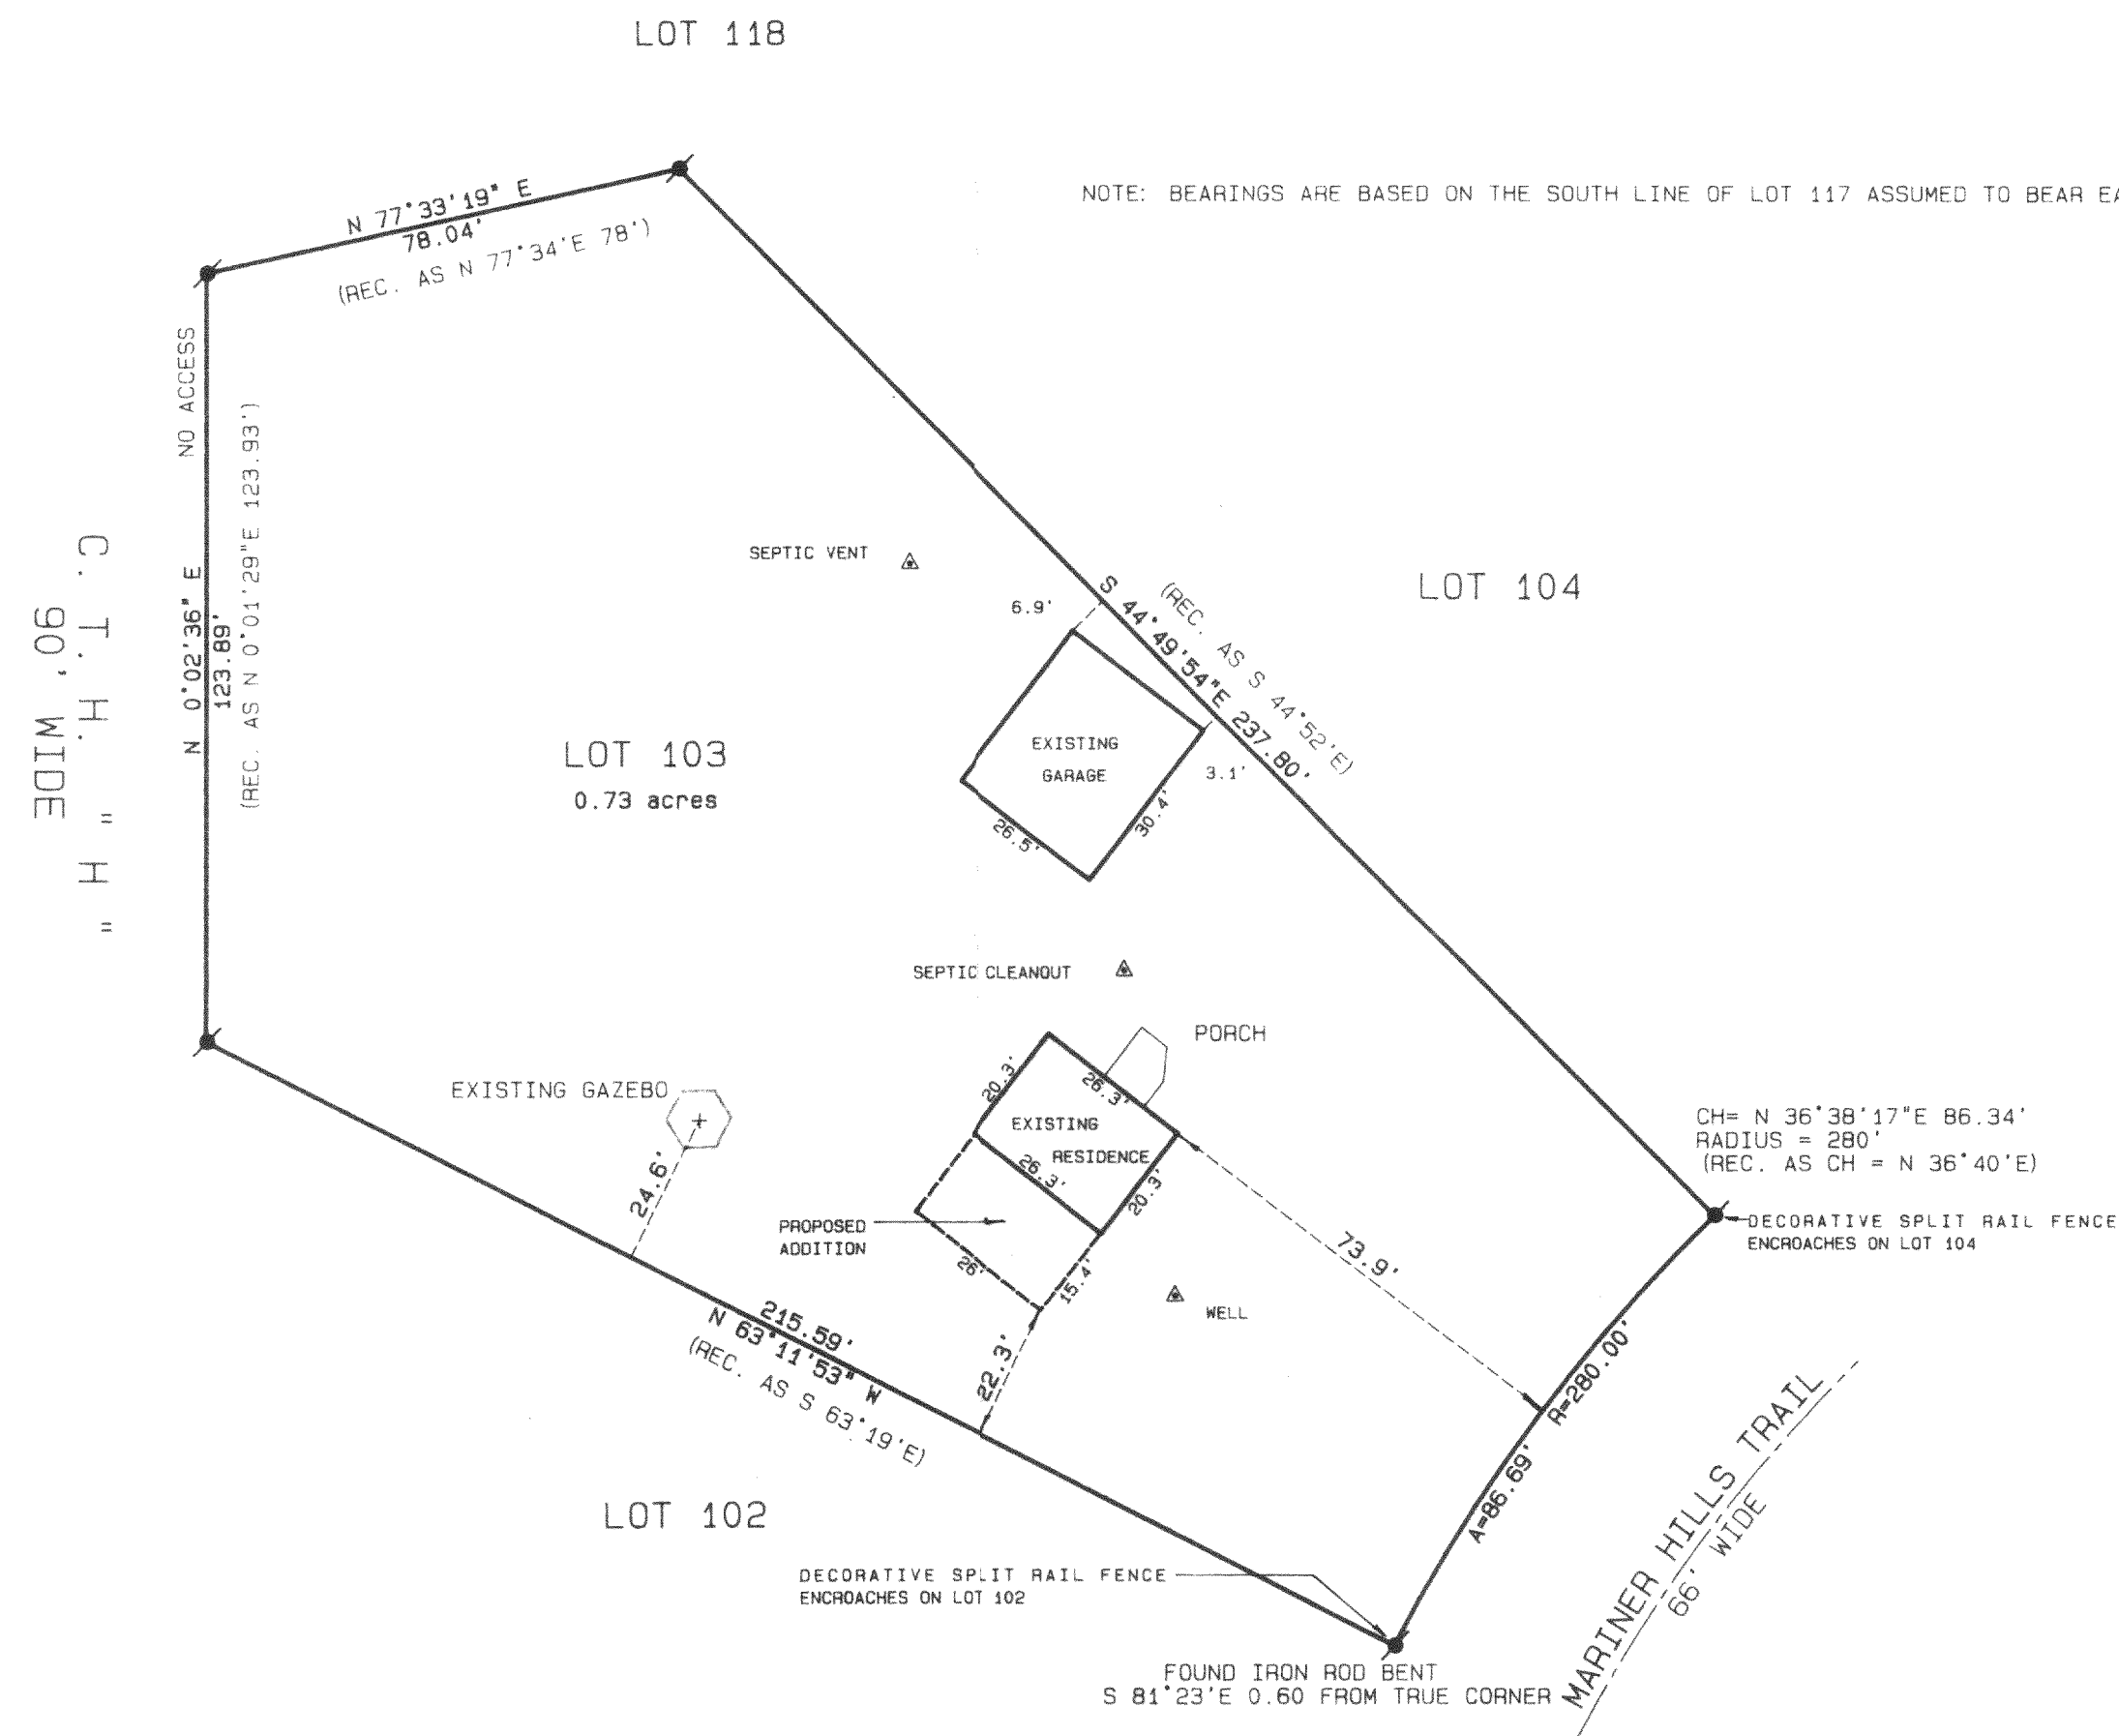

Legend

- FOUND IRON PIPE
- FOUND IRON ROD
- FOUND BRASS CAPPED MONUMENT
- FOUND CONCRETE MONUMENT
- CHISEL CUT IN CONCRETE
- SET IRON ROD, 24" LONG, WEIGHING 1.5 LBS./LINEAL FT., 3/4" DIA.
- SET IRON ROD, 30" LONG, WEIGHING 4.5 LBS./LINEAL FT., 1-11/16" DIA.
- RECORDED AS DIMENSION
- EXISTING FENCE

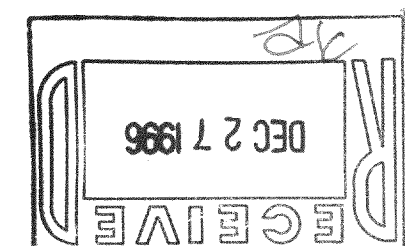

SCALE: 1" = 30 FEET

"I hereby certify that the above described property has been surveyed
by me or under my direction and that the above map is a true
representation thereof and shows the size and location of the property, its
exterior boundaries, the location of all visible structures and dimensions of
all principal buildings thereon, boundary fences, apparent easements,
roadways and visible encroachments, if any."
"This survey is made for the use of the present owners of the property,
and also those who purchase, mortgage, or guarantee the title thereto within
one year from date hereof."

Kenneth B. Abernathy, Jr.
Kenneth B. Abernathy, Jr.
WISCONSIN REGISTERED LAND SURVEYOR,
S-1594
Date: Oct. 21, 1996 Job No. 96.1003



HMH-103

416-1232