


PLAT OF SURVEY

LOT 1 OF CERTIFIED SURVEY MAP NO. 1545 AS RECORDED
IN VOL. 7 OF CERTIFIED SURVEY MAPS AS PAGES 172
AND 173 AS DOCUMENT NO. 137687, BEING LOCATED IN
THE SOUTHWEST 1/4 AND THE SOUTHEAST 1/4 OF THE
NORTHWEST 1/4 OF SECTION 11, TOWN 4 NORTH, RANGE
16 EAST, WALWORTH COUNTY, WISCONSIN.

OWNERS: CLEM AND ANGELA MEAS

SUBJECT PROPERTY ADDRESS: W5621 TAMARACK TRAIL
WHITEWATER, WI. 53190

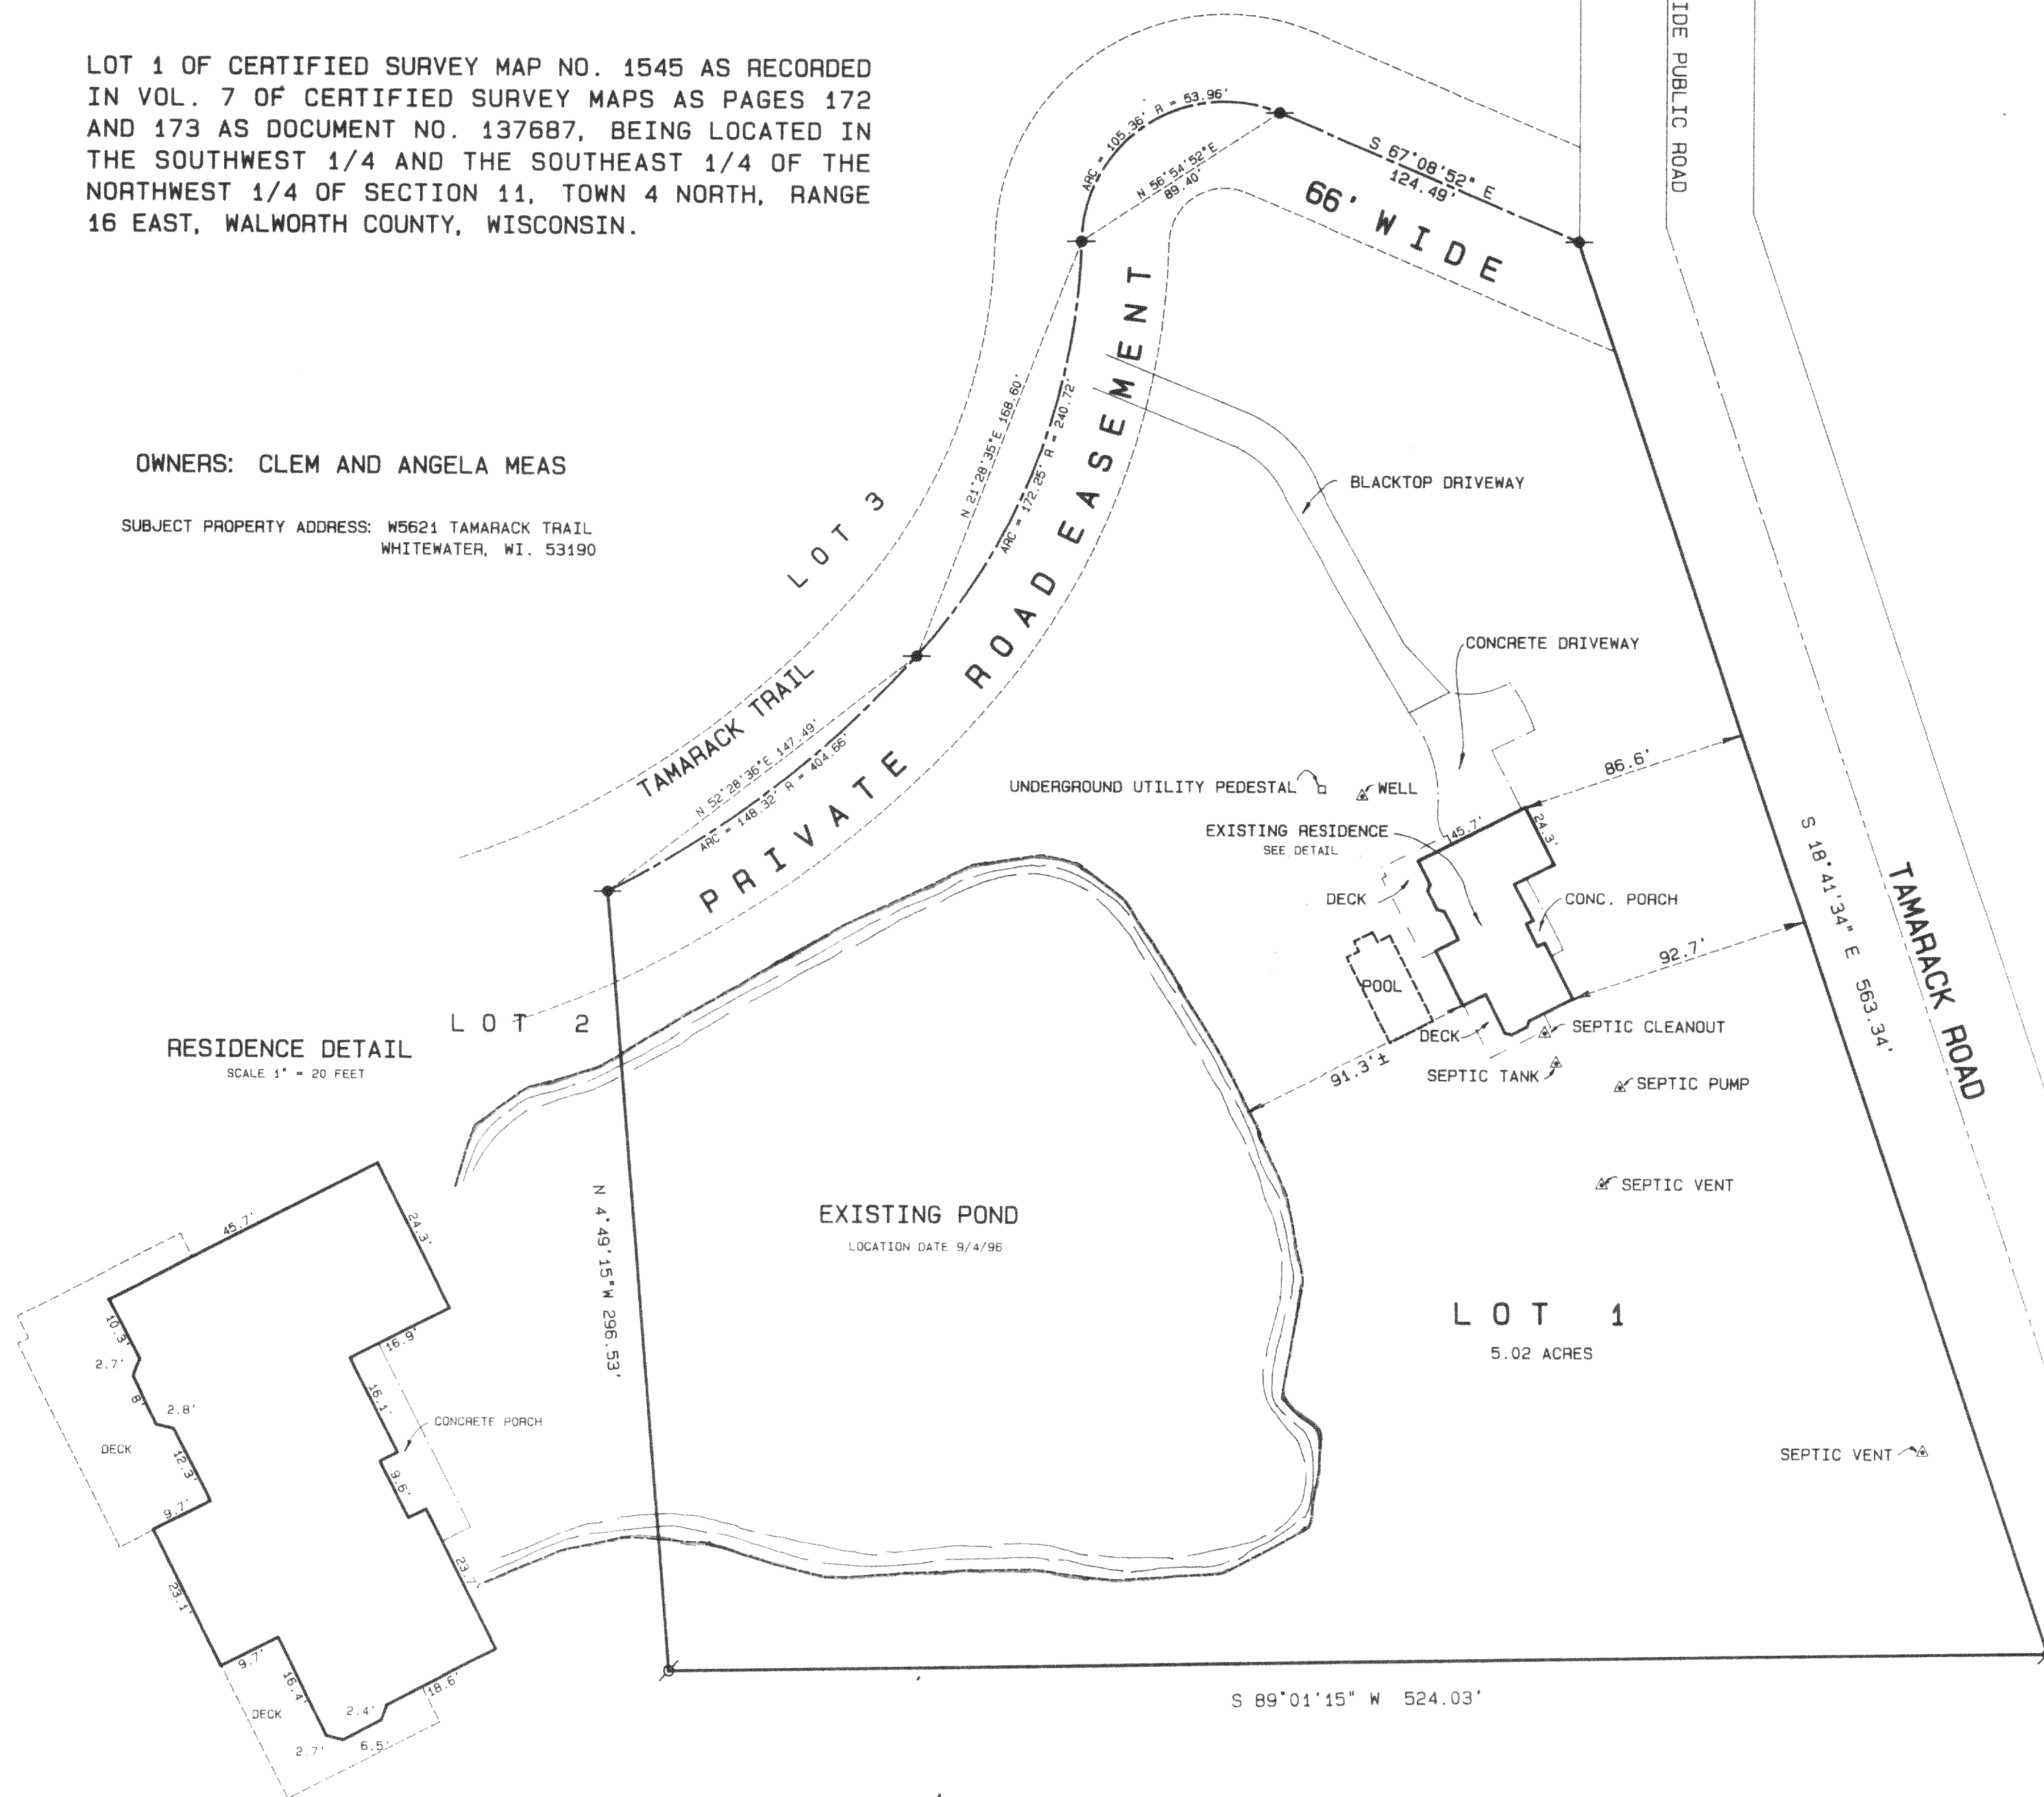


SCALE 1" = 50 FEET

BEARINGS ARE BASED ON CERTIFIED
SURVEY MAP NO. 1545


Legend

- FOUND IRON PIPE
 - FOUND IRON ROD
 - FOUND BRASS CAPPED MONUMENT
 - ✕ FOUND CONCRETE MONUMENT
 - + CHISEL CUT IN CONCRETE
 - SET IRON ROD, 24" LONG, WEIGHING 1.5 LBS./LINEAL FT., 3/4" DIA.
 - SET IRON ROD, 30" LONG, WEIGHING 4.5 LBS./LINEAL FT., 1-11/16" DIA.
- (XX) RECORDED AS DIMENSION
- EXISTING FENCE

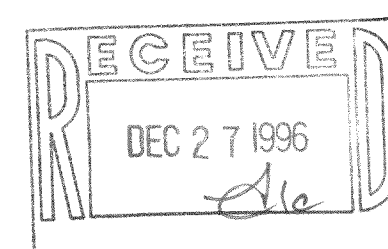

SCALE: 1" = 50 FEET

This survey is made for the use of the present owners of the property, and these owners and their heirs, assigns, or mortgage, or guarantee the title thereto within fifteen (15) calendar years.

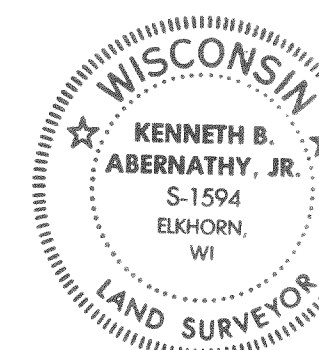

KENNETH B. ABERNATHY, JR.
WISCONSIN REGISTERED LAND SURVEYOR,
S-1594
Date: SEPT. 4, 1996 Job No. 96.816

HA-1545-

416-1234