
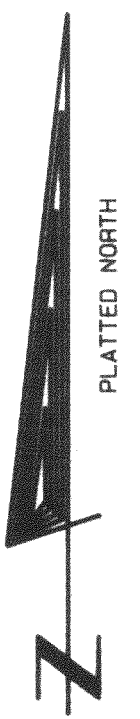
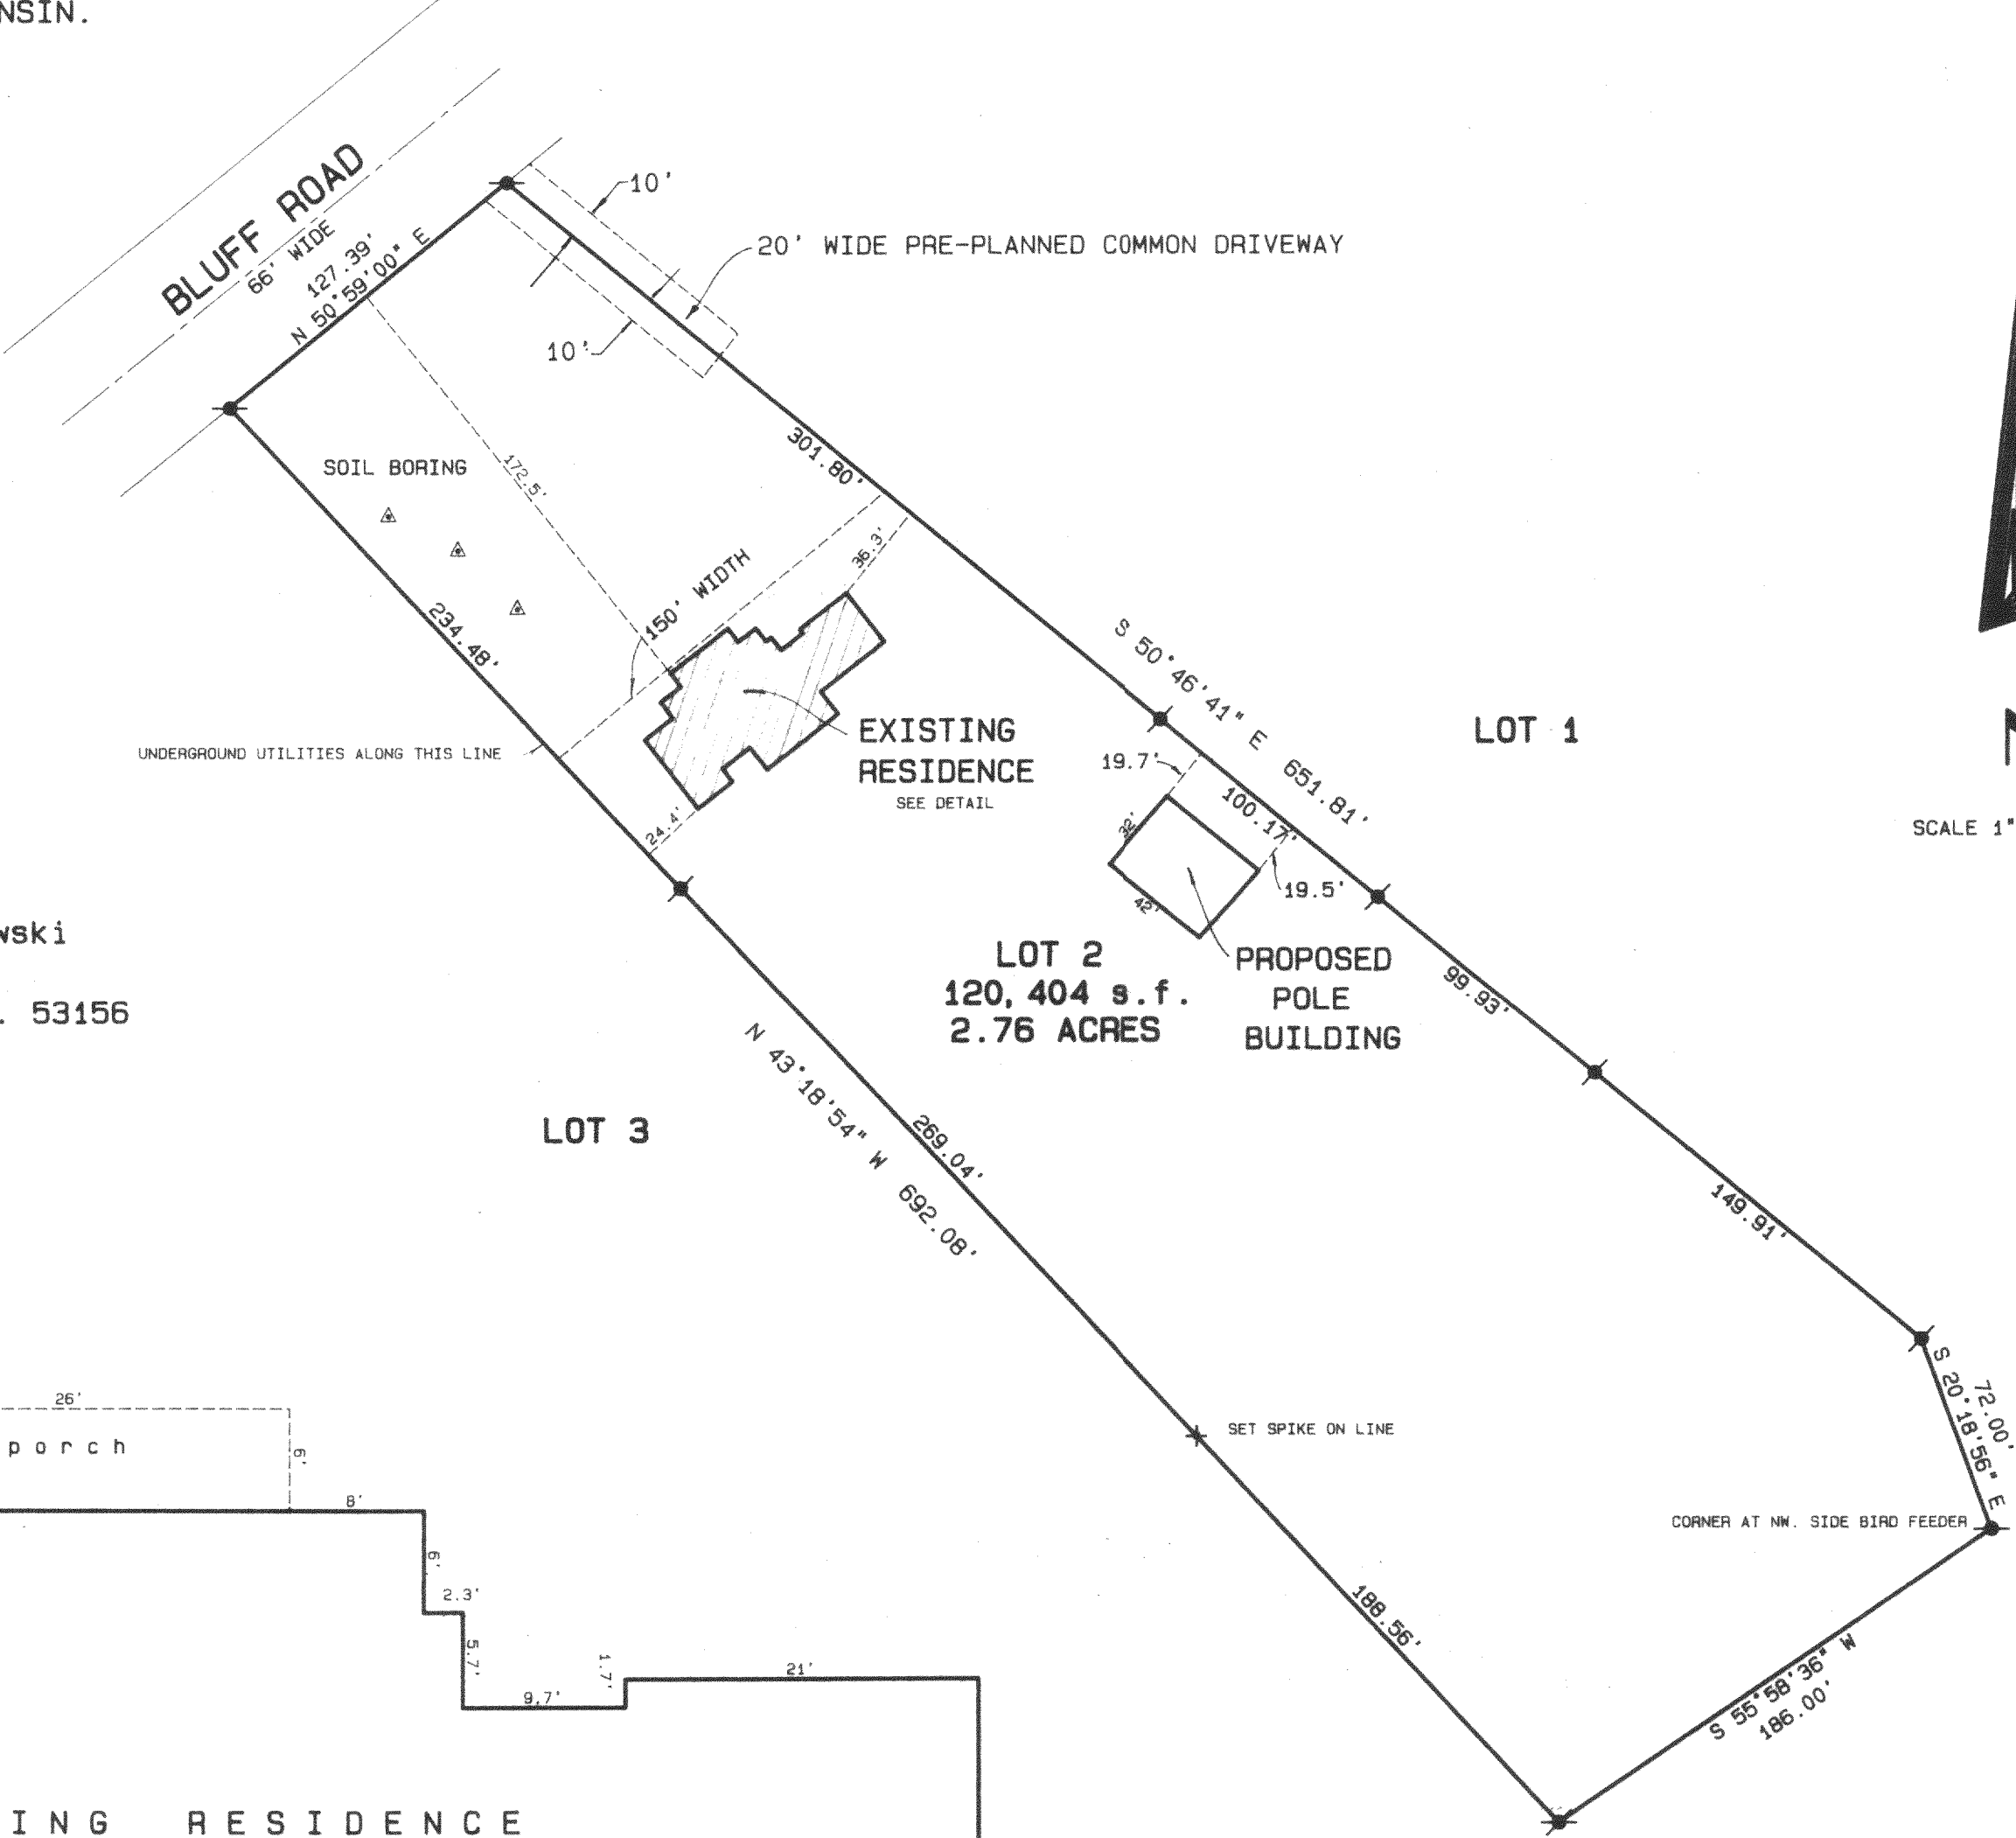


PLAT OF SURVEY



LOT 2 OF FAIRBLUFF ESTATES AS RECORDED IN CAB. "B"
AS SLIDE 57 OF WALWORTH COUNTY PLATS AS DOCUMENT
NO. 81246, LOCATED IN THE SOUTHWEST 1/4 OF SECTION
5, TOWN 4 NORTH, RANGE 16 EAST, TOWN OF LaGRANGE,
WALWORTH COUNTY, WISCONSIN.

Owner: Mark Szymkowski
Box 23
Palmyra, WI. 53156

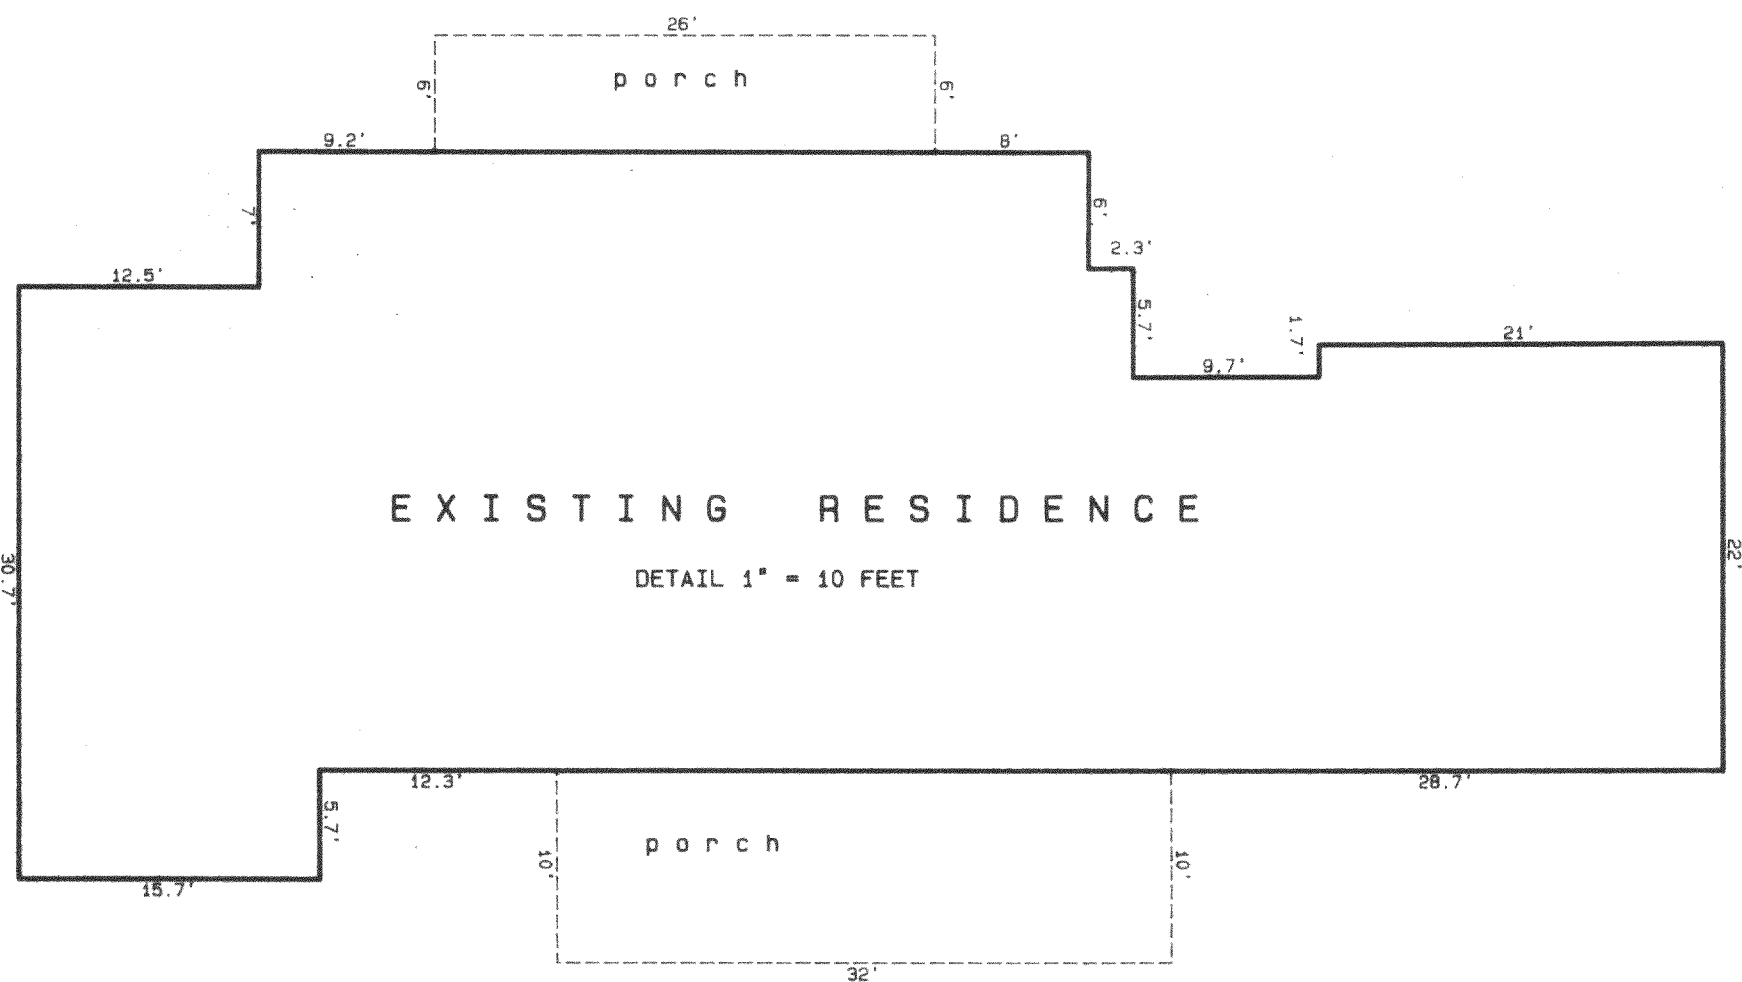

SCALE 1" = 60 FEET

- Legend
- FOUND IRON PIPE
 - FOUND IRON ROD
 - FOUND BRASS CAPPED MONUMENT
 - FOUND CONCRETE MONUMENT
 - CHISEL CUT IN CONCRETE
 - SET IRON ROD, 24" LONG, WEIGHING 1.5 LBS./LINEAL FT., 3/8" DIA.
 - SET IRON ROD, 30" LONG, WEIGHING 4.5 LBS./LINEAL FT., 1-11/16" DIA.
 - (xx) RECORDED AS DIMENSION
 - EXISTING FENCE

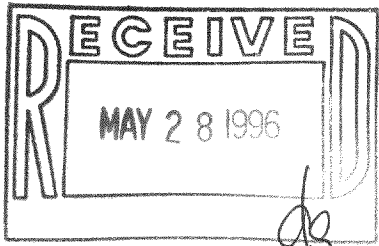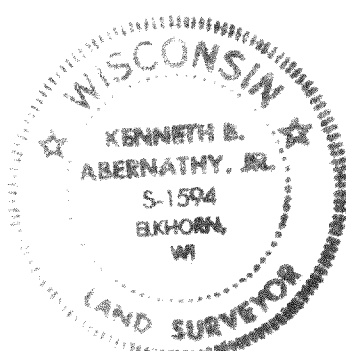

SCALE: 1" = 60 FEET

REVISED TO SHOW "AS BUILT" LOCATION
5/10/96

"I hereby certify that the above described property has been surveyed by me or under my direction and that the above map is a true representation thereof and shows the size and location of the property, its exterior boundaries, the location of all visible structures and dimensions of all principal buildings thereon, boundary fences, apparent easements, roadways and visible encroachments, if any."

"This survey is made for the use of the present owners of the property, and also those who purchase, mortgage, or guarantee the title thereto within one year from date hereof."

Kenneth B. Abernathy, Jr.
KENNETH B. ABERNATHY, JR.
WISCONSIN REGISTERED LAND SURVEYOR,
S-1594
Date: MAY 10, 1996 Job No. 95.1201