



GEORGE T. DUNHAM
SURVEYING & SUBDIVIDING
DELAVAN, WISCONSIN

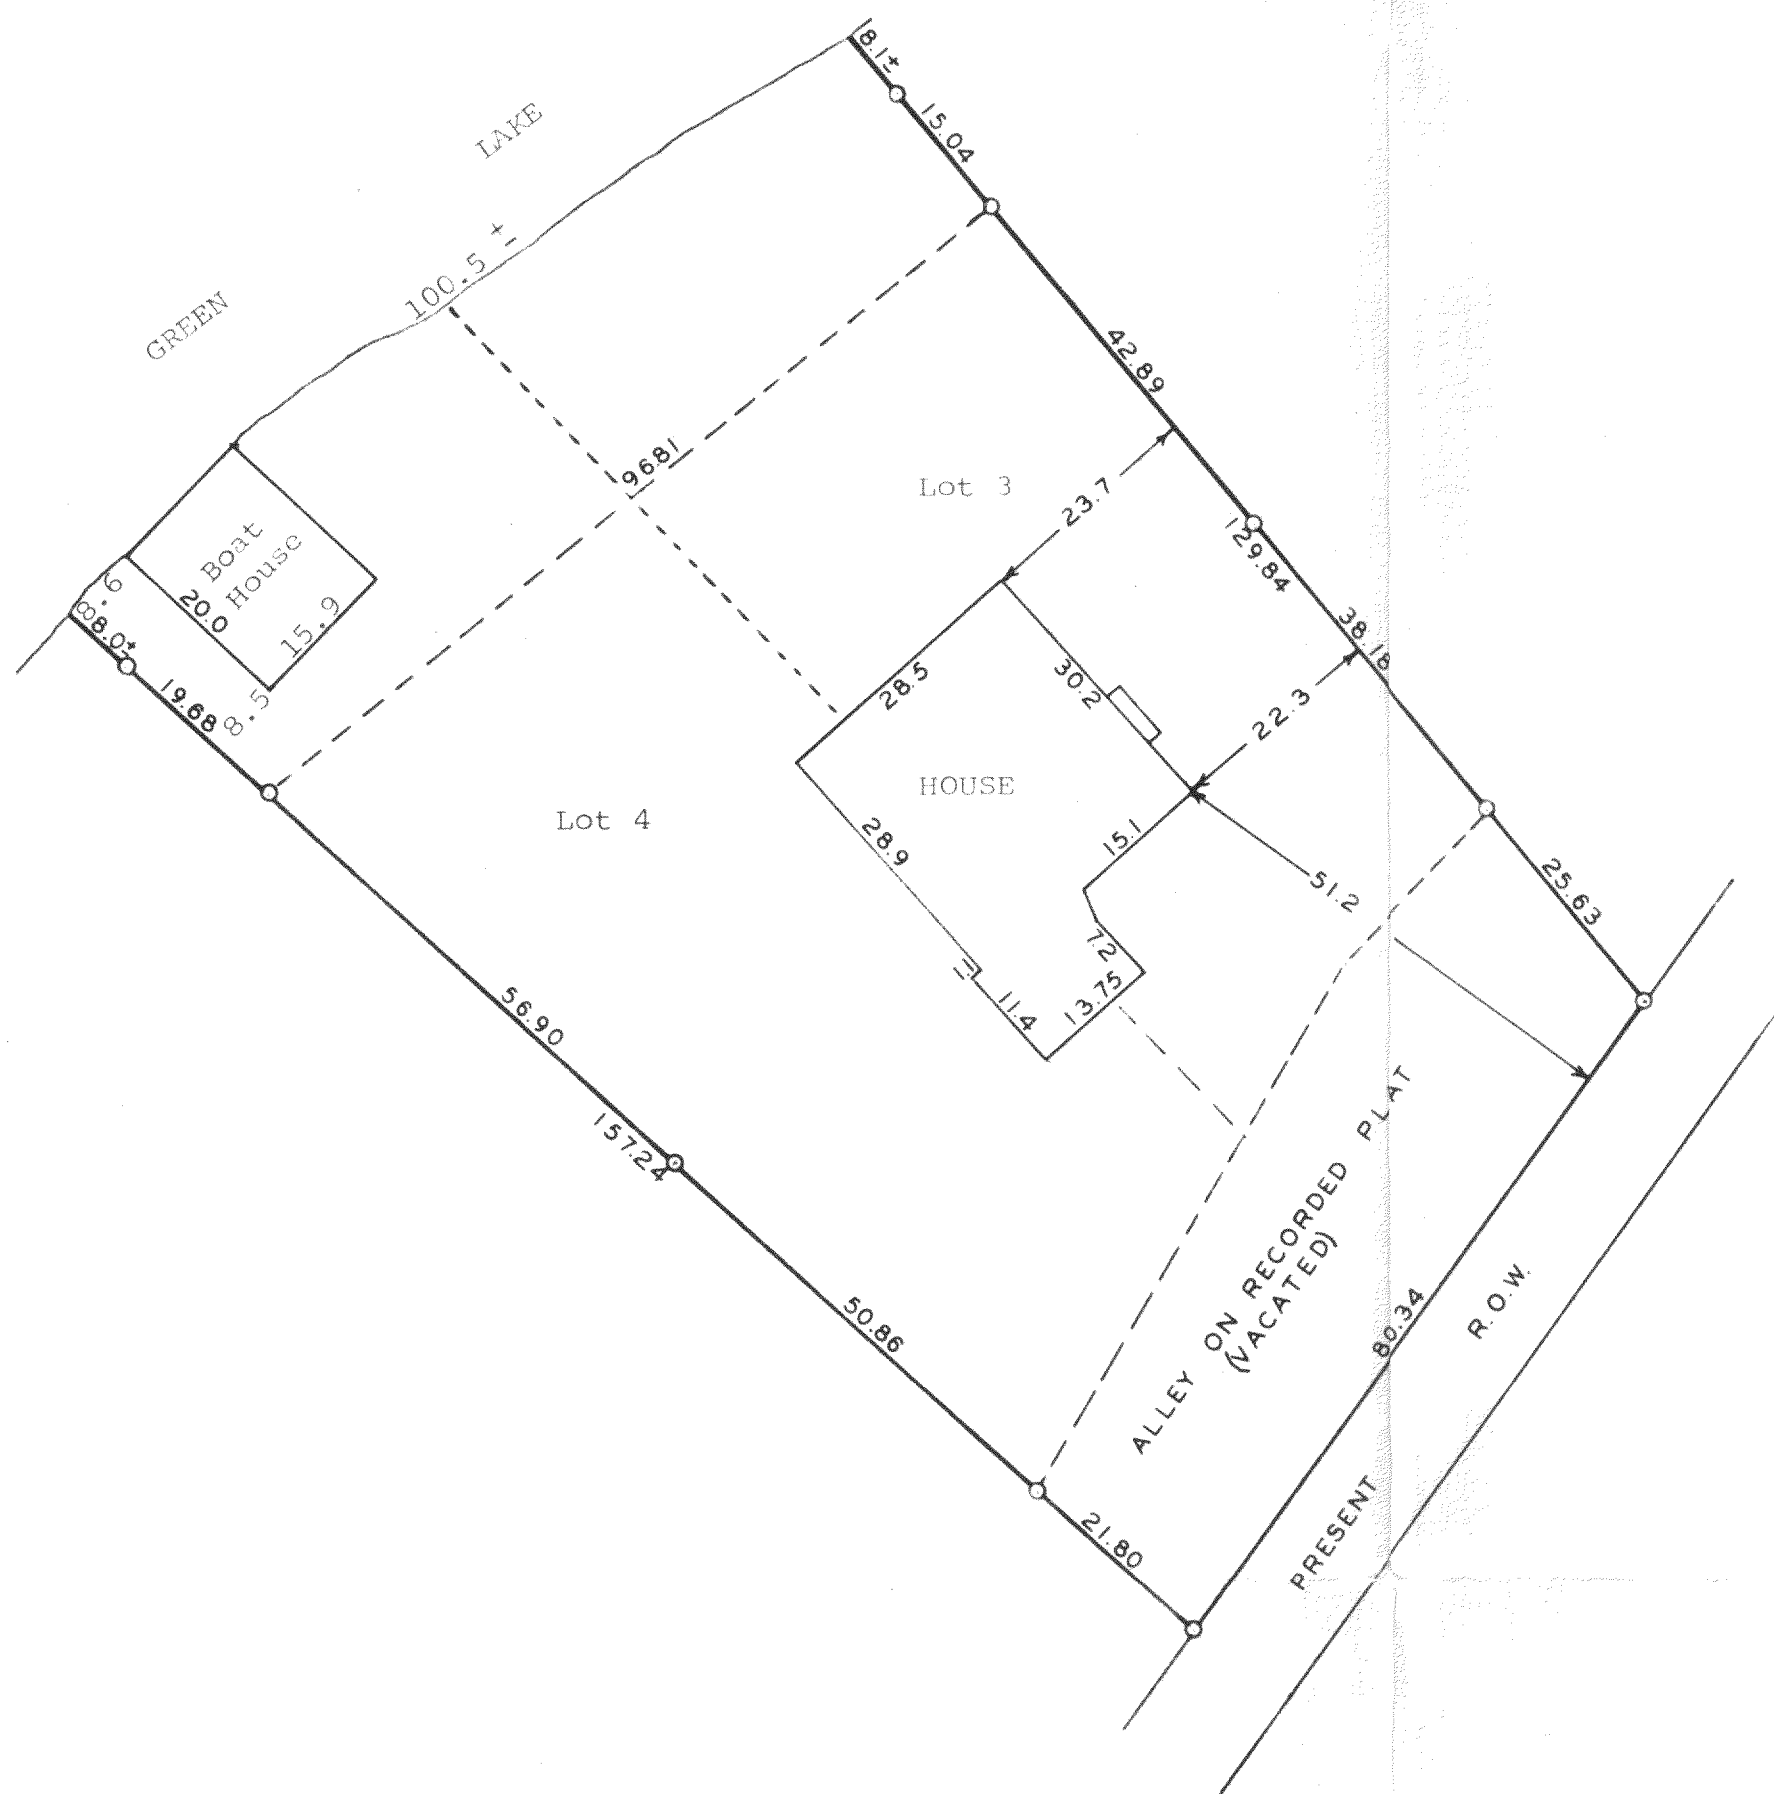

Scale - 1" = 20'
O = Iron Pipe

Plat of survey of Lots 3 and 4 in Block 2 of Green Lake
Park and a part of the vacated alley lying adjacent to
said lots all in Section 26, T 4 N, R 16 E, Walworth
County, Wisconsin.
June 11, 1971

George T. Dunham
George T. Dunham, Surveyor

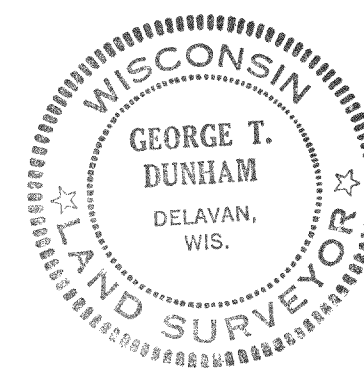

HGP-10

416-124