

**ABELL
SURVEYING & MAPPING
DELAVAN, WISCONSIN 53115
414-728-6737**




PLAT OF SURVEY OF

LOT 1, BLOCK 3, COOL HILL PARK,
T4N, R16E, WALWORTH COUNTY,
WISCONSIN.

ORDERED BY: CENTURY 21 -
SKANDIA REALTY
312 S. 7th ST.
DELAVAN, WI.
53115

REVISED: SEPT. 26, 1996 TO SHOW
THE PROPOSED ADDITIONS.

ORDERED BY: BARB HOWARD
N7544 COOL HILL CT.
ELKHORN, WI 53121

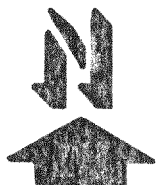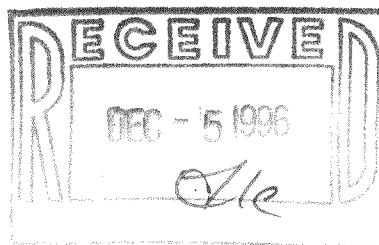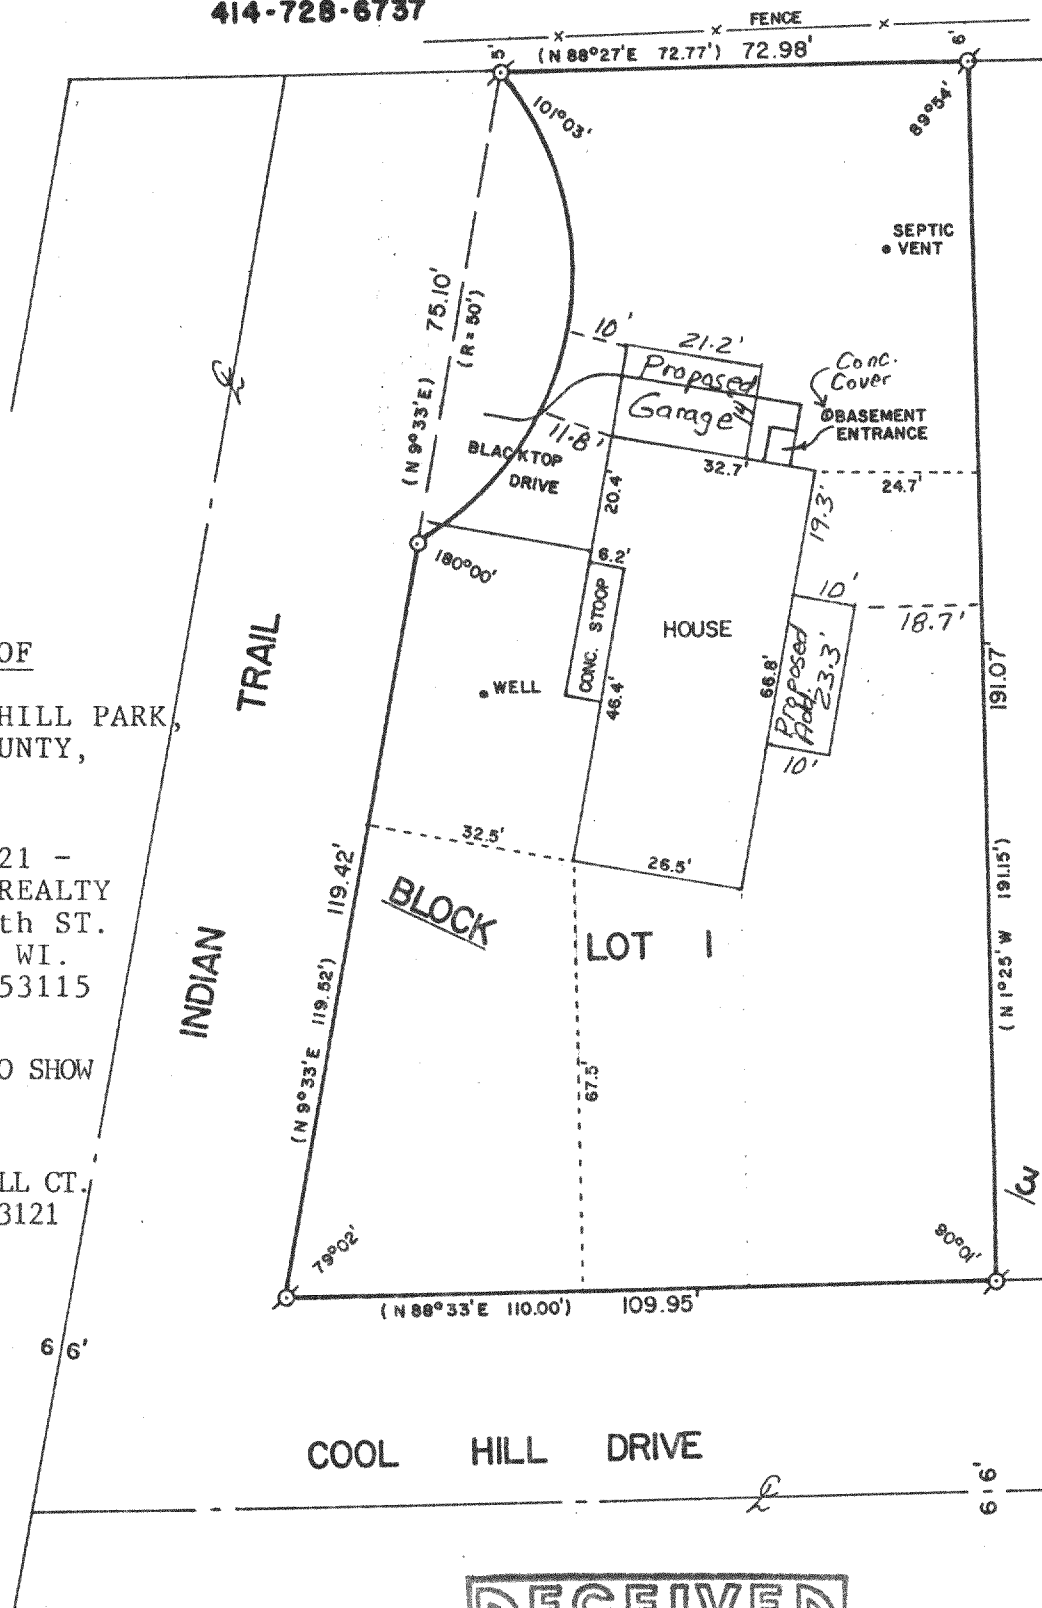

SCALE - 1"=30'

LEGEND

- ⊗ - IRON PIPE FOUND
- - IRON ROD SET
- () - RECORDED AS

I, DAVID F. ABELL, DO HEREBY CERTIFY
THAT I HAVE SURVEYED THE PROPERTY
HEREON DESCRIBED ACCORDING TO THE
OFFICIAL RECORDS AND THAT THE PLAT
HEREON IS A CORRECT REPRESENTATION
OF THE PROPERTY LINES TO THE BEST OF
MY KNOWLEDGE AND BELIEF.

David F. Abell

DAVID F. ABELL
WISCONSIN REGISTERED LAND SURVEYOR, S-1596

March 15, 1988

DATE JOB NUMBER - 88025

NOTE: THIS IS NOT A CERTIFIED COPY UNLESS SEALED.

HCH-15

416-1253