


PLAT OF SURVEY

LOCATION: Farm Village Lane, LaGrange, Wisconsin

LEGAL DESCRIPTION: Lot 1 in FARM VILLAGE SUBDIVISION, located in the Southeast 1/4 of the Southwest 1/4 and the Southwest 1/4 of the Southeast 1/4 and the Southeast 1/4 of the Southeast 1/4 of Section 25, in Town 4 North, Range 16 East, Walworth County, Wisconsin.

June 21, 1996

Survey No. 86775

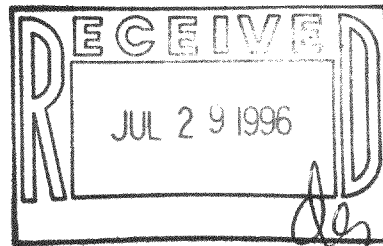

589°52'30"E
285.00

1" IRON
PIPE
FOUND



1"=100'

N14°53'16"E
639.08

PROP. FIN.
YD. GR.

(TO BE SET BY
OWNER & BLDG.)

STAKED
ACTUAL
SIZE

151.2

ATT.
GAR.

PROJ. DW.

EL. 96.5

EL. 93.7

EL. 93.5

EL. 97.0

EL. 97.3

EL. 94.4

EL. 94.3

EL. 94.3

1" IRON
PIPE
FOUND

EL. 100.00

146.89

EL. 100.0

RAD. = 1018.05
CHD. = 146.76
N84°26'19"W

ROD
FOUND

CULV. STAKE

283.37

N88°34'19"W

FARM VILLAGE LANE
(66' R.O.W.)

35'

EL. 96.80

ROD
FOUND

EL. 98.5

ENTRANCE
SIGN
EASEMENT

638.60 N1°46'55"E

PLEASANT LAKE ROAD
(66' R.O.W.)

METROPOLITAN SURVEY SERVICE, INC.

REGISTERED LAND SURVEYORS

9415 W. FOREST HOME AVE., SUITE 202, HALES CORNERS, WI 53130

PH. 529-5380 FAX 529-8787

I HEREBY CERTIFY THAT I HAVE SURVEYED THE ABOVE DESCRIBED PROPERTY AND THAT THE ABOVE MAP IS A TRUE REPRESENTATION THEREOF AND SHOWS THE SIZE AND LOCATION OF THE PROPERTY. ITS EXTERIOR BOUNDARIES, THE LOCATION OF ALL VISIBLE STRUCTURES AND DIMENSIONS OF ALL PRINCIPAL BUILDINGS THEREON, BOUNDARY FENCES, APPARENT EASEMENTS AND ROADWAYS AND VISIBLE ENCROACHMENTS, IF ANY.

THIS SURVEY IS MADE FOR THE EXCLUSIVE USE OF THE PRESENT OWNERS OF THE PROPERTY, AND ALSO THOSE WHO PURCHASE, MORTGAGE, OR GUARANTEE THE TITLE THERETO WITHIN ONE (1) YEAR FROM DATE HEREOF.

SIGNED

Gerald E. Casey
Registered Land Surveyor S-1329

proposed finished yard. 1st floor or top of foundation grade shown on this drawing is a suggested grade and should be verified by the owner and/or the builder.

HF-1

416-1269




PLAT OF SURVEY

LOCATION: W4912 Farm Village Lane, LaGrange, Wisconsin

LEGAL DESCRIPTION: Lot 1 in FARM VILLAGE SUBDIVISION, located in the Southeast 1/4 of the Southwest 1/4 and the Southwest 1/4 of the Southeast 1/4 and the Southeast 1/4 of the Southeast 1/4 of Section 25, in Town 4 North, Range 16 East, Walworth County, Wisconsin.

October 15, 1996

Survey No. 87261

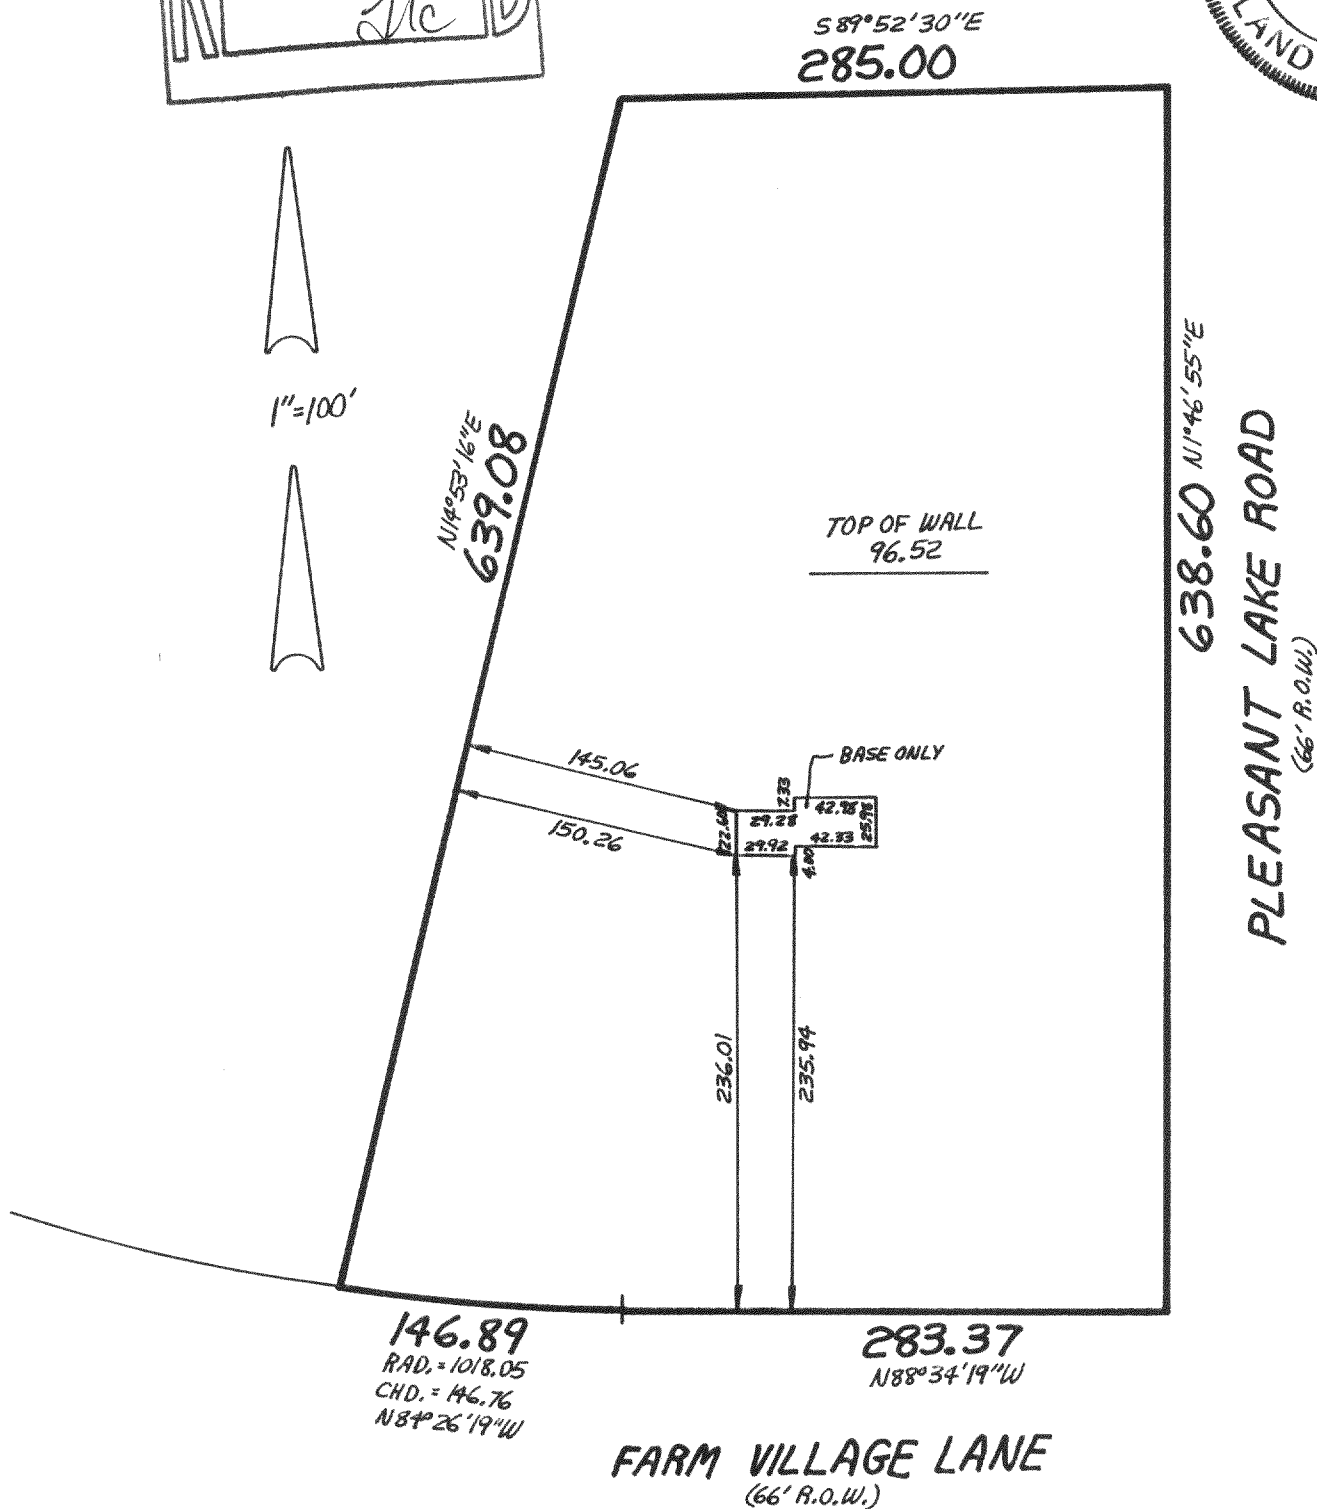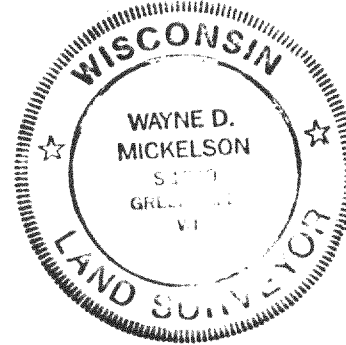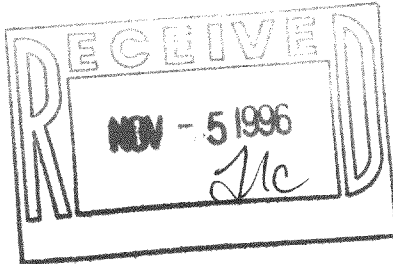

METROPOLITAN SURVEY SERVICE, INC.

REGISTERED LAND SURVEYORS

9415 W. FOREST HOME AVE., SUITE 202, HALES CORNERS, WI 53130

PH. 529-5380 FAX 529-8787

I HEREBY CERTIFY THAT I HAVE SURVEYED THE ABOVE DESCRIBED PROPERTY AND THAT THE ABOVE MAP IS A TRUE REPRESENTATION THEREOF AND SHOWS THE SIZE AND LOCATION OF THE PROPERTY. ITS EXTERIOR BOUNDARIES, THE LOCATION OF ALL VISIBLE STRUCTURES AND DIMENSIONS OF ALL PRINCIPAL BUILDINGS THEREON, BOUNDARY FENCES, APPARENT EASEMENTS AND ROADWAYS AND VISIBLE ENCROACHMENTS, IF ANY.

THIS SURVEY IS MADE FOR THE EXCLUSIVE USE OF THE PRESENT OWNERS OF THE PROPERTY, AND ALSO THOSE WHO PURCHASE, MORTGAGE, OR GUARANTEE THE TITLE THERETO WITHIN ONE (1) YEAR FROM DATE HEREOF.

SIGNED

Gerald E. Casey
Registered Land Surveyor S-1329

HF-1