


SURVEY NO. 1207

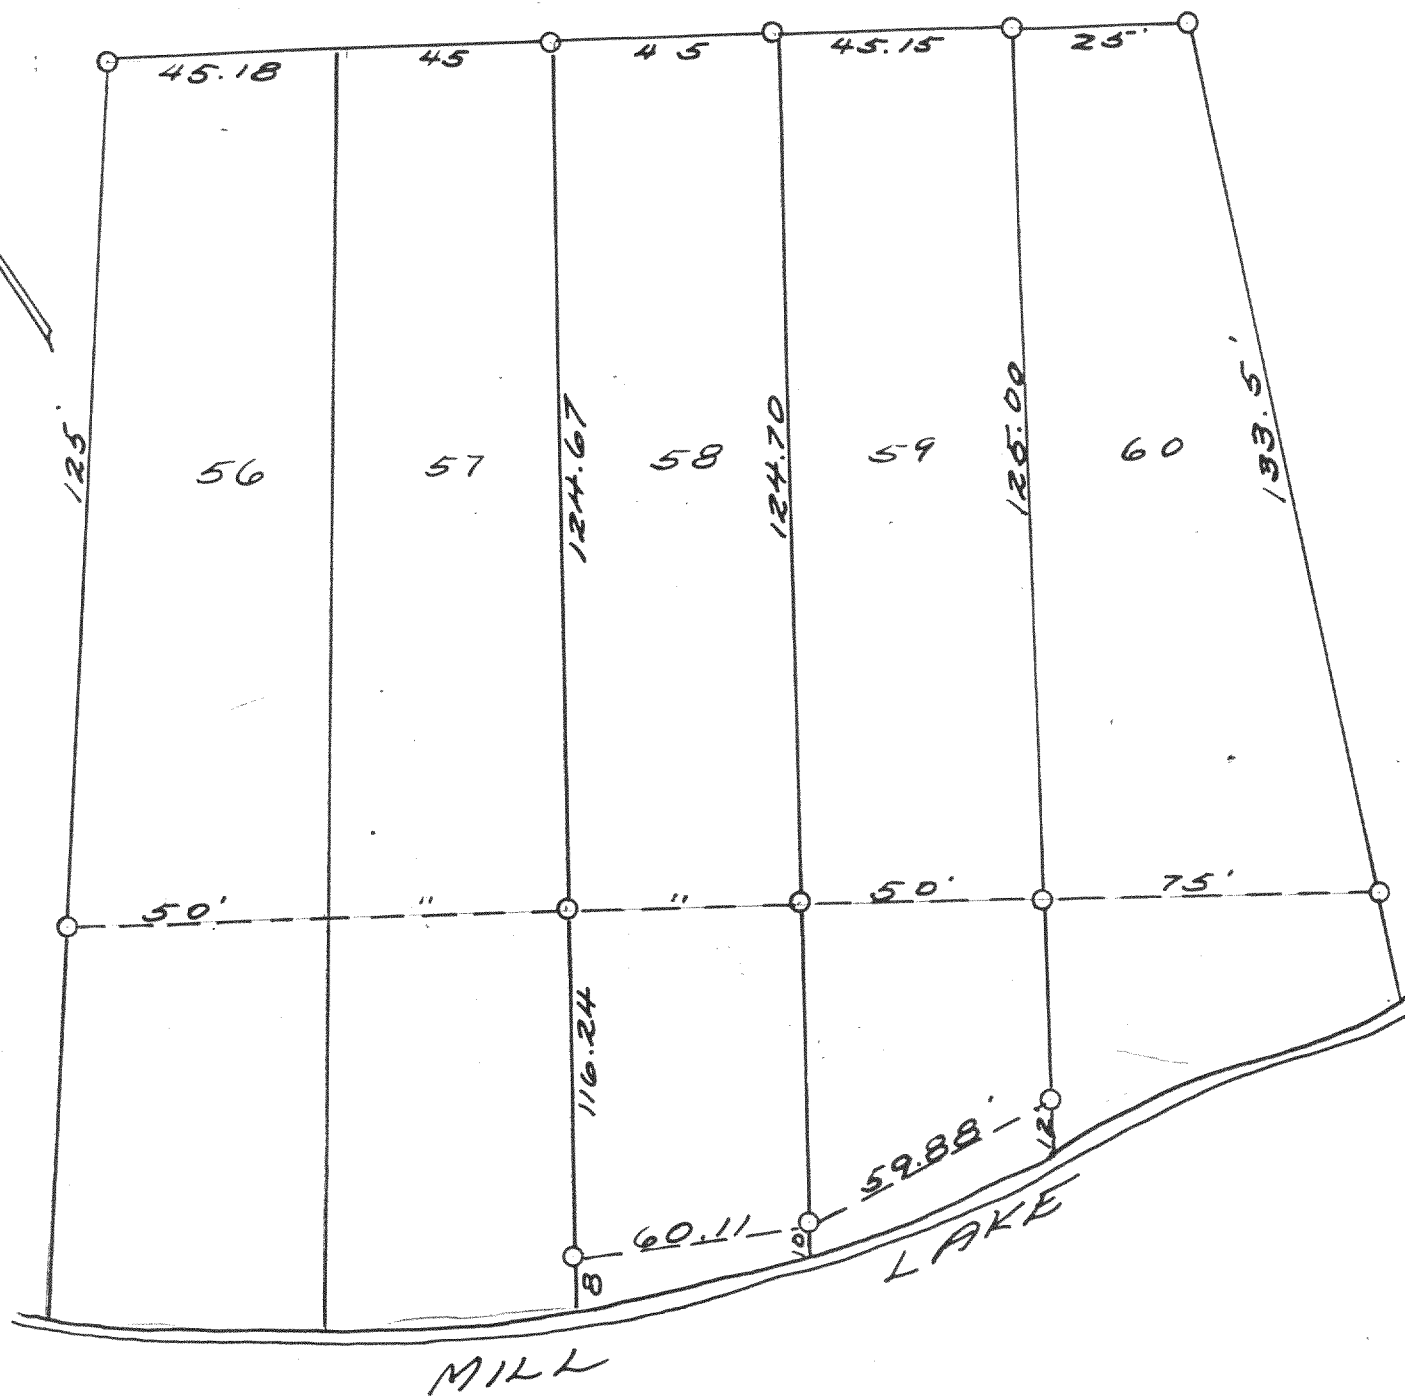

PLAT OF SURVEY OF LOTS 58 & 59 OF
LAUDERDALE HEIGHTS IN THE SW FR. $\frac{1}{4}$
OF SECTION 36 T4N R16E OF WALWORTH
COUNTY, WISCONSIN.

DEC., 1941

Lloyd L. Jensen
H.E.J.

HLN 20, 21

416-128 J