
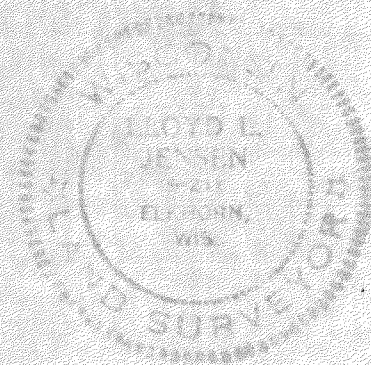


PLAT OF SURVEY OF

LOT 7 AND PART OF LOT 8, BLOCK 1, GREEN LAKE PARK
SUBDIVISION, LOCATED IN GOVERNMENT LOT 5, SECTION
26, T4N R16E, WALWORTH COUNTY, WISCONSIN.

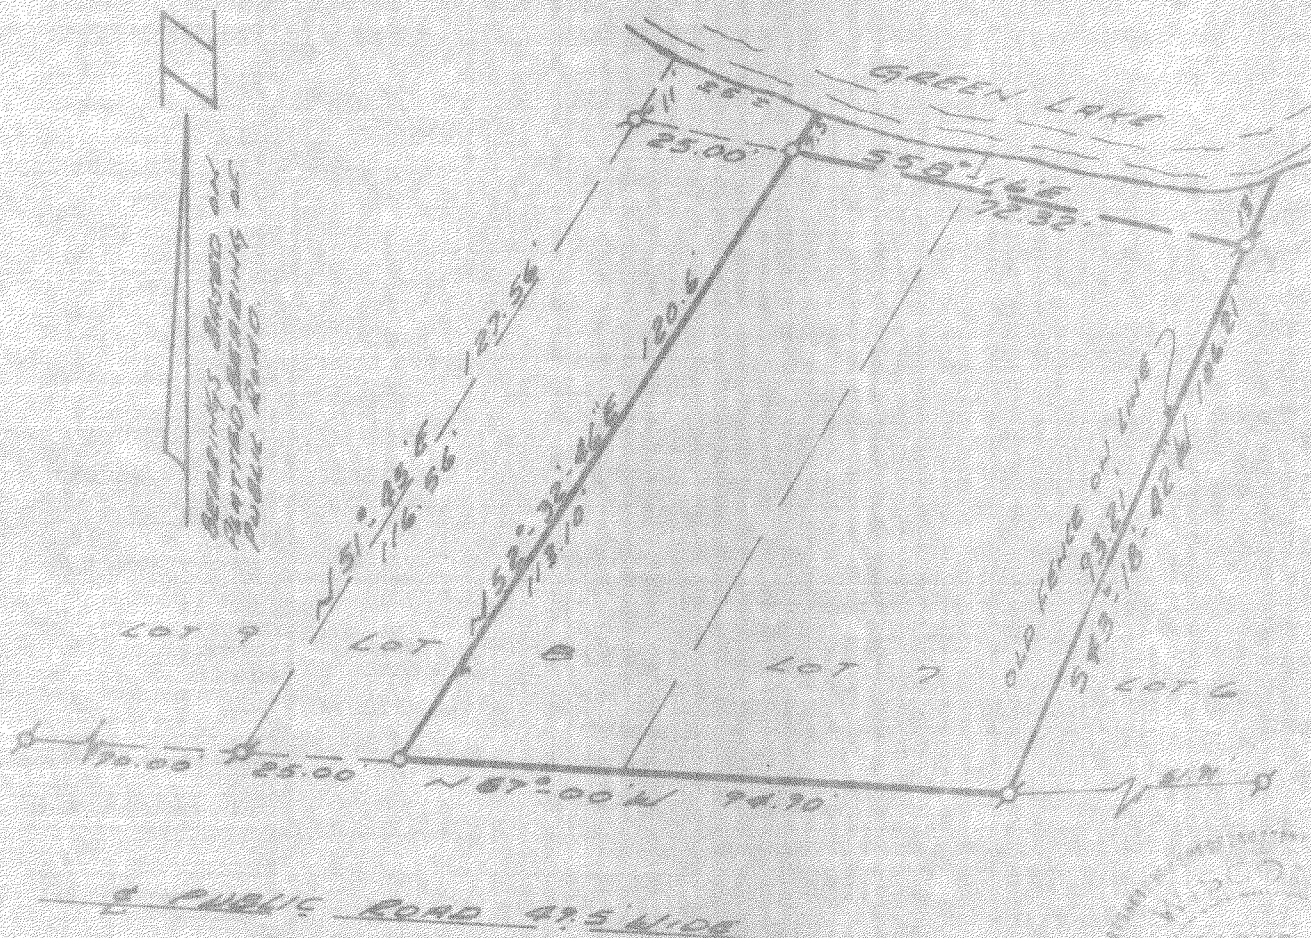

SURVEY AND PLAT BY
JENSEN & JOHNSON, INC.
CIVIL ENGINEERS AND SURVEYORS
Elkhorn, Wisconsin

LEGEND

- — Iron Pipe 3/8"
- — Concrete Monument
- Scale 1" = 30'

B — IRON PIPE FOUND

WE CERTIFY: That we have surveyed the above described property and that the plat shown hereon is an accurate survey and a true representation thereof and correctly shows the exterior boundary lines and all divisions of said property.

Date SEPT. 6, 1972

Lloyd L. Jensen
LLOYD L. JENSEN,

Wisconsin Registered Land Surveyor, No. S-211

HGP-7

416-130.1