


ABELL
SURVEYING & MAPPING
1140 SEQUOIA STREET • DELAVAN, WISCONSIN 53115
414-728-6737

MIDDLE LAKE

TOPOGRAPHIC SURVEY OF

LOT 117, 2nd ADDITION TO BUBBLING SPRINGS
SUBDIVISION, LOCATED IN T4N, R16E, WALWORTH
COUNTY, WISCONSIN.

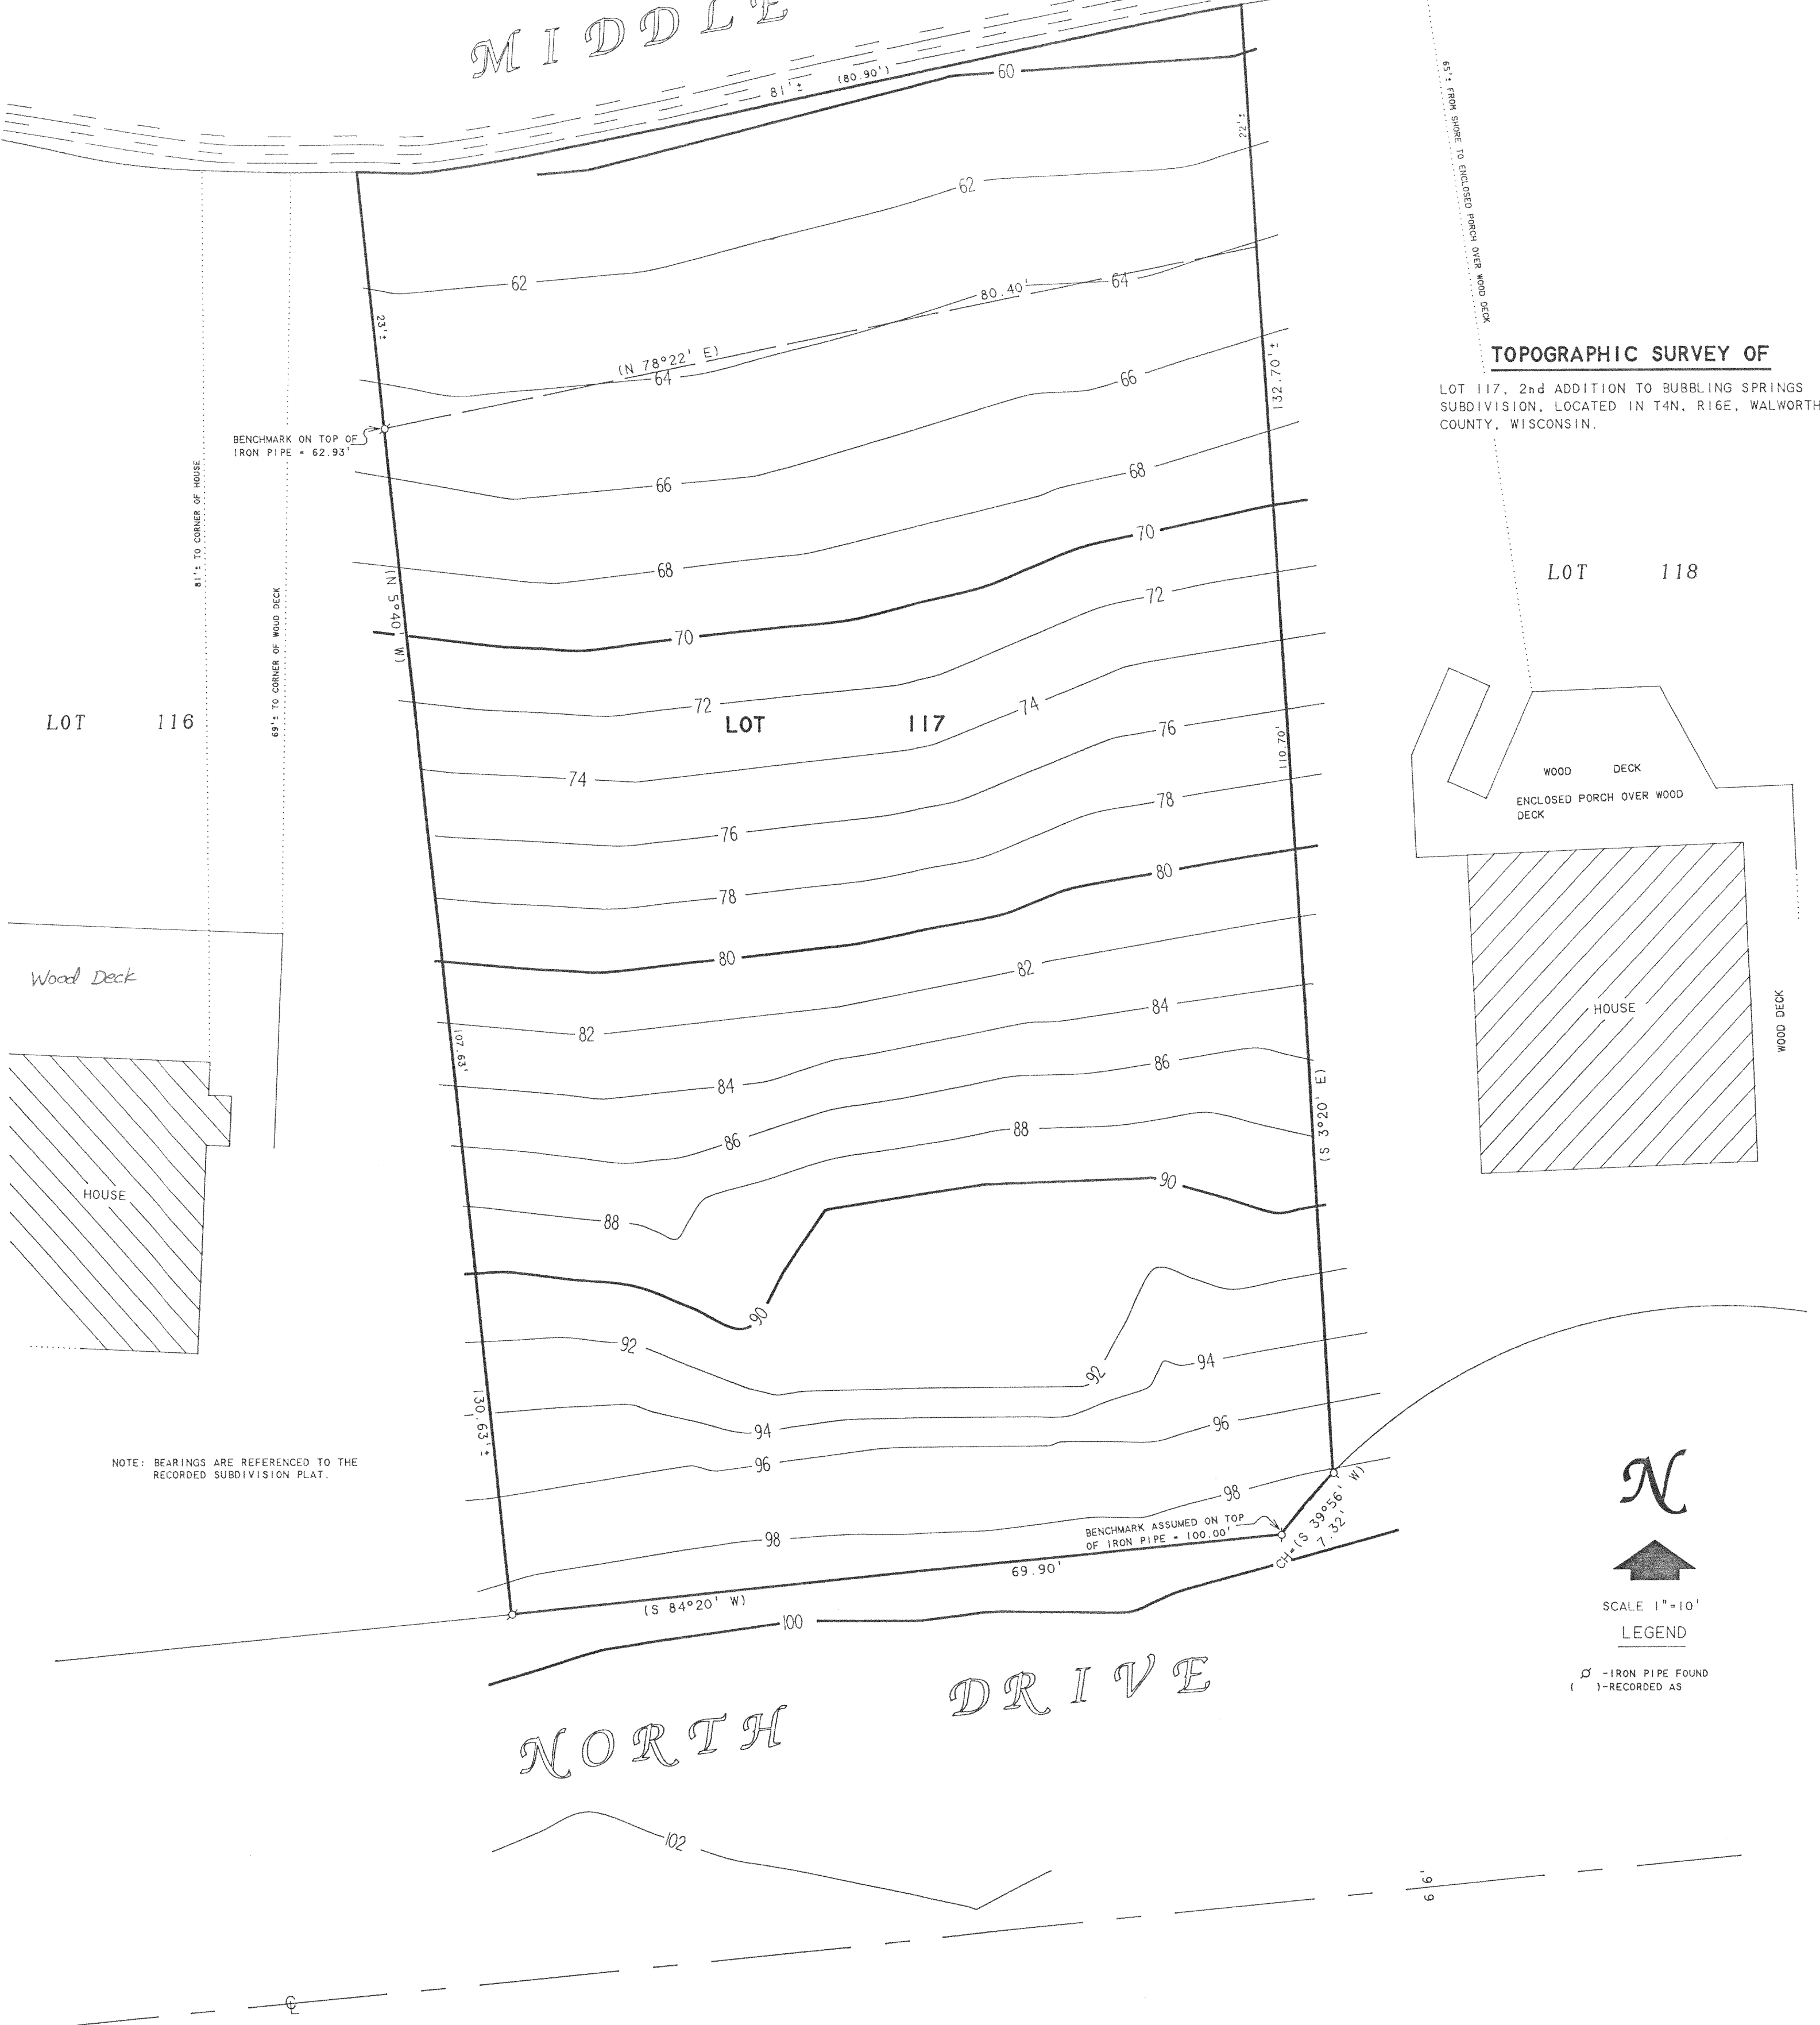

N

SCALE 1"=10'

LEGEND

○ - IRON PIPE FOUND
() - RECORDED AS

REVISED DATE: JULY 29, 1997
REVISED TO SHOW LOCATION OF HOUSES ON
LOTS 116 AND 118 TOGETHER WITH REVISED
SHORELINE LOCATION 7/29/97.

REVISED DATE: SEPT. 4, 1997

ORDERED BY: JEFF ERICKSON
24099 HAIDILANE
LAKE VILLA, IL 60046

David F. Abell

DAVID F. ABELL
WISCONSIN REGISTERED LAND SURVEYOR, S-1596

March 18, 1997

DATE: March 18, 1997 JOB NUMBER - 97039
NOTE: THIS IS NOT A CERTIFIED COPY UNLESS SEALED.

ABELL
SURVEYING & MAPPING
1140 SEQUOIA STREET • DELAVAN, WISCONSIN 53115
414-728-6737

MIDDLE LAKE

TOPOGRAPHIC SURVEY OF

LOT 117, 2nd ADDITION TO BUBBLING SPRINGS
SUBDIVISION, LOCATED IN T4N, R16E, WALWORTH
COUNTY, WISCONSIN.

LOT 116

LOT 117

LOT 118

WOOD DECK

WOOD DECK

HOUSE

HOUSE

NOTE: BEARINGS ARE REFERENCED TO THE
RECORDED SUBDIVISION PLAT.


BENCHMARK ASSUMED ON TOP
OF IRON PIPE = 100.00'

N

SCALE 1"=10'
LEGEND

Ø - IRON PIPE FOUND
() - RECORDED AS

NORTH DRIVE

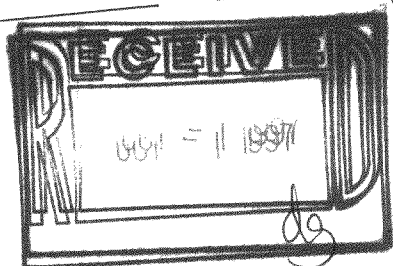

REVISED DATE: JULY 29, 1997.
REVISED TO SHOW LOCATION OF HOUSES ON
LOTS 116 AND 118 TOGETHER WITH REVISED
SHORELINE LOCATION 7/29/97.

ORDERED BY: JEFF ERICKSON
24099 HAIDI LANE
LAKE VILLA, IL 60046

David F. Abell

DAVID F. ABELL
WISCONSIN REGISTERED LAND SURVEYOR, S-1596

March 18, 1997

DATE: March 18, 1997
NOTE: THIS IS NOT A CERTIFIED COPY UNLESS SEALED.

JOB NUMBER - 97039

416-1314
HBS2-38