


PLAT OF SURVEY


61256

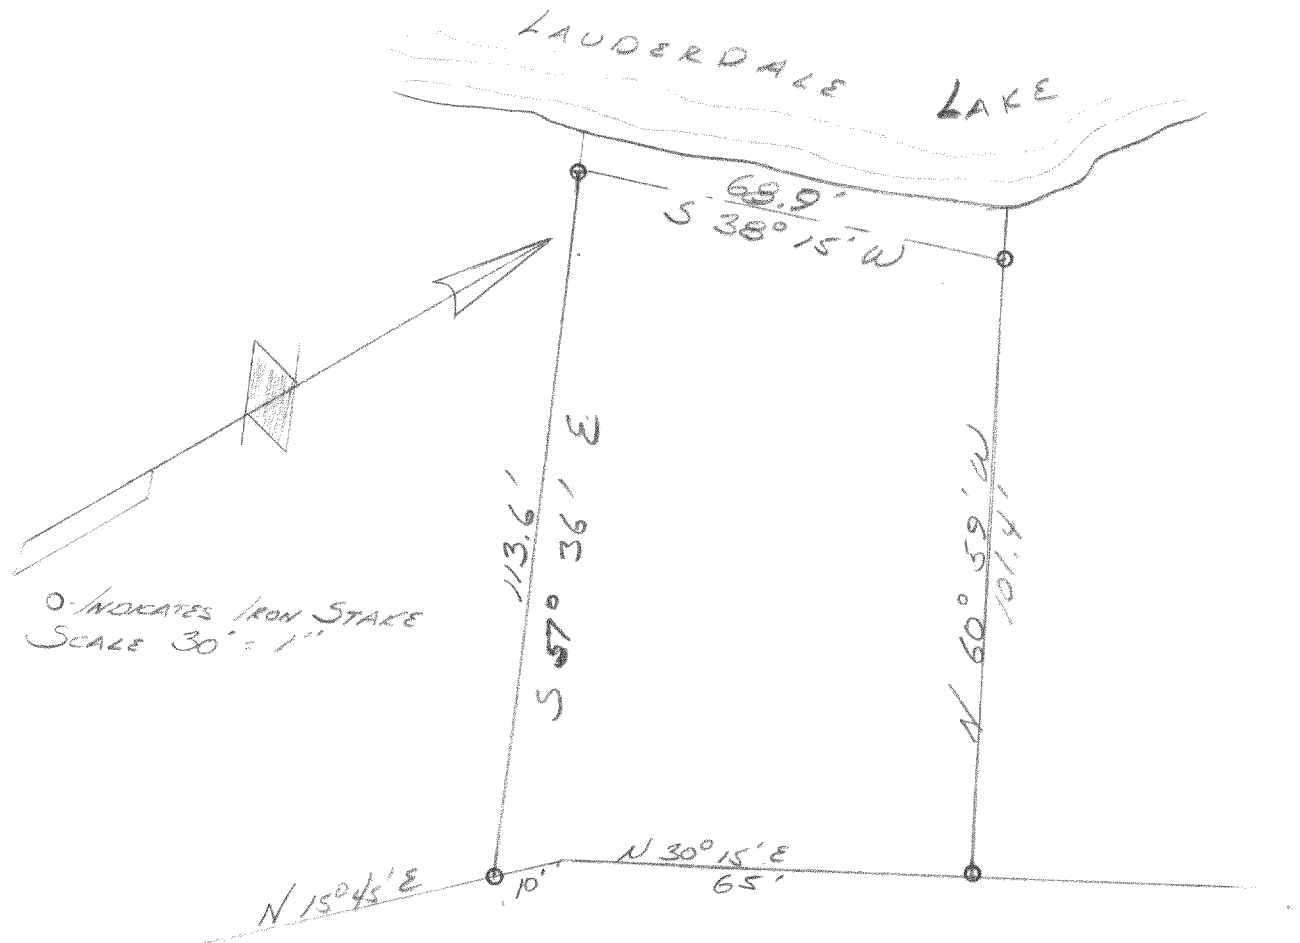

DESCRIPTION: Lot 6, the Westerly 10 feet of Lot 7, and the Easterly 10 feet of Lot 5 of La Silva Subdivision, a Subdivision of a part of the NW $\frac{1}{4}$ of the SE $\frac{1}{4}$ of Section 26, Town 4 North, Range 16 East, in the Town of La Grange, Walworth County, Wisconsin.

CERTIFICATE: I hereby certify that I have on this the 9th day of July 1956 surveyed the above property, and I further certify that the exterior boundaries are as shown on this drawing.

Signed and sealed on this the 1st day of July 1956.

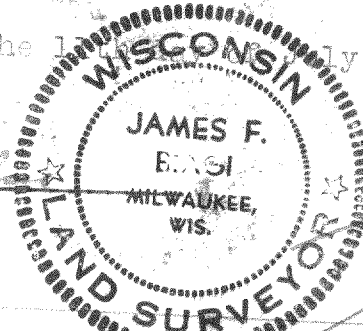

HL-5 Surveyor

Reg. Land Surveyor

416-313