

ABERNATHY and ASSOCIATES

Kenneth B. Abernathy Jr.


Wisconsin Registered Land Surveyor S-1594

W4056 Bray Road
Elkhorn, Wisconsin 53121
Phone: (414) 723-4260 (office)
(414) 723-7209 (fax)

PLAT OF SURVEY

Lot 50 of Lauderdale Heights Subdivision, located
in part of the Southwest 1/4 of Section 36,
Town 4 North, Range 16 East, Town of La Grange,
County of Walworth, State of Wisconsin.

Owners: Rodger & Linda Duclos
520 Joy Lane
Sleepy Hollow, Illinois 60118

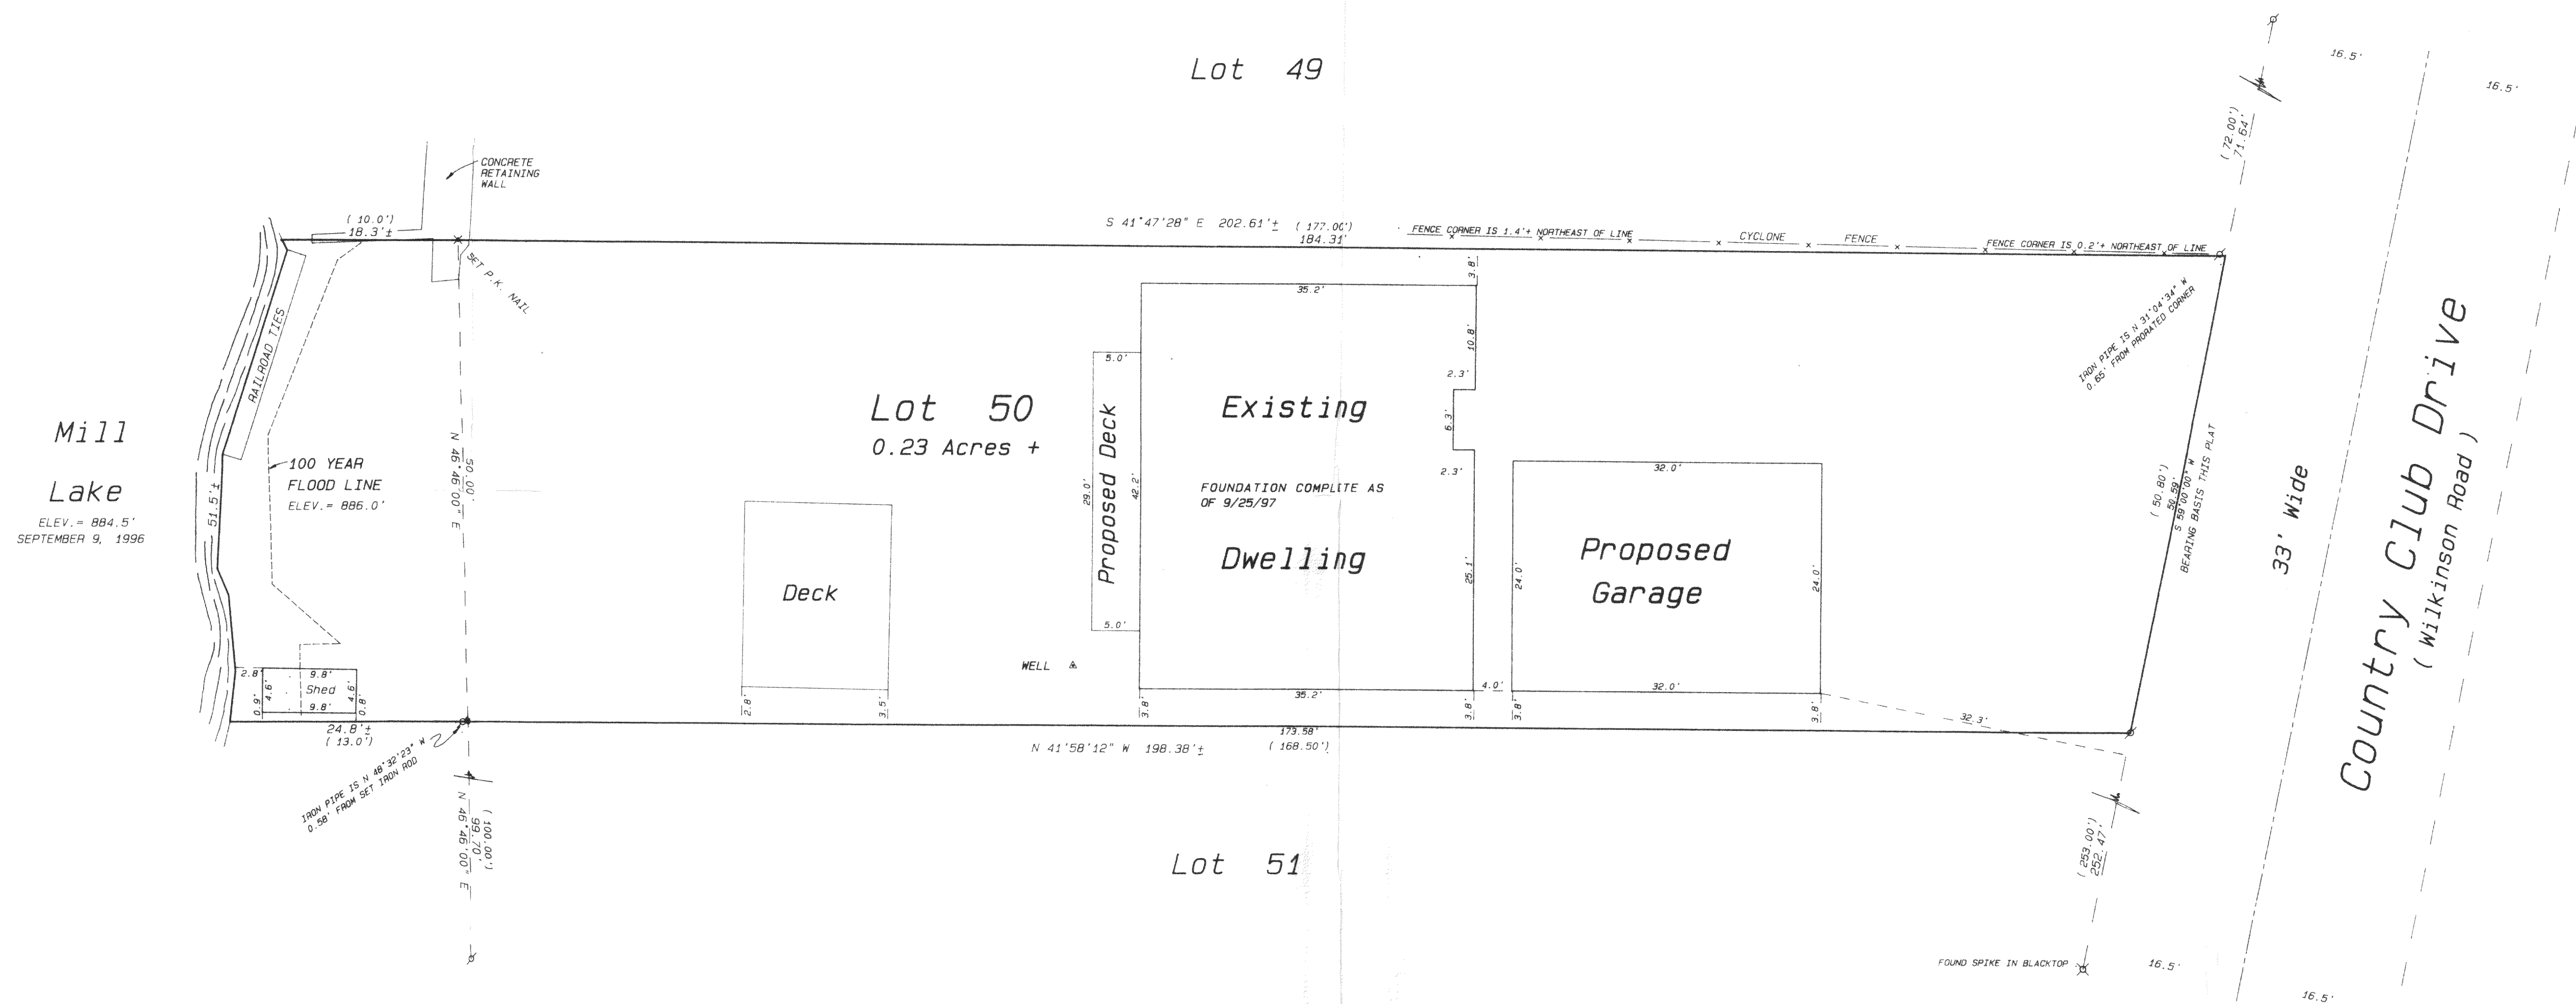


Ordered by: Ron Deschner
Deschner Building Contractors, Inc.
3338 North Shore Drive
Delavan, Wisconsin 53115

Legend

- FOUND IRON PIPE
- FOUND IRON ROD
- FOUND BRASS CAPPED MONUMENT
- FOUND CONCRETE MONUMENT
- CHISEL CUT IN CONCRETE
- SET IRON ROD 24" LONG, WEIGHING 1.5 LBS. LINEAL FT., 3/4" DIA.
- SET IRON ROD 30" LONG, WEIGHING 4.5 LBS. LINEAL FT., 1 1/16" DIA.
- RECORDED AS DIMENSION
- EXISTING FENCE



SCALE: 1" = 10 FEET

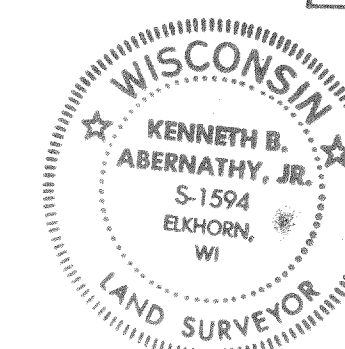

I hereby certify that the above described property has been surveyed by me, or under my direction and that the above map is a true representation thereof and shows the size and location of the property, exterior boundaries, the location of all visible structures and dimensions of all principal buildings thereon, boundary fences, apparent easements, roadways and visible encroachments, if any. This survey is made for the use of the present owners of the property and also those who purchase, mortgage, or guarantee the title in the future within one year from date hereof.

Kenneth B. Abernathy, Jr.
WISCONSIN REGISTERED LAND SURVEYOR,
S-1594
September 12, 1996
Date: _____ Job No. _____

REVISED 9/26/97 TO SHOW
COMPLETE FOUNDATION

416-1329
HLH-14