


WORK ORDERED BY:
DEBBIE KOLACHE
4113 POPLAR DRIVE
DELAVER, WISCONSIN 53115

FARRIS, HANSEN & ASSOCIATES, INC.
Engineering, Architecture, Surveying
7 Ridgway Court P.O. Box 437
ELKHORN, WISCONSIN 53121
Office: (414) 723-2098
Fax: (414) 723-5886


REVISIONS
10-10-97
SHOW ASBLT
FOUNDATION &
PROPOSED GAR.

PROJECT NO.	4801
DATE:	07/07/97
SHEET NO.	1 OF 1

LOT 13 OF DUNBAR ESTATES
A RECORDED SUBDIVISION LOCATED IN THE
NORTHWEST 1/4 OF THE SOUTHEAST 1/4 AND THE
NORTHEAST 1/4 OF THE SOUTHEAST 1/4 OF
SECTION 36, TOWN 4 NORTH, RANGE 16 EAST,
TOWN OF LAGRANGE, WALWORTH COUNTY, WISCONSIN

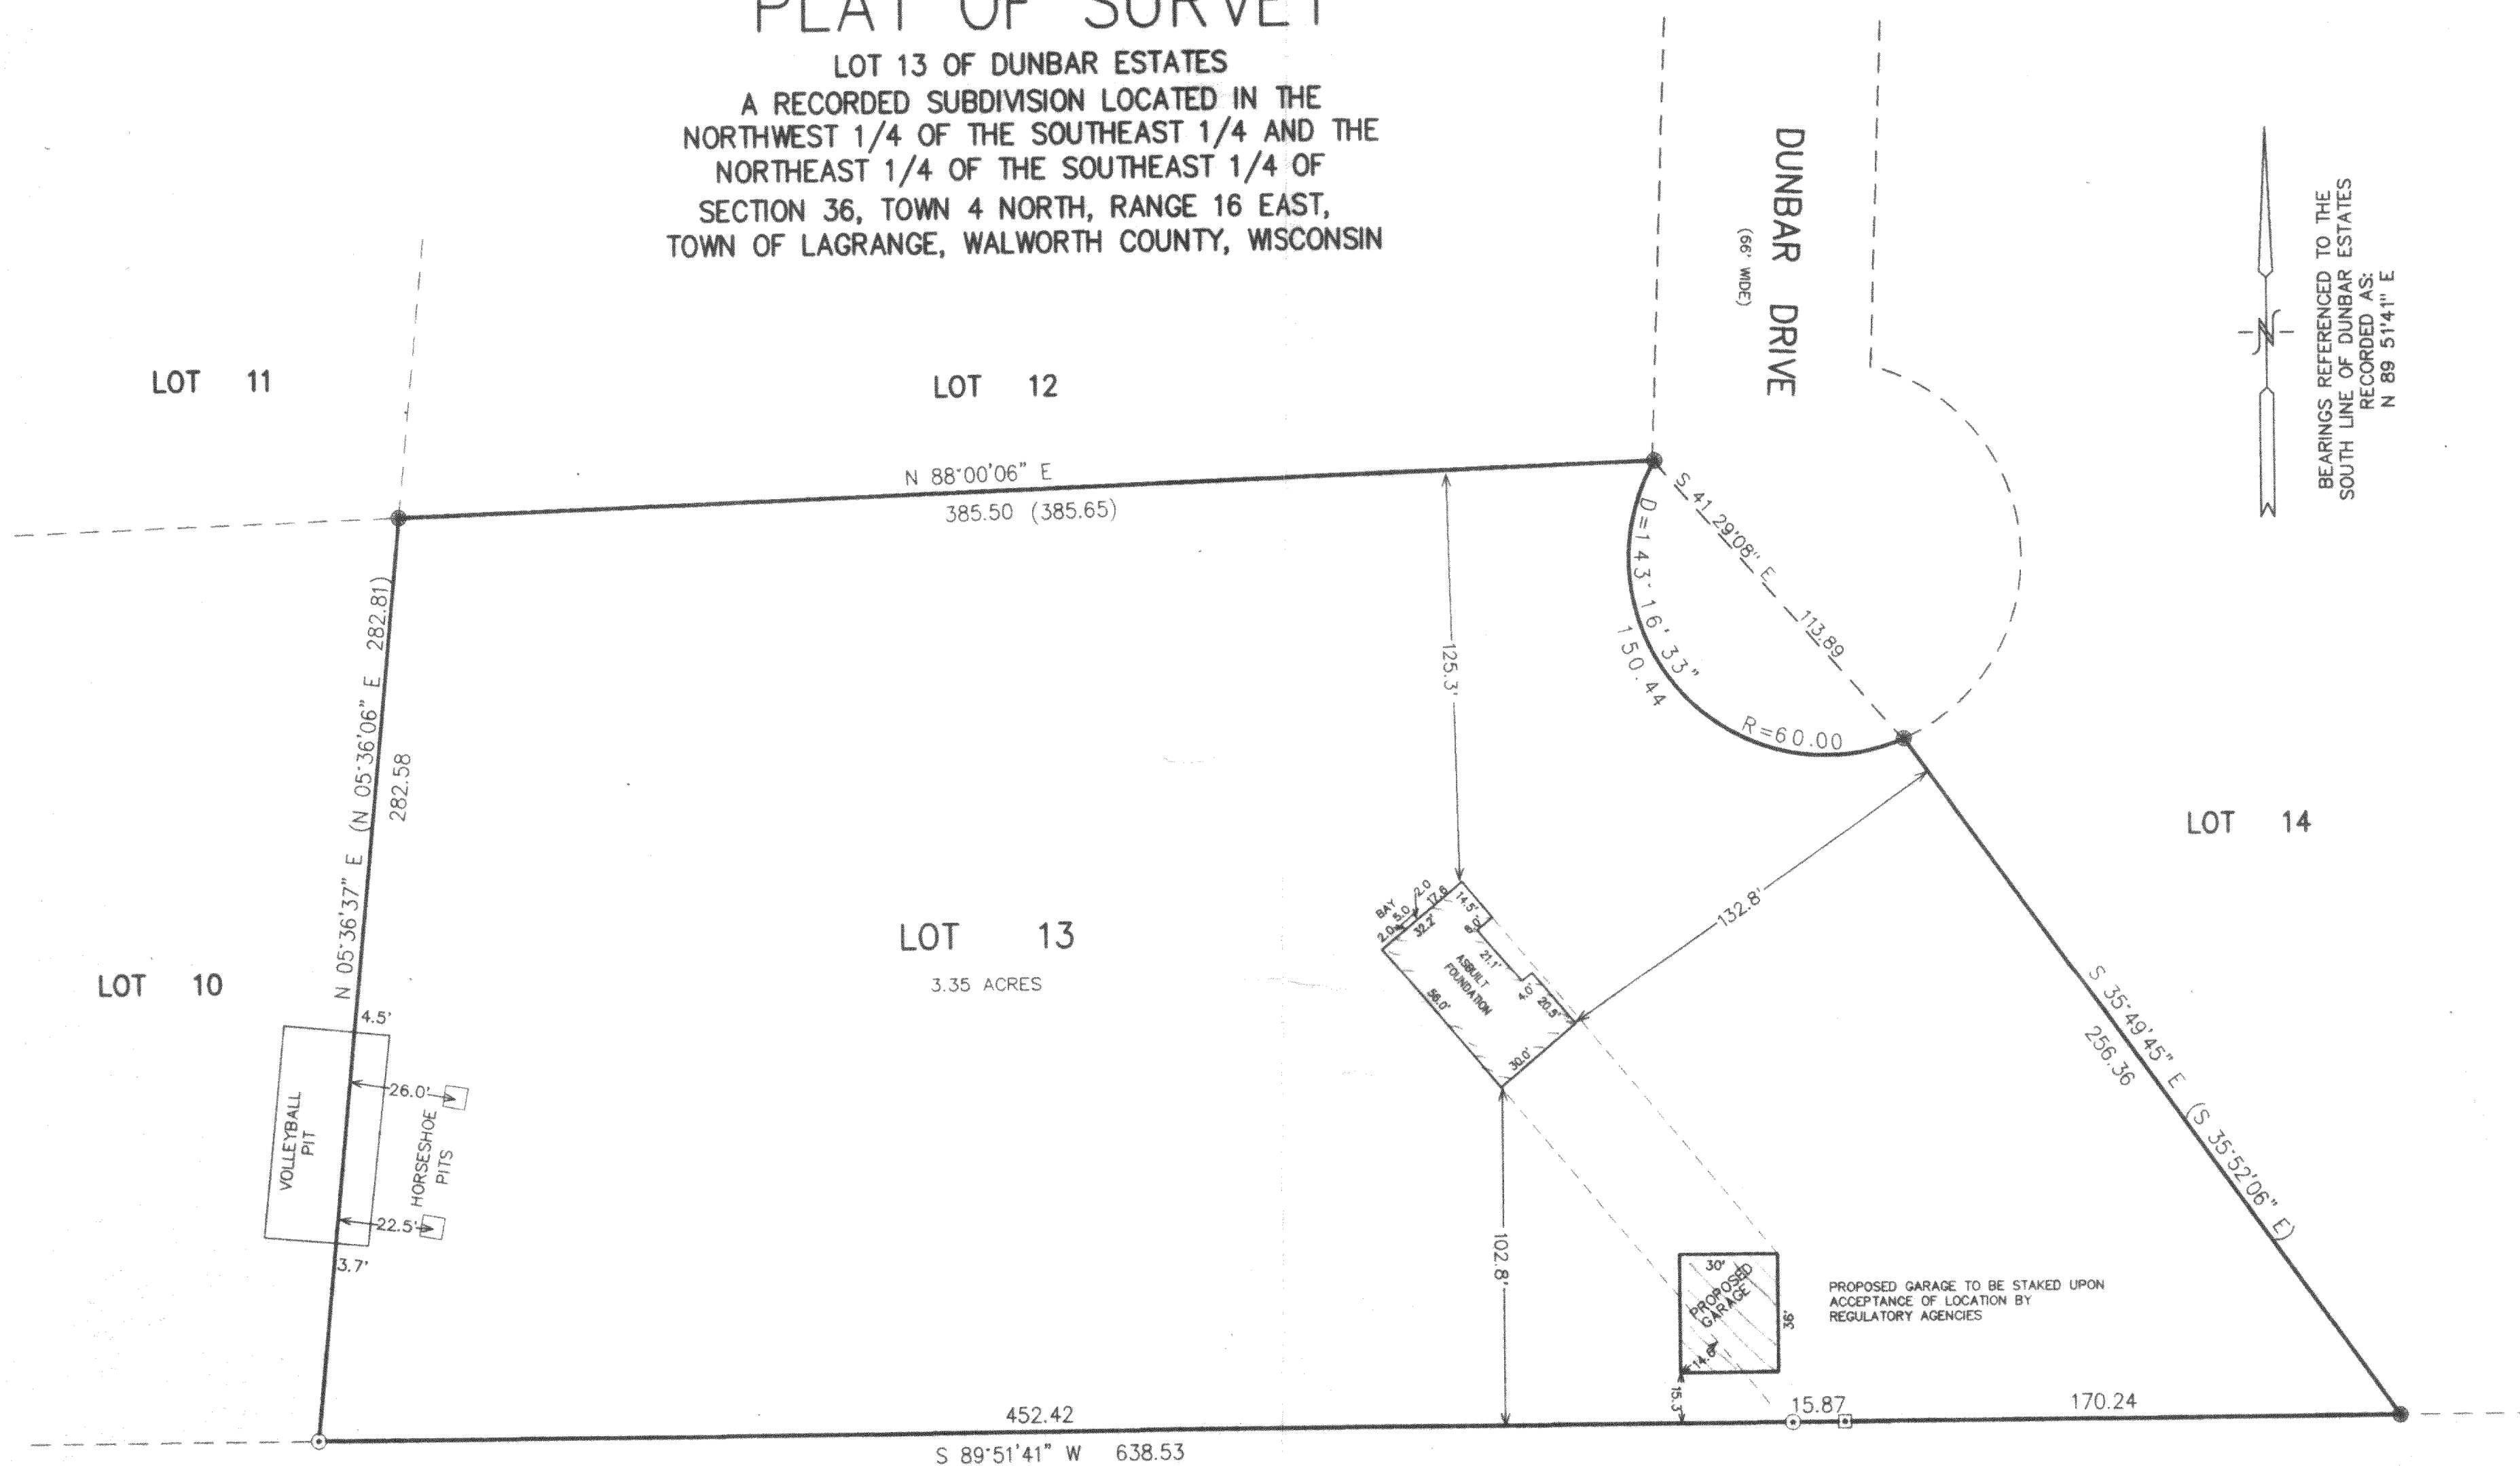

3/4" HUB RGS. AS BUILT + PROPR. GARAGE

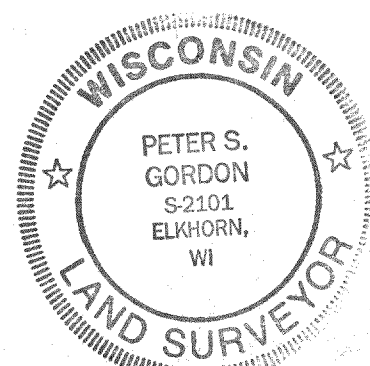

LEGEND

- ☐ FOUND CONCRETE MONUMENT
☐ FOUND IRON PIPE
☒ FOUND IRON REBAR
☐ () RECORDED AS

