


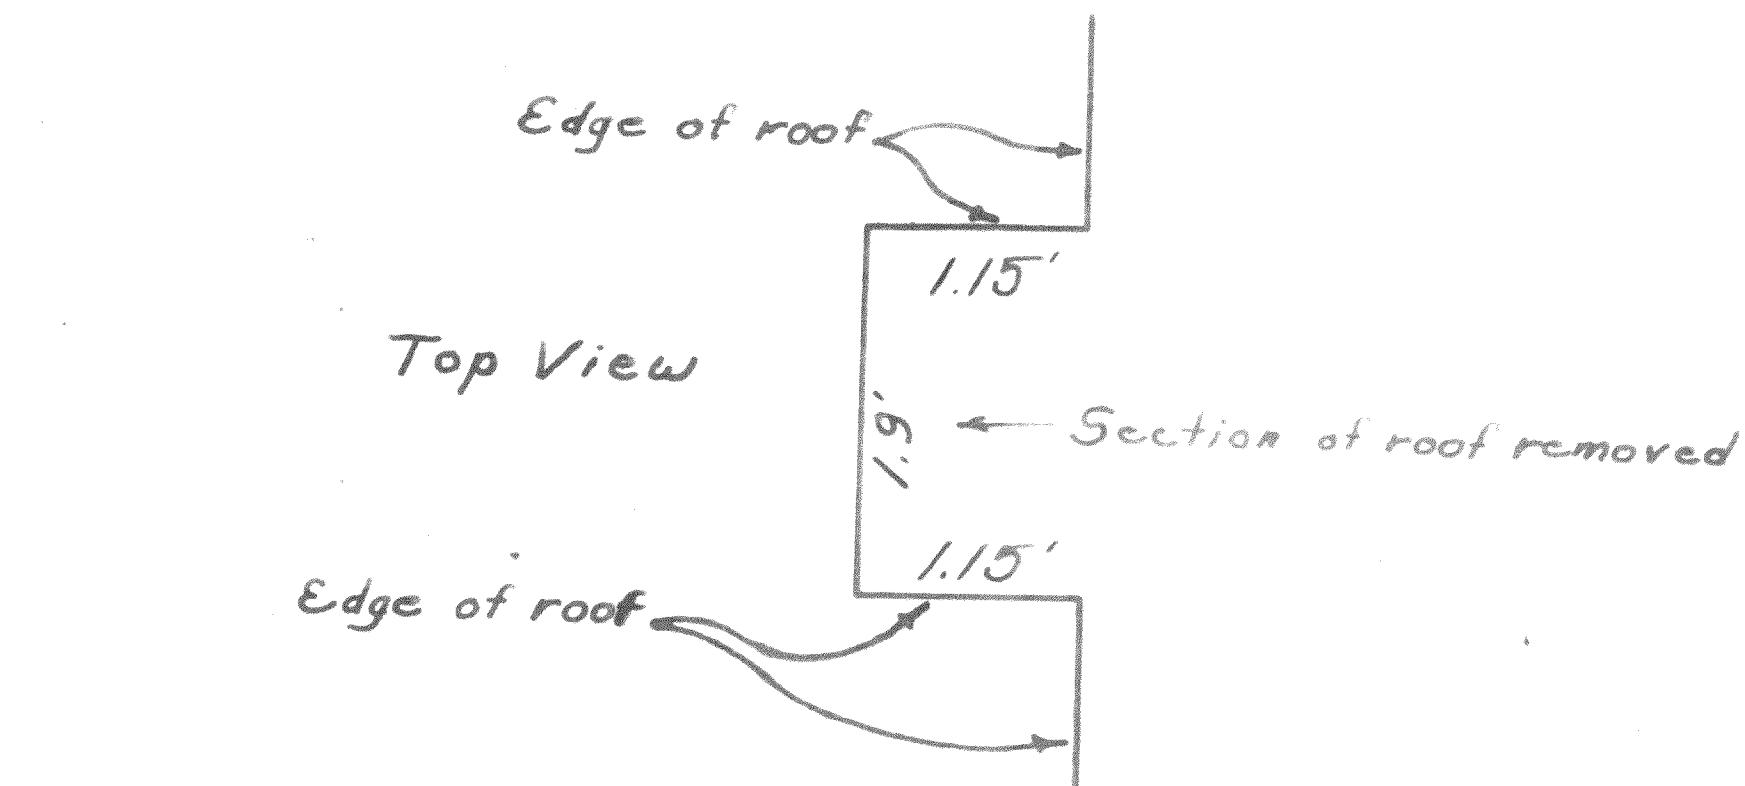

Evidence of tree rubbing
on roof at this point


Roof Line

View Looking North
Along Property Line

Scale: 1" = 1'

Plat of Survey of
Location of Tree on lots 2 & 3
Green Lake Park, a subdivision
located in Section 2, T4N, R16E,
Walworth County, Wisconsin.

Harold H. Kolb Harold H. Kolb
Wisconsin Registered Land Surveyor S-187
Date November 9, 1966

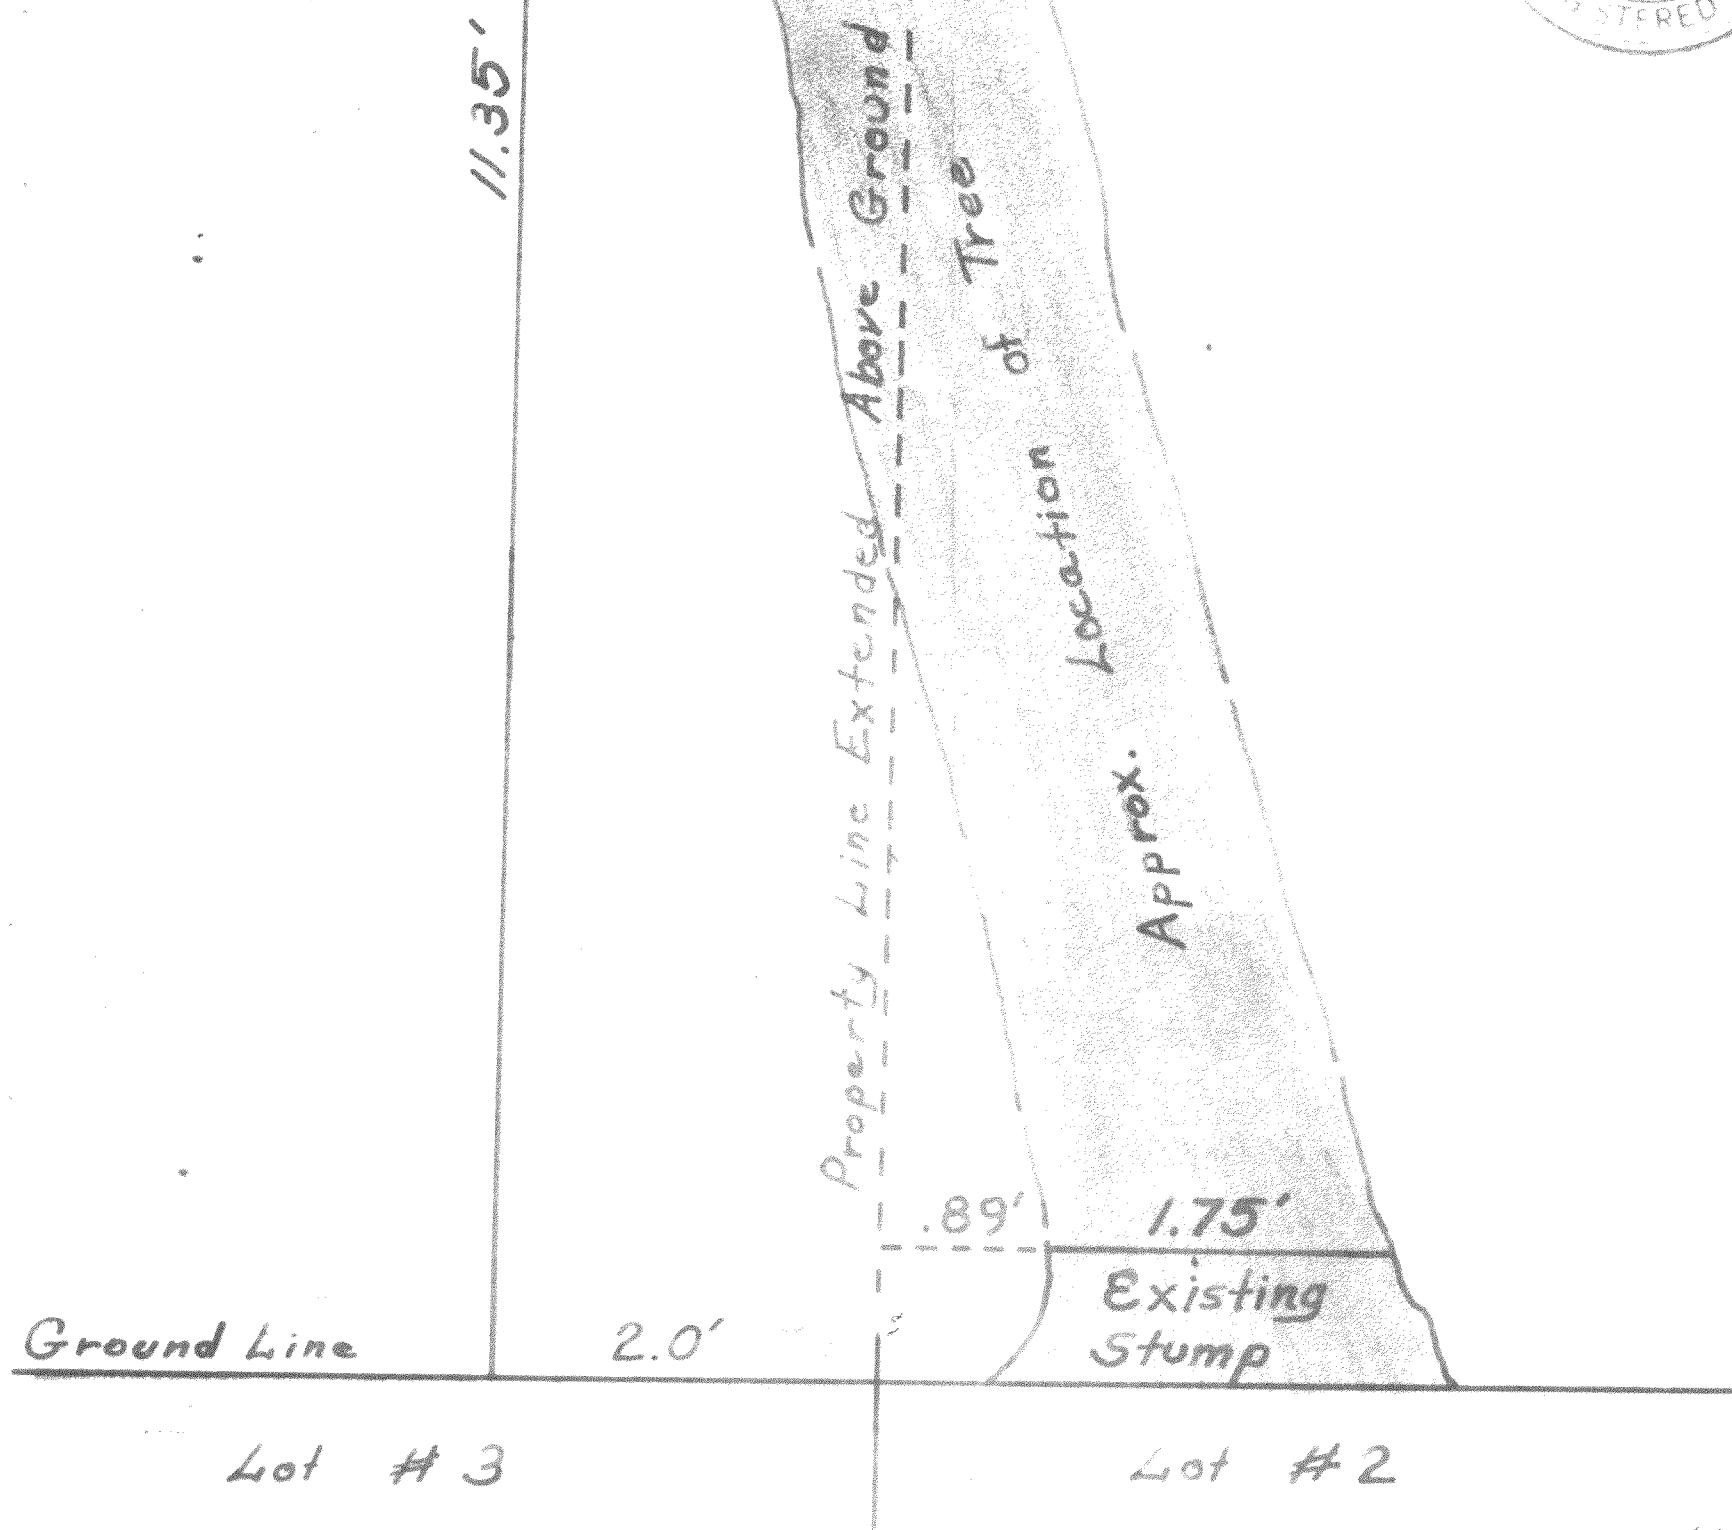

416-135

4-16-7-8-9-16