



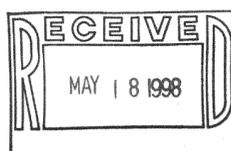


# PLAT OF SURVEY

LOT 15 & THE SOUTHERLY 10 FEET OF LOT 14  
MORRIS PARK SUBDIVISION  
LOCATED IN TOWN 4 NORTH, RANGE 16 EAST  
WALWORTH COUNTY, WISCONSIN

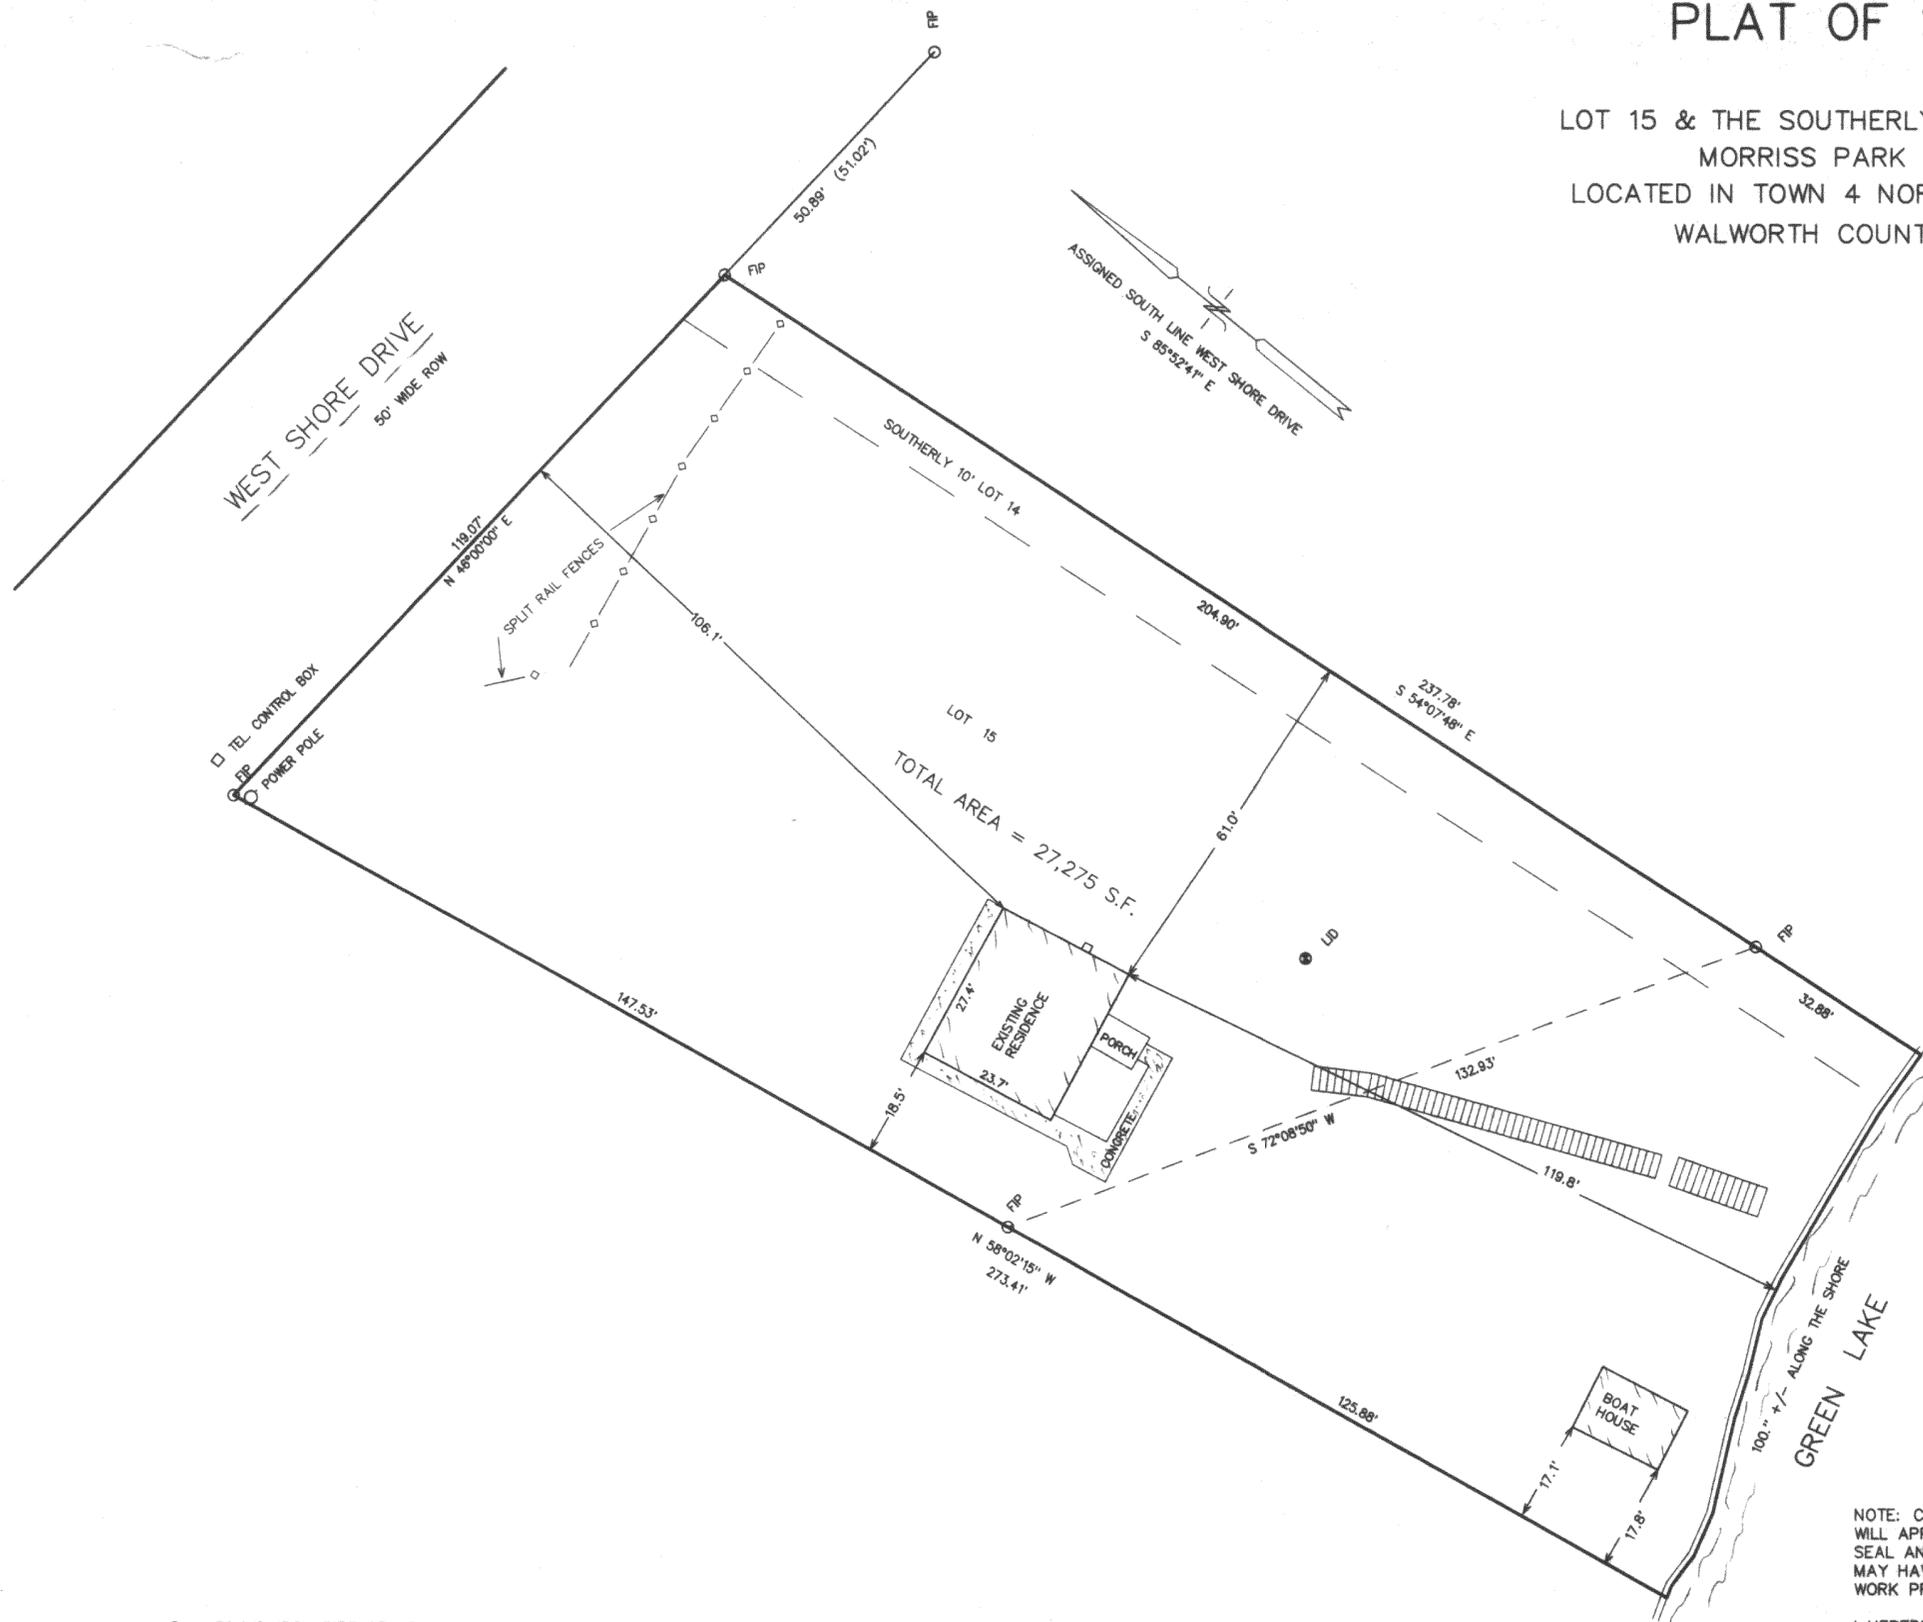


○ = FOUND IRON PIPE STAKE 1" DIA.  
( XXX ) = RECORDED AS

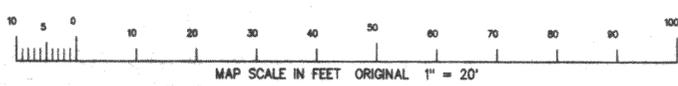

416-1359  
HMP-12

NOTE: COPIES OF THIS MAP TO WHICH THE FOLLOWING CERTIFICATE WILL APPLY ARE BLUE LINE PRINTS SHOWING SURVEYOR'S ORIGINAL SEAL AND SIGNATURE IN BLACK INK. COPIES BY ANY OTHER MEANS MAY HAVE ALTERATIONS WHICH DO NOT REPRESENT THE SURVEYOR'S WORK PRODUCT.

I HEREBY CERTIFY THAT THE ABOVE DESCRIBED PROPERTY HAS BEEN SURVEYED UNDER MY DIRECTION AND THAT THE ABOVE MAP IS A TRUE REPRESENTATION THEREOF AND SHOWS THE SIZE AND LOCATION OF THE PROPERTY AND ITS EXTERIOR BOUNDARIES. THIS SURVEY IS MADE FOR THE USE OF THE PRESENT OWNERS OF THE PROPERTY, AND ALSO THOSE WHO PURCHASE, MORTGAGE, OR GUARANTEE THE TITLE THERETO WITHIN ONE YEAR FROM THE DATE HEREOF.

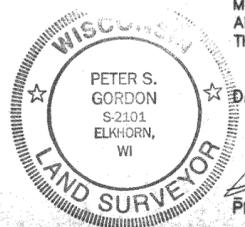

DATED: 4-19-98

PETER S. GORDON R.L.S. 2101

WORK ORDERED BY: HELEN JERUSIS  
1630 E. AVON CT.  
ARLINGTON HEIGHTS, IL. 60004

FARRIS, HANSEN & ASSOCIATES, INC.  
Engineering, Architecture, Surveying  
7 Ridgway Court P.O. Box 437  
ELKHORN, WISCONSIN 53121  
Office: (414) 723-2098  
Fax: (414) 723-5886

REVISIONS

PROJECT NO.  
4976  
DATE:  
04-20-98  
SHEET NO.  
1 OF 1