


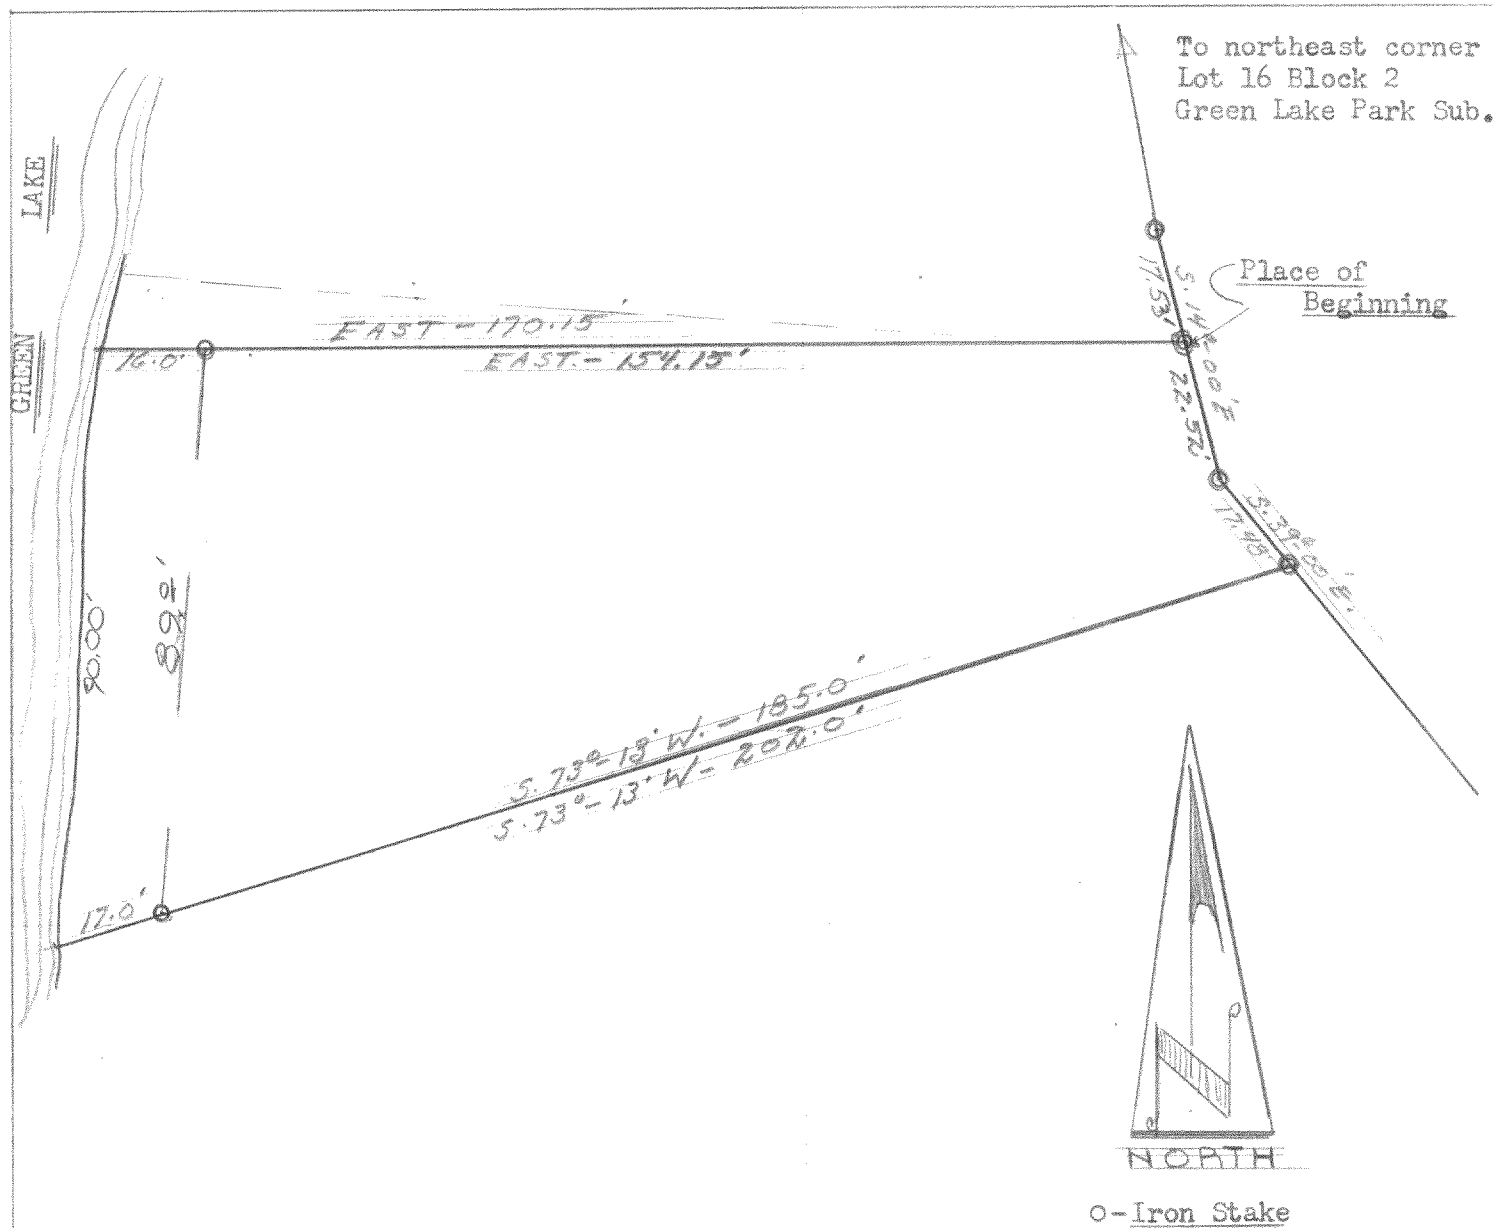


DESCRIPTION:

Commencing at the northeast corner of Lot 16 Block 2 Green Lake Park a subdivision of a portion of Section 26 Town 4 north Range 16 east, Walworth County, Wisconsin, thence S. 4° 30' W., 169.64 feet to a point, thence S. 10° 30' E., 35.00 feet to a point, thence S. 14° 00' E., 17.53 feet to an iron stake, the place of beginning of this description; thence continue S. 14° 00' E., 22.52 feet to an iron stake, thence S. 39° 00' E., 17.48 feet to an iron stake, thence S. 73° 13' W., 185.00 feet to an iron stake, thence S. 73° 13' W., to a point in the shore of Green Lake, thence northeasterly along the shore of Green Lake, 90.00 feet more or less to a point that is West 170.15 feet of the place of beginning, thence East 16.00 feet to an iron stake, and continue East 154.15 feet to the place of beginning.

CERTIFICATE:

I, James F. Biagi, hereby certify that I have on this the 2nd day of August, 1965 surveyed the above described property.

Dated: August 3rd 1965.

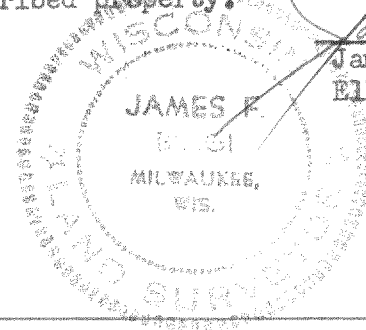

James F. Biagi, RLS 272
Elkhorn, Wisconsin.

HGP-18D1

416-137B