


ABELL SURVEYING & MAPPING

1140 SEQUOIA STREET • DELAVAN, WISCONSIN 53115
414-728-6737

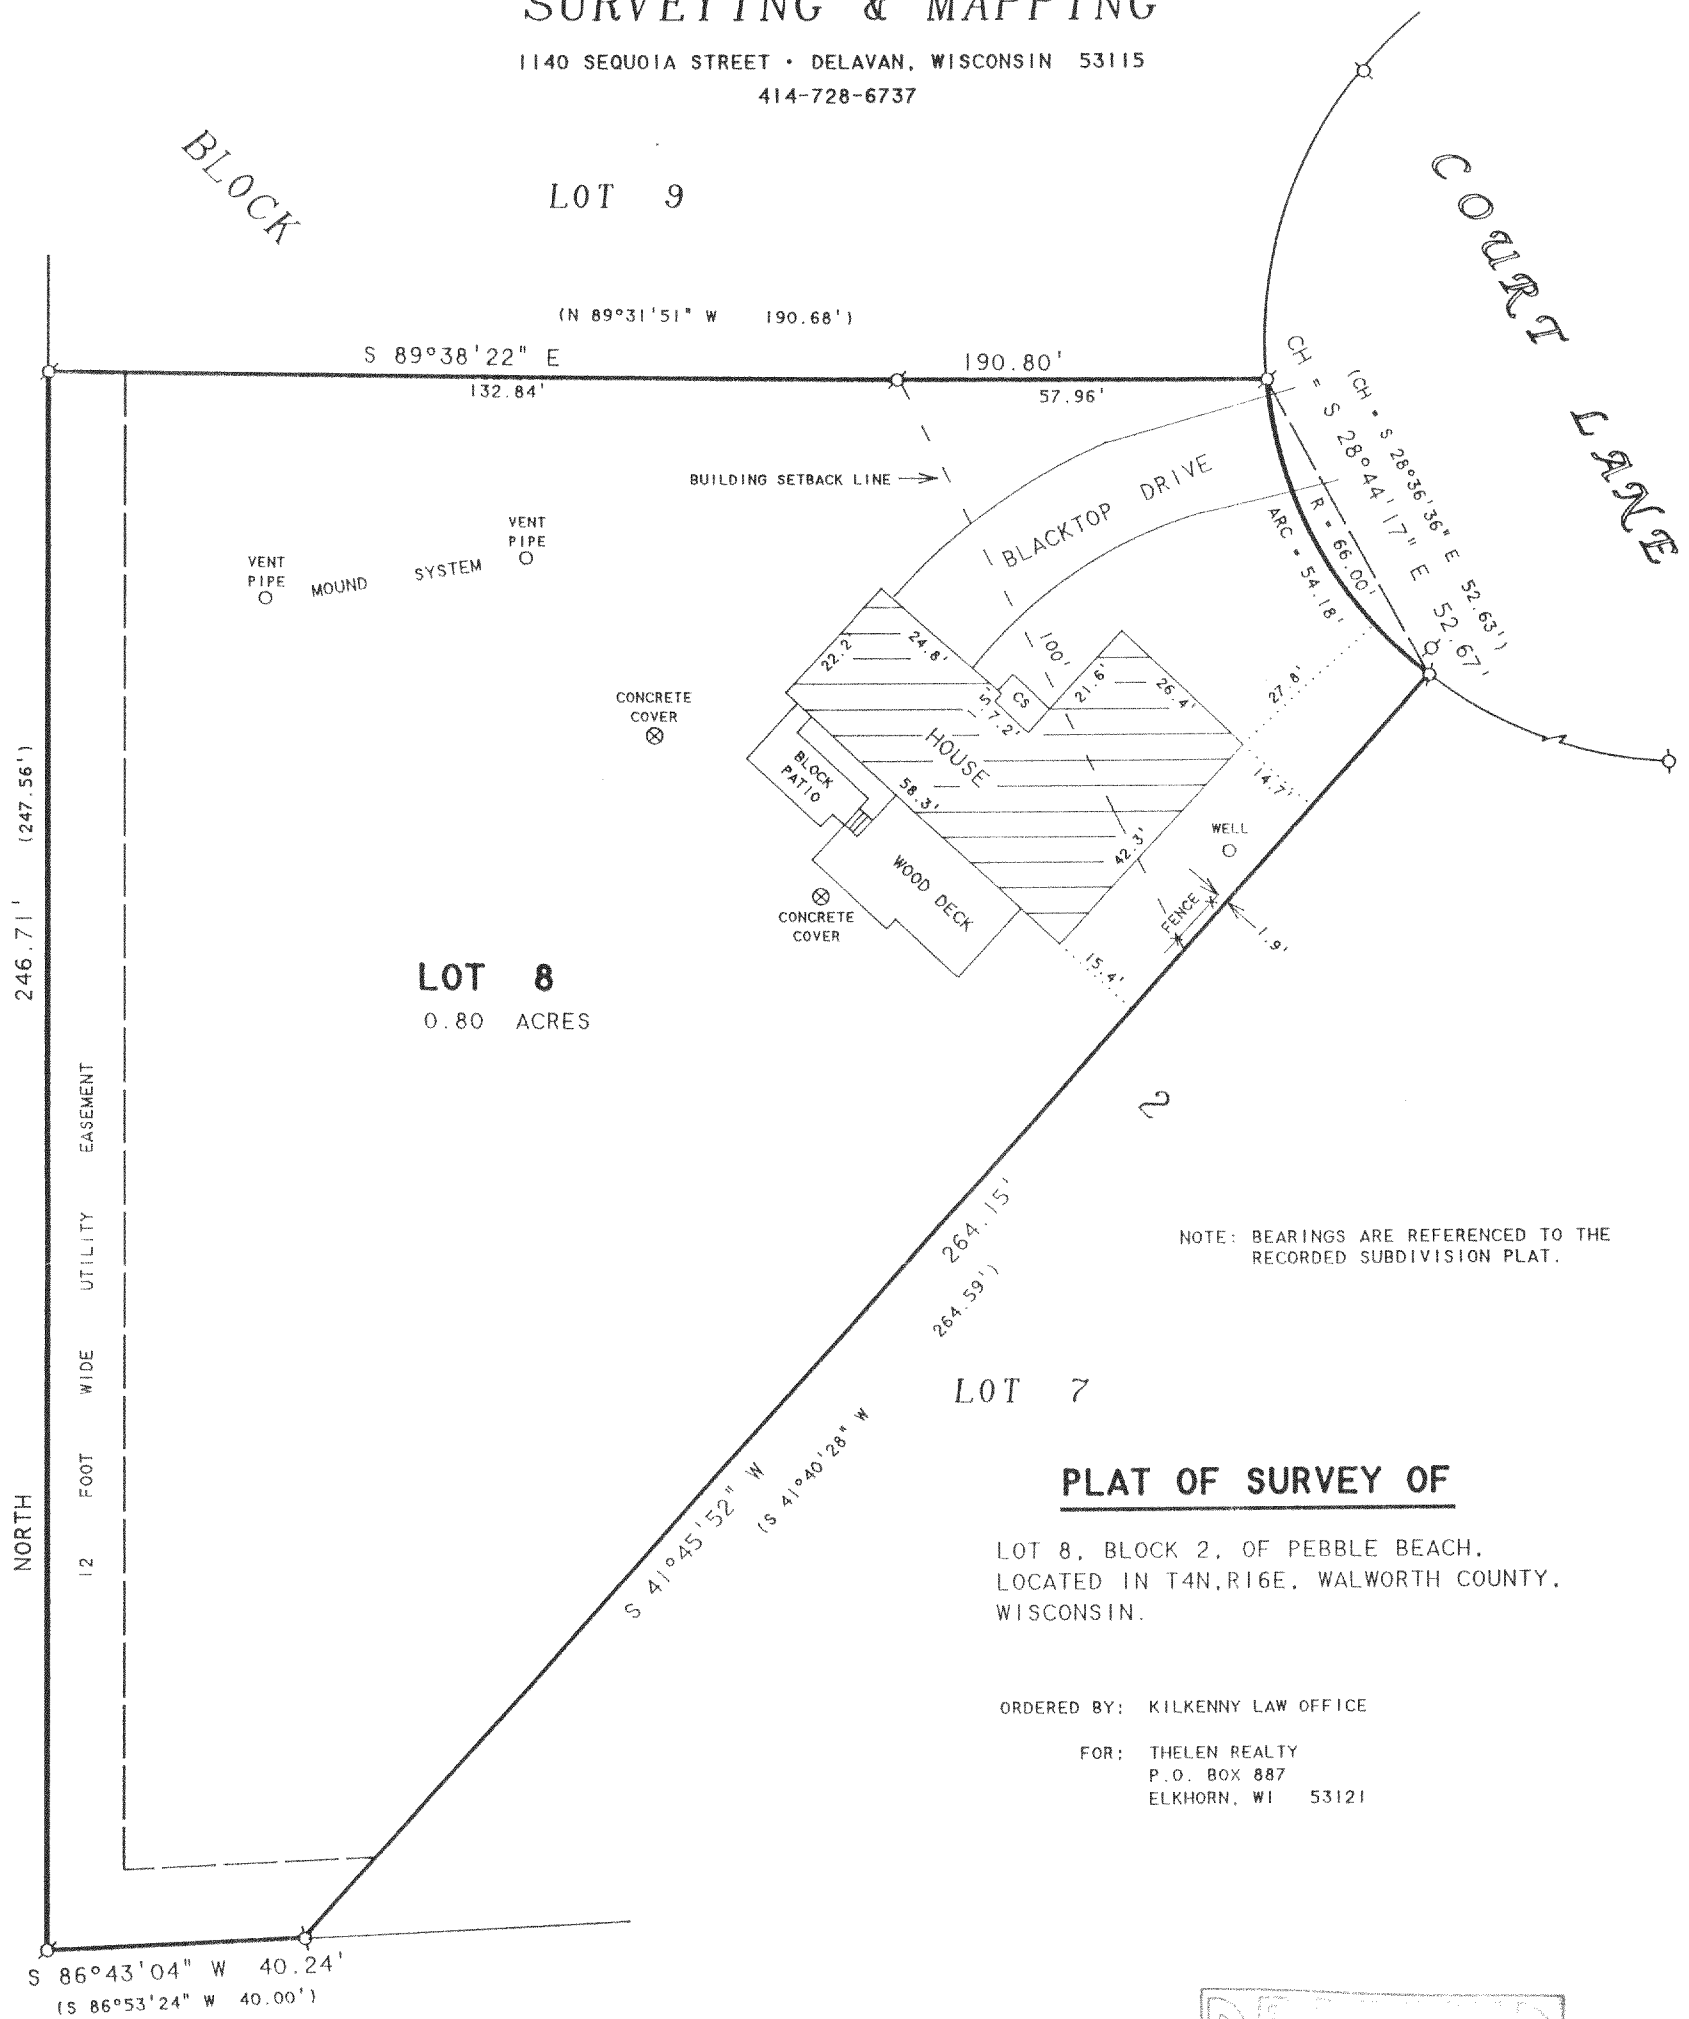


PLAT OF SURVEY OF

LOT 8, BLOCK 2, OF PEBBLE BEACH,
LOCATED IN T4N, R16E, WALWORTH COUNTY,
WISCONSIN.

ORDERED BY: KILKENNY LAW OFFICE

FOR: THELEN REALTY
P.O. BOX 887
ELKHORN, WI 53121

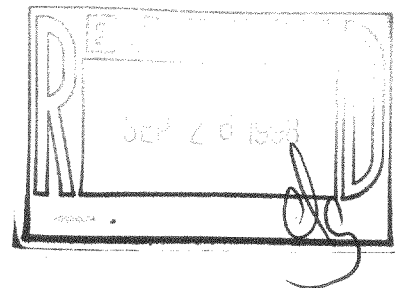

N



SCALE 1"=30'

LEGEND

- ⊙ - IRON PIPE FOUND
- CS - CONCRETE STOOP
- () - RECORDED AS

I HEREBY CERTIFY THAT I HAVE SURVEYED THE ABOVE DESCRIBED PROPERTY AND THAT THE ABOVE MAP IS A TRUE REPRESENTATION THEREOF AND SHOWS THE SIZE AND LOCATION OF THE PROPERTY, ITS EXTERIOR BOUNDARIES, THE LOCATION OF ALL VISIBLE STRUCTURES AND DIMENSIONS OF ALL PRINCIPAL BUILDINGS THEREON, BOUNDARY FENCES, APPARENT EASEMENTS, ROADWAYS AND VISIBLE ENCROACHMENTS, IF ANY, TO THE BEST OF MY KNOWLEDGE AND BELIEF.

THIS SURVEY IS MADE FOR THE USE OF THE PRESENT OWNERS OF THE PROPERTY, AND ALSO THOSE WHO PURCHASE, MORTGAGE, OR GUARANTEE THE TITLE THERETO WITHIN ONE (1) YEAR FROM DATE HEREON.

David F. Abell

DAVID F. ABELL
WISCONSIN REGISTERED LAND SURVEYOR, S-1596

September 7, 1998

DATE: _____ JOB NUMBER - 98165
NOTE: THIS IS NOT A CERTIFIED COPY UNLESS SEALED.

416-1384
HPE-31