


PLAT OF SURVEY

DESCRIPTION: LOT 26 AND 27, BLOCK 2, OF PEBBLE BEACH SUBDIVISION, LOCATED IN THE NORTHEAST 1/4 OF SECTION 26, AND THE NORTHWEST 1/4 OF SECTION 25, T.4.N., R.16.E., WALWORTH COUNTY, WISCONSIN.

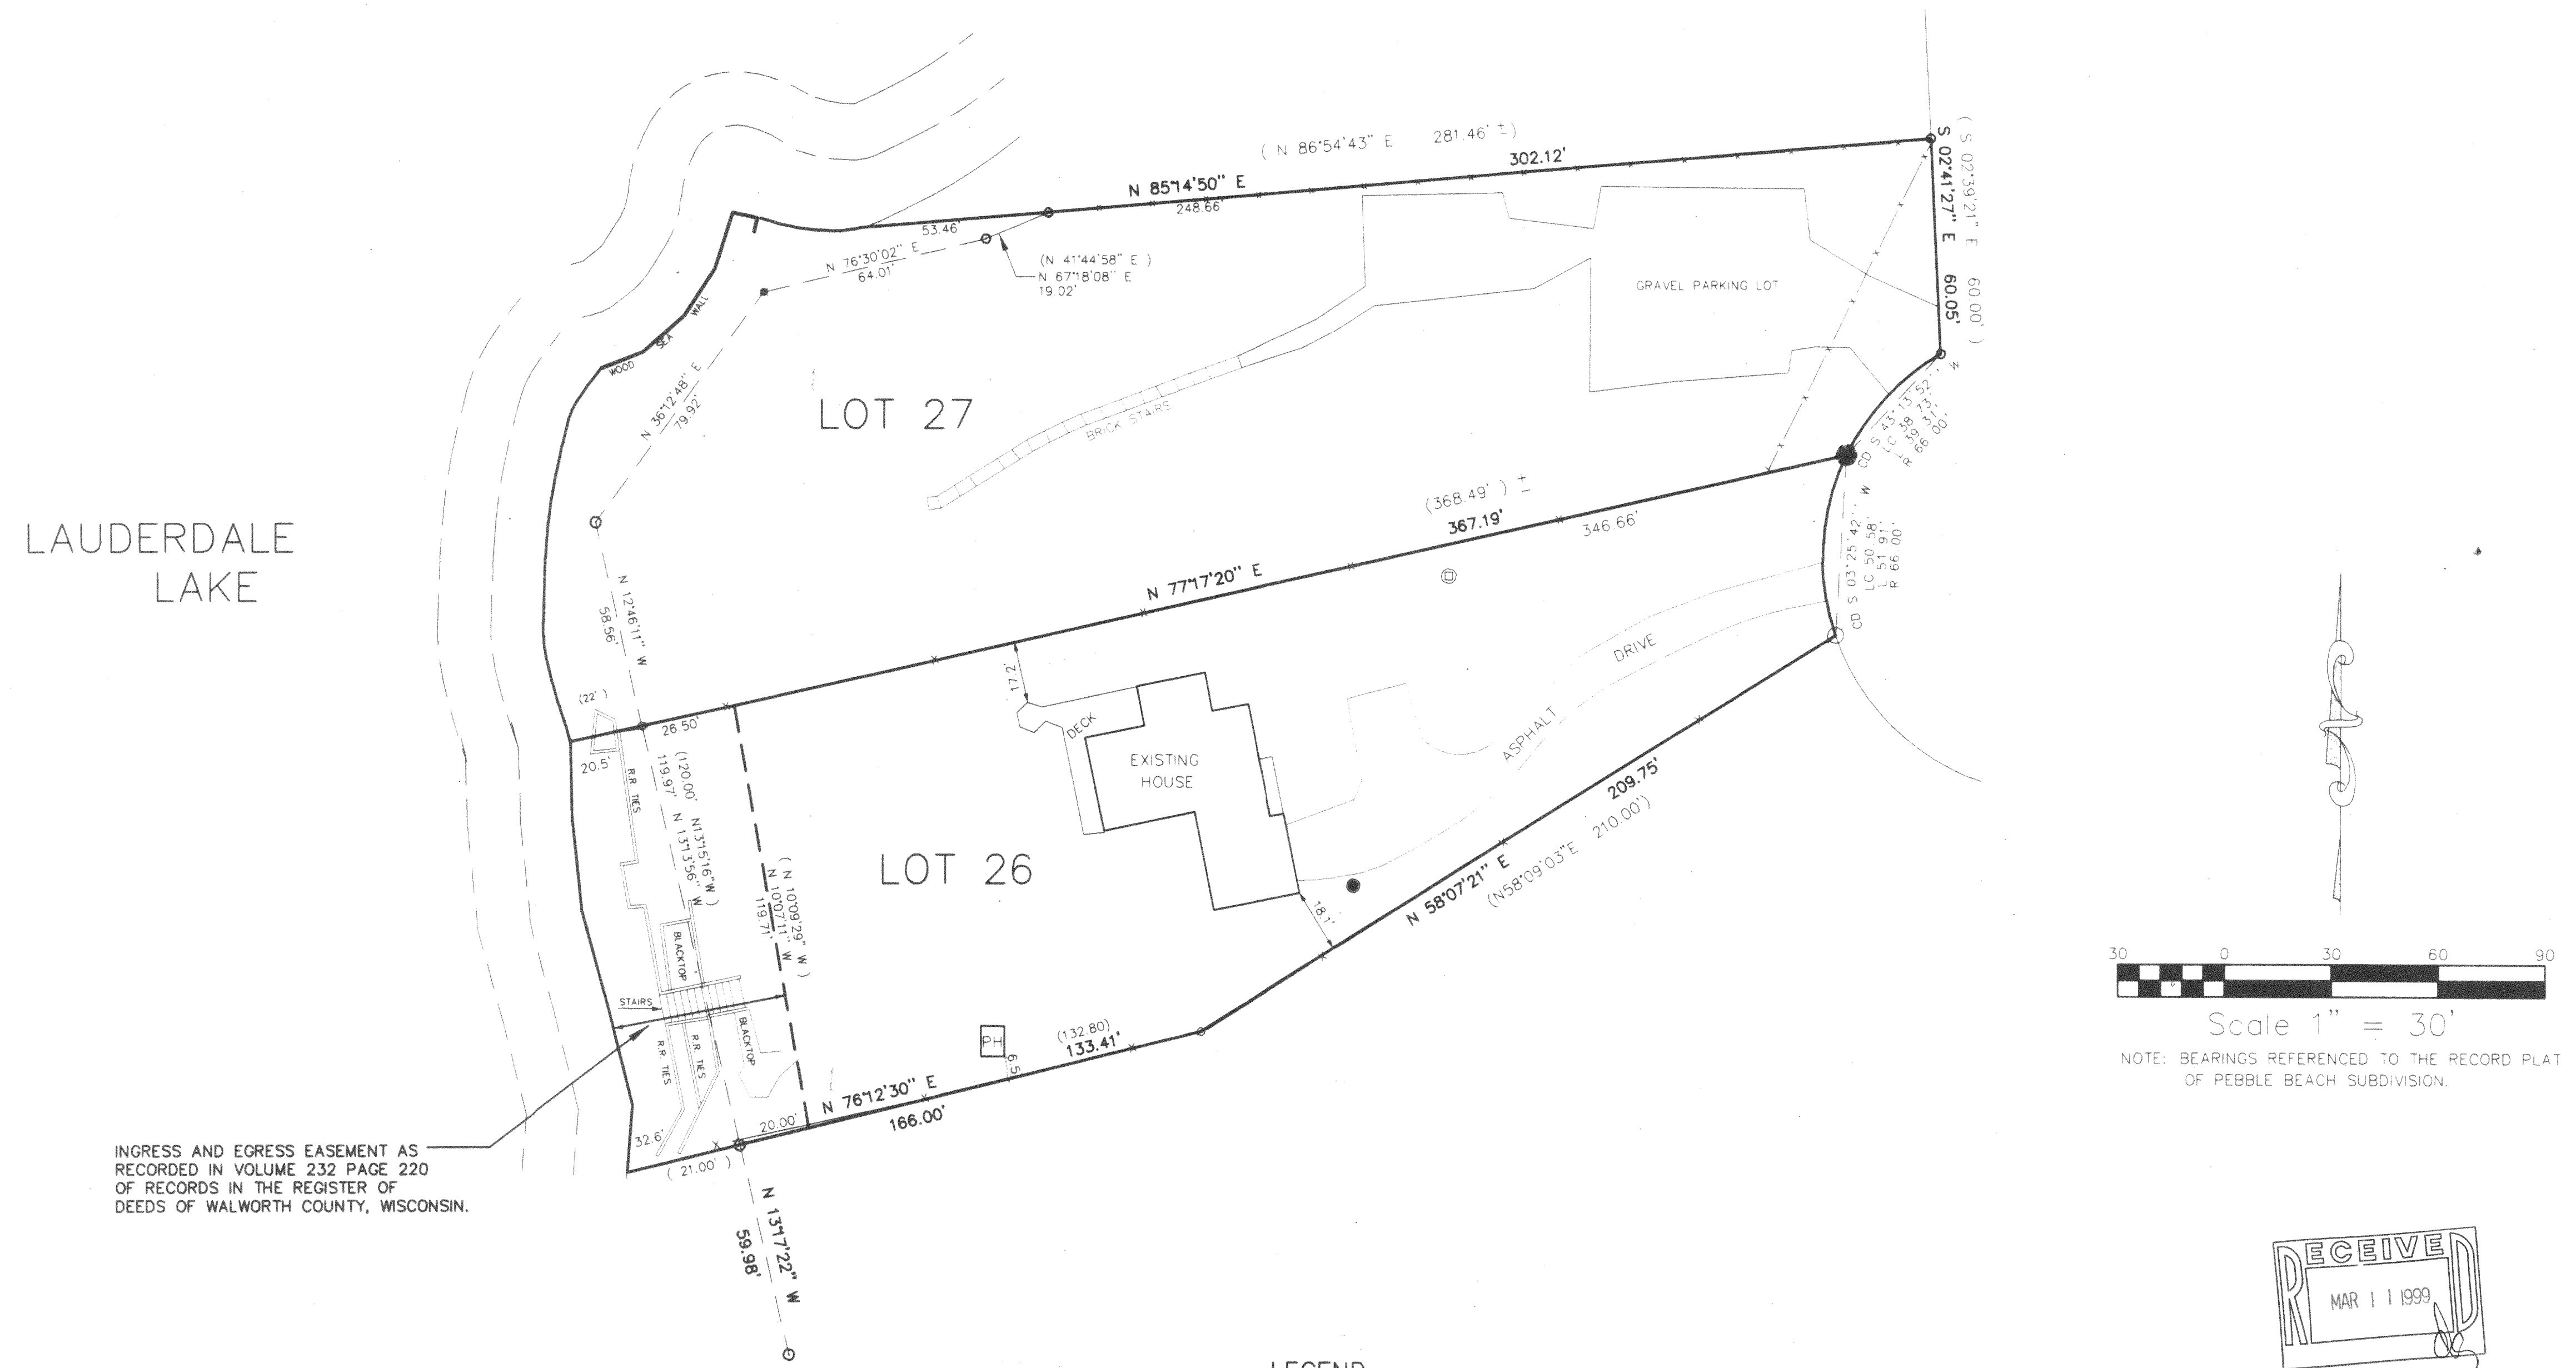

ORDERED BY:

GODFREY, NESHEK, WORTH, LEIBSLE & CONOVER, S.C.
11 NORTH WISCONSIN STREET P.O. BOX 260
ELKHORN, WI 53121

PATHFINDER SURVEYING


929 WILLIAMS STREET, LAKE GENEVA WISCONSIN 53147

(414) 248-3697

THE ABOVE MAP IS A TRUE REPRESENTATION THEREOF AND SHOWS THE SIZE AND LOCATION OF ALL THE PROPERTY, EXTERIOR BOUNDARIES, THE LOCATION OF ALL VISIBLE BOUNDARY FENCES, APPARENT EASEMENTS, ROADWAYS AND VISIBLE ENCROACHMENTS, IF ANY.

THIS SURVEY IS MADE FOR THE USE OF THE PRESENT OWNERS OF THE PROPERTY, AND ALSO THOSE WHO PURCHASE, MORTGAGE OR GUARANTEE TITLE THERETO WITHIN ONE (1) YEAR FROM DATE HERETO.

John P. Krott
JOHN P. KROTT, R.L.S. 2258

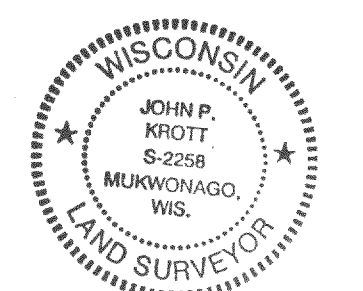

DATE: 12 / 17 / 1998

JOB NUMBER: 98013 4-16-HPE00049

416-1415