


HAROLD H. KOLB
REGISTERED PROFESSIONAL LAND SURVEYOR
LAKE GENEVA, WISCONSIN

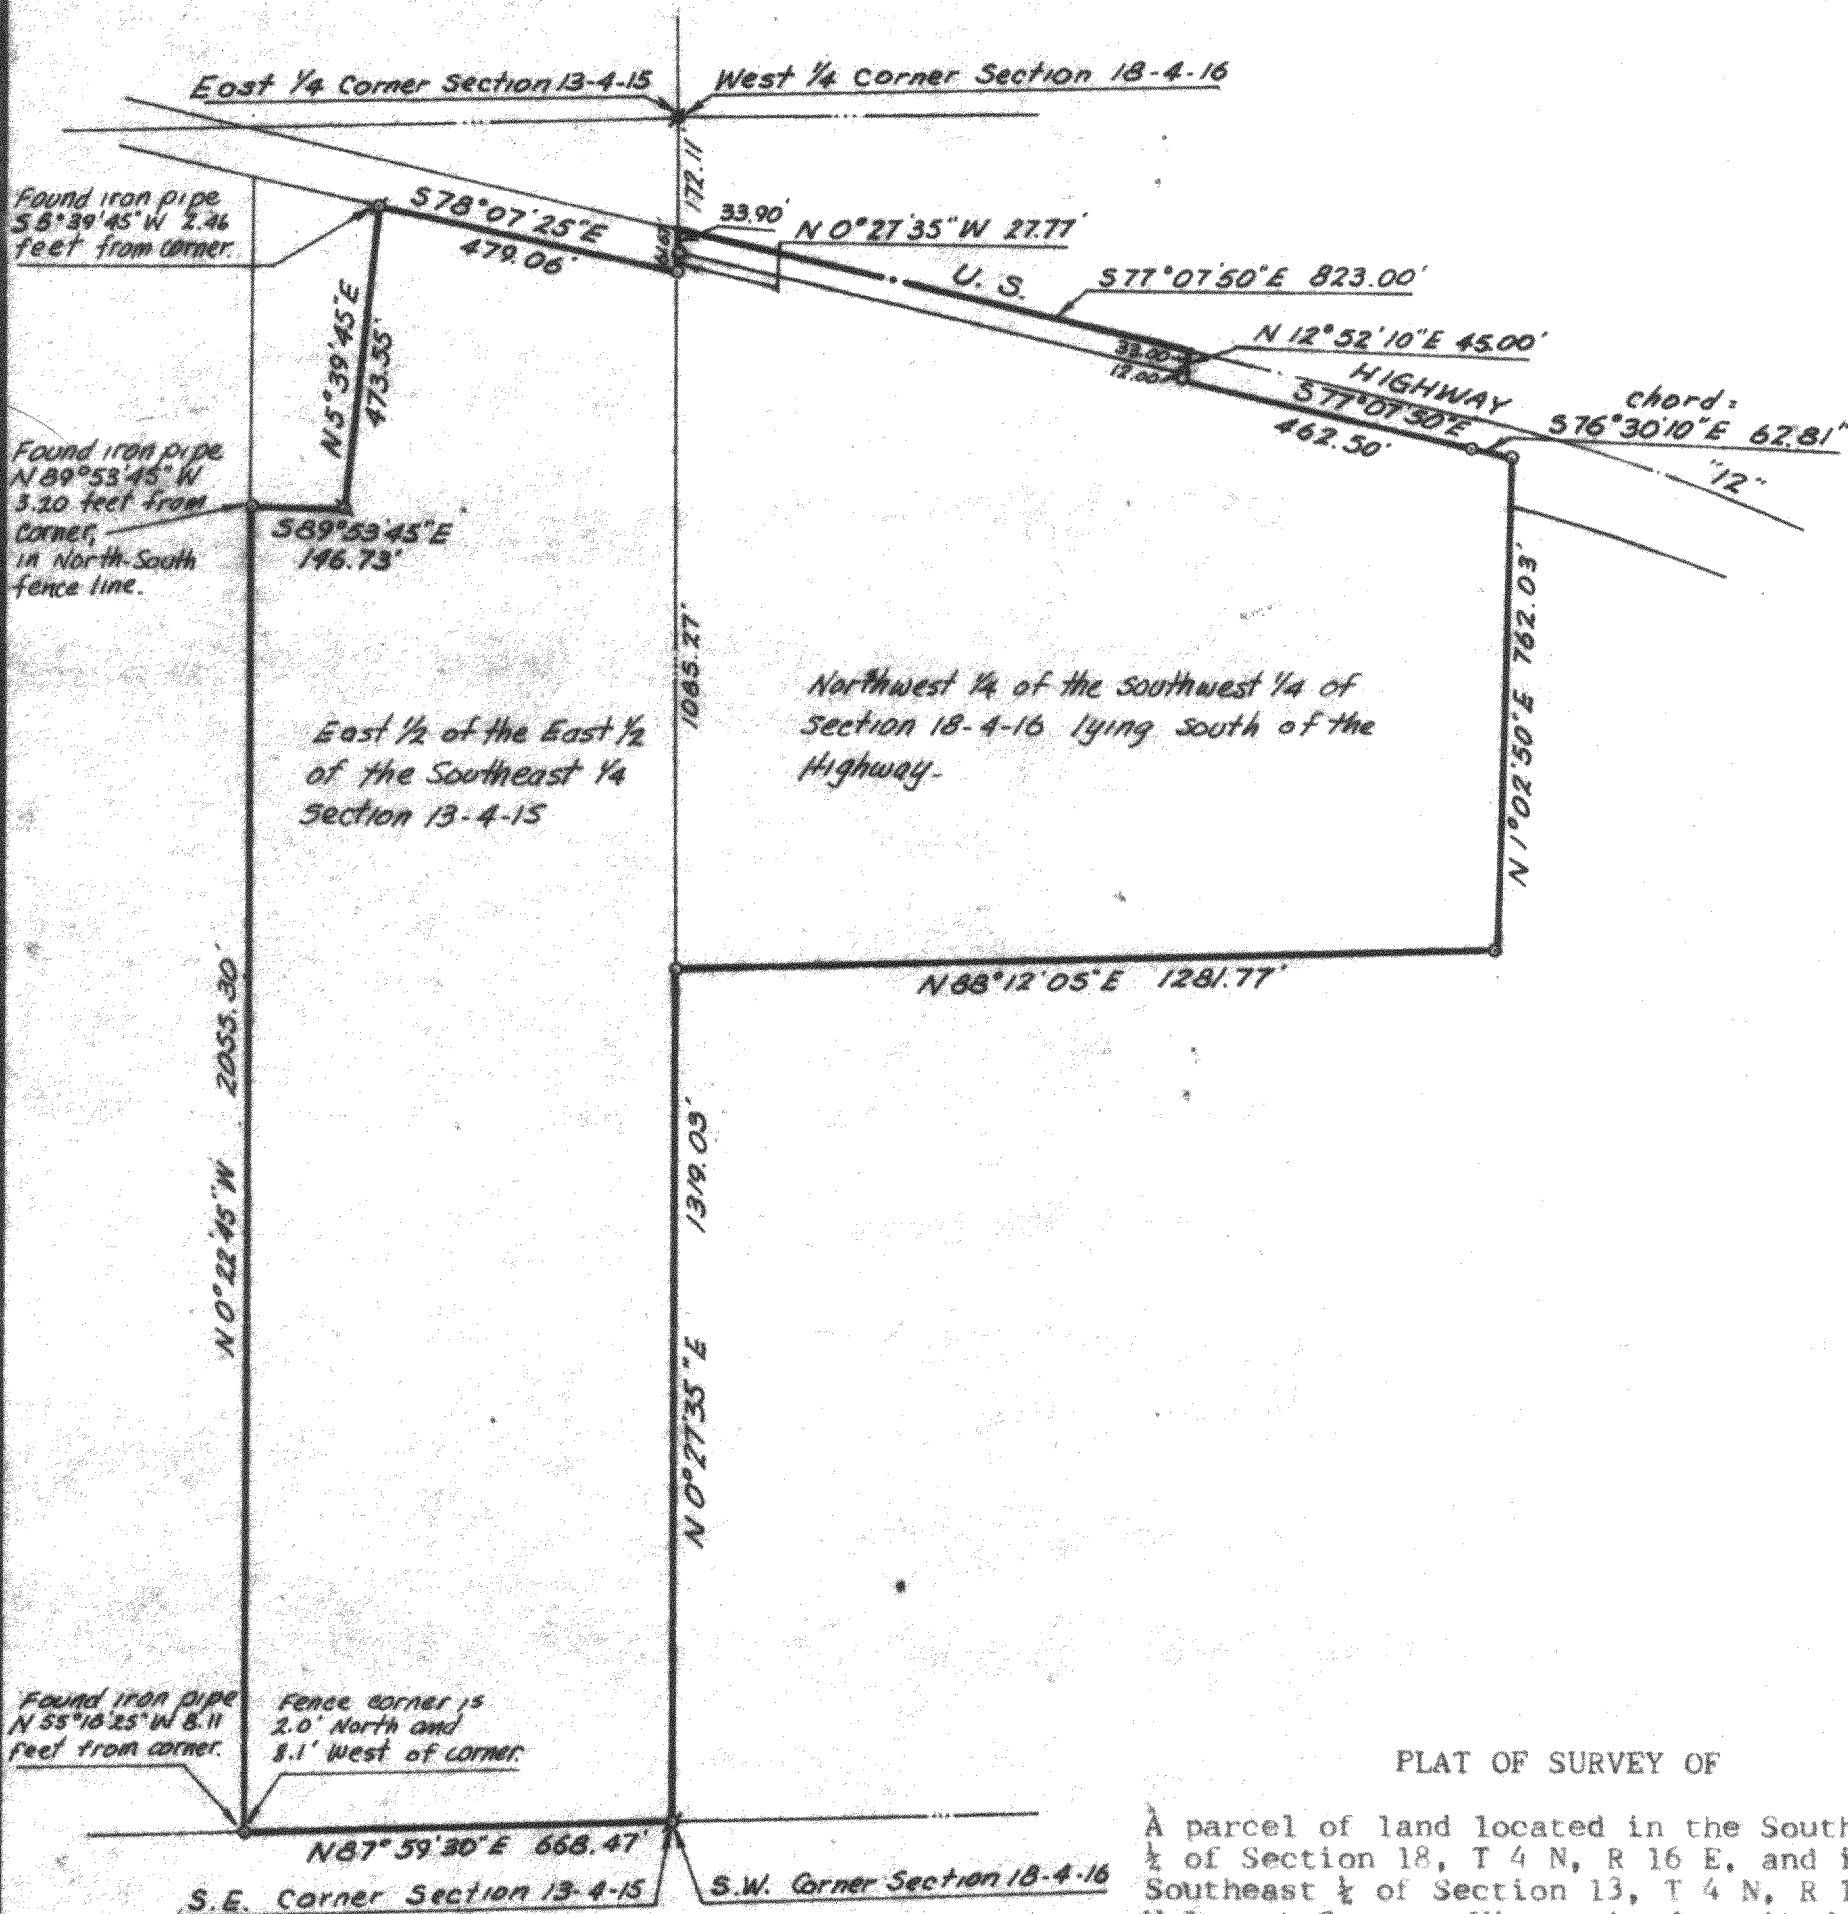

PLAT OF SURVEY OF

A parcel of land located in the Southwest 1/4 of Section 18, T 4 N, R 16 E, and in the Southeast 1/4 of Section 13, T 4 N, R 15 E, Walworth County, Wisconsin described as

follows: Commencing at the West 1/4 corner of said Section 18; thence S 0° 27' 35" W 172.11 feet to the centerline of U.S. Highway 12 and the place of beginning; thence S 77° 07' 50" E 823.00 feet along said centerline; thence S 12° 52' 10" W 45.00 feet to the Southerly right-of-way line of U.S. Highway 12; thence S 77° 07' 50" E 462.50 feet; thence along the arc of a curve to the right, the radius being 2864.90 feet and the chord bearing S 76° 30' 10" E 62.81 feet; thence S 1° 02' 50" W 762.03 feet; thence S 88° 12' 05" W 1281.77 feet; thence S 0° 27' 35" W 1319.03 feet; thence S 87° 59' 30" W 668.47 feet; thence N 0° 22' 45" W 2055.30 feet; thence S 89° 53' 45" E 146.73 feet; thence N 5° 39' 45" E 473.55 feet to the Southerly right-of-way line of U.S. Highway 12; thence S 78° 07' 25" E 479.06 feet; thence N 0° 27' 35" W 61.67 feet to the place of beginning. Containing 64.58 acres.


NOTE: The bearing on the West line of Section 18 is assumed.



Scale: 1" = 300'

LEGEND

- — IRON PIPE FOUND
- — IRON PIPE PLACED
- — CONCRETE MONUMENT
- X — SPIKE

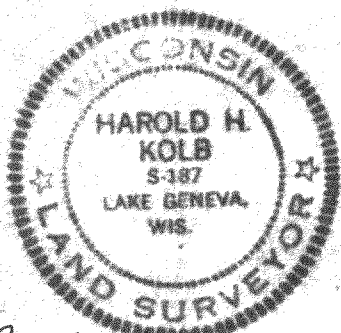

I, HAROLD H. KOLB, DO HEREBY CERTIFY THAT I HAVE SURVEYED THE PROPERTY HEREON DESCRIBED ACCORDING TO THE OFFICIAL RECORDS, AND THAT THE PLAT HEREON IS A CORRECT REPRESENTATION OF THE LOT LINES.

Harold H. Kolb
HAROLD H. KOLB

WISCONSIN REGISTERED LAND SURVEYOR, S-187
DATE May 30, 1973

LG-13-8
LG-18-5
H618-5B + D613-8B
48B-4-15

416-143