


#143-69

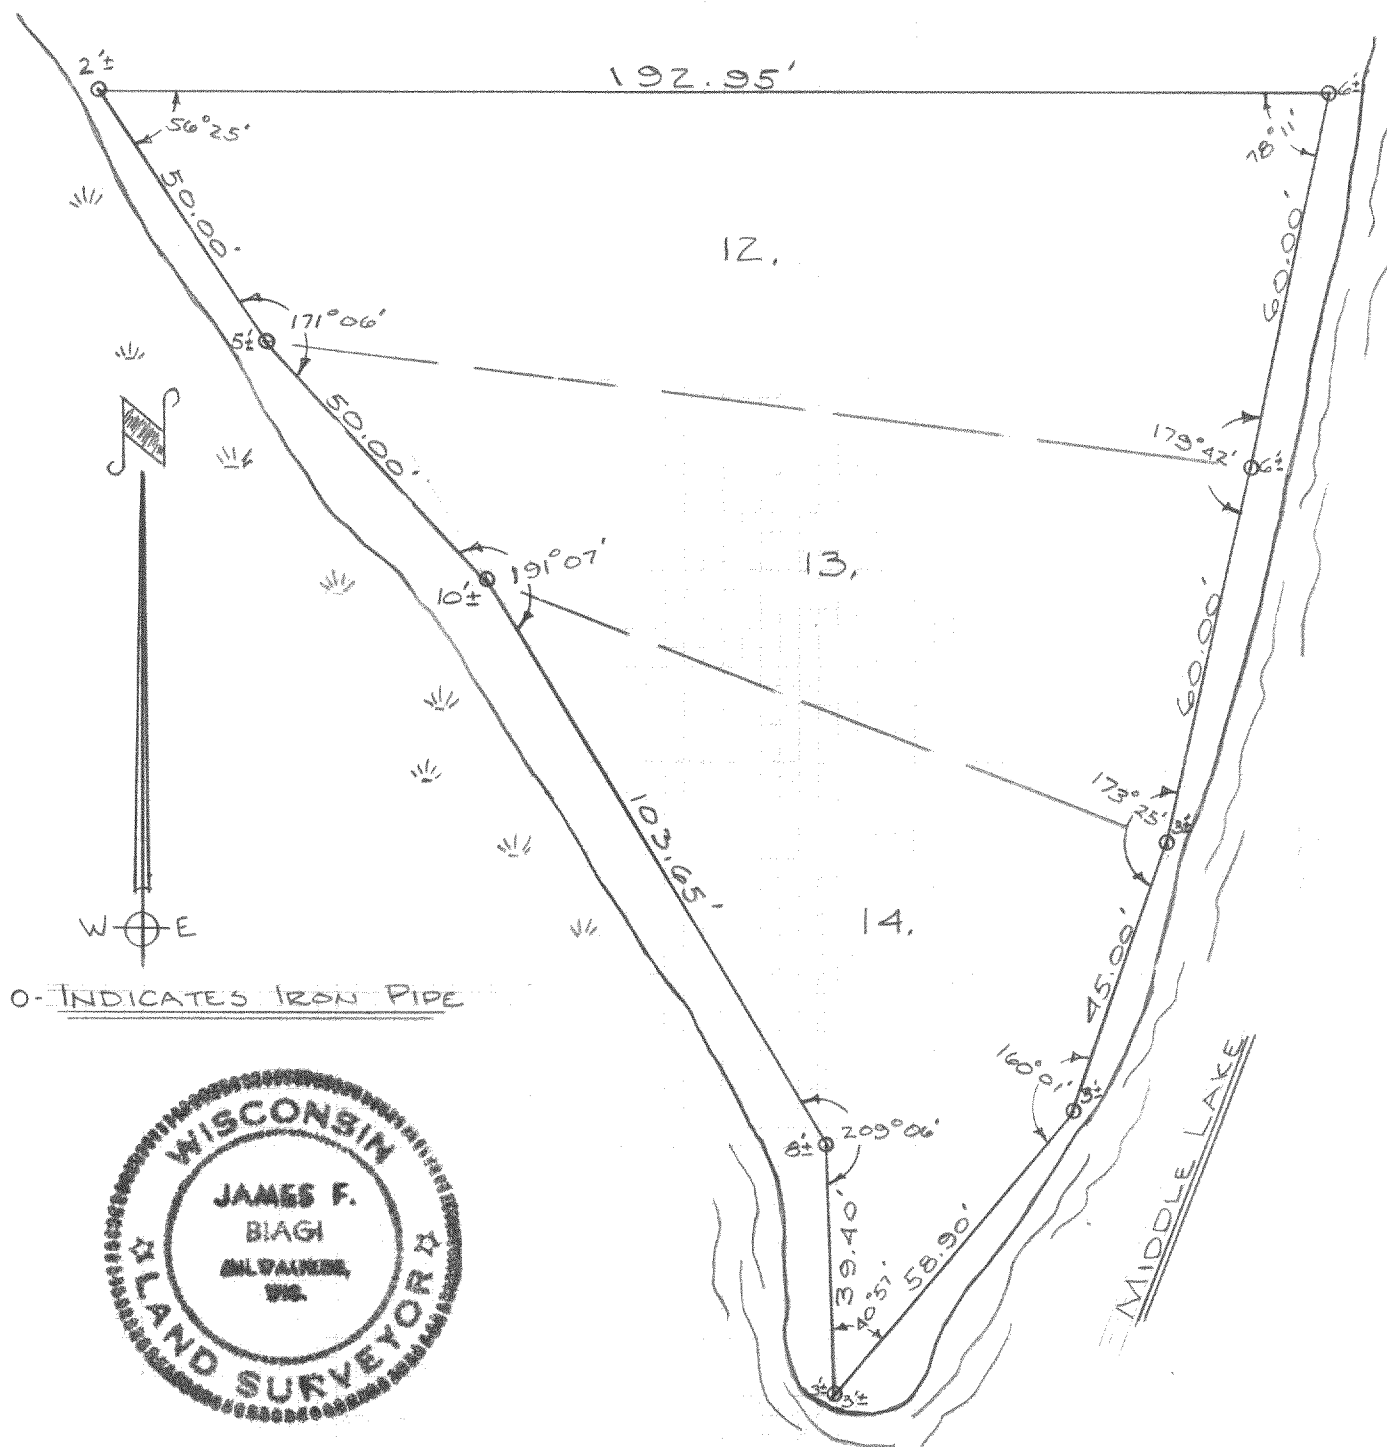

DESCRIPTION: Lots 12, 13, and 14 of Ingleside Point located in SE ¼ of Section 26, T. 4 N., R. 16 E., Town of LaGrange, Walworth County, Wisconsin.

CERTIFICATE: I, James F. Biagi, surveyor, do hereby certify that I have surveyed the property hereon described.

October 12, 1969

James F. Biagi, RLS 272

#IP-3

416-143 B