


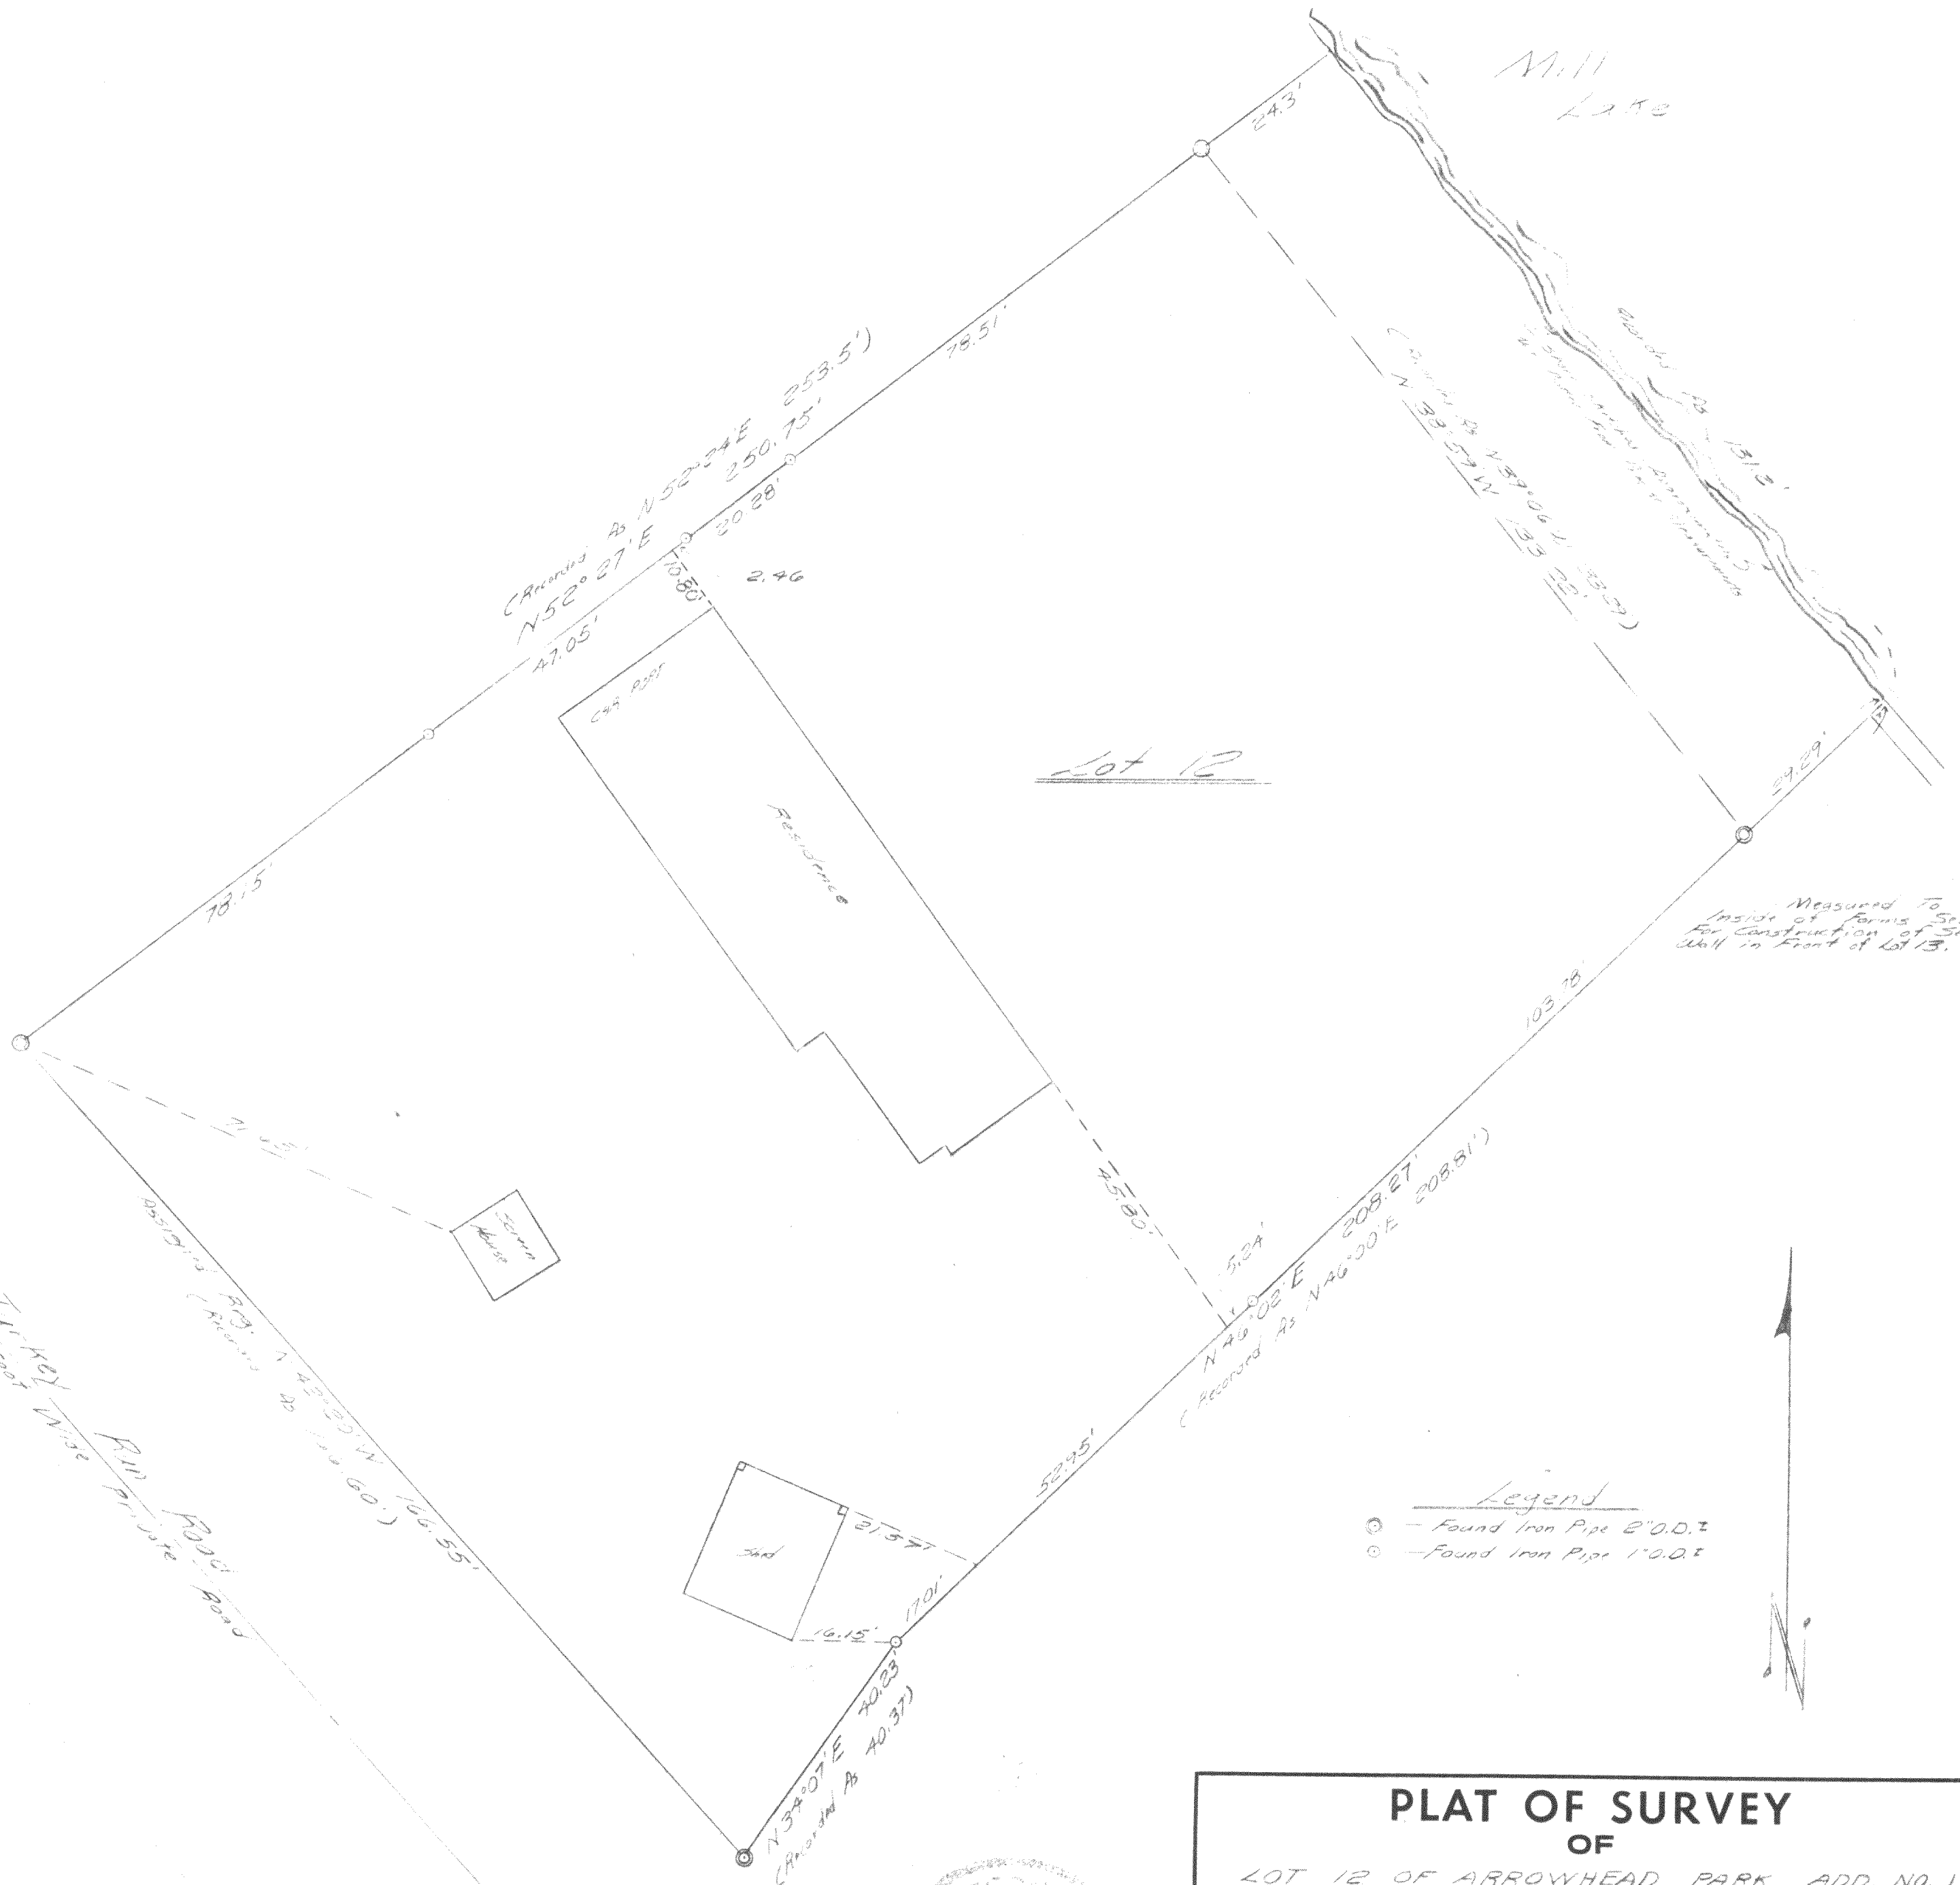


PLAT OF SURVEY OF

LOT 12 OF ARROWHEAD PARK ADD. NO. 1
LOCATED IN THE SOUTHEAST 1/4 OF SECTION
35, TOWNSHIP 4 NORTH, RANGE 16 EAST,
WALWORTH COUNTY, WISCONSIN

Lloyd J. Zeman
SURVEYOR

SCALE 1" = 20'

DATE 12 JULY 1973

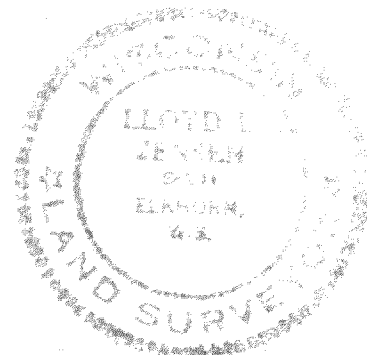

HA PA - 2