


PLAT OF SURVEY

LOT 68 OF THE FIRST ADDITION TO BUBBLING
SPRINGS SUBDIVISION, LOCATED IN SECTIONS
34 AND 35, TOWN 4 NORTH, RANGE 16 EAST,
TOWN OF LAGRANGE, WALWORTH COUNTY,
WISCONSIN.

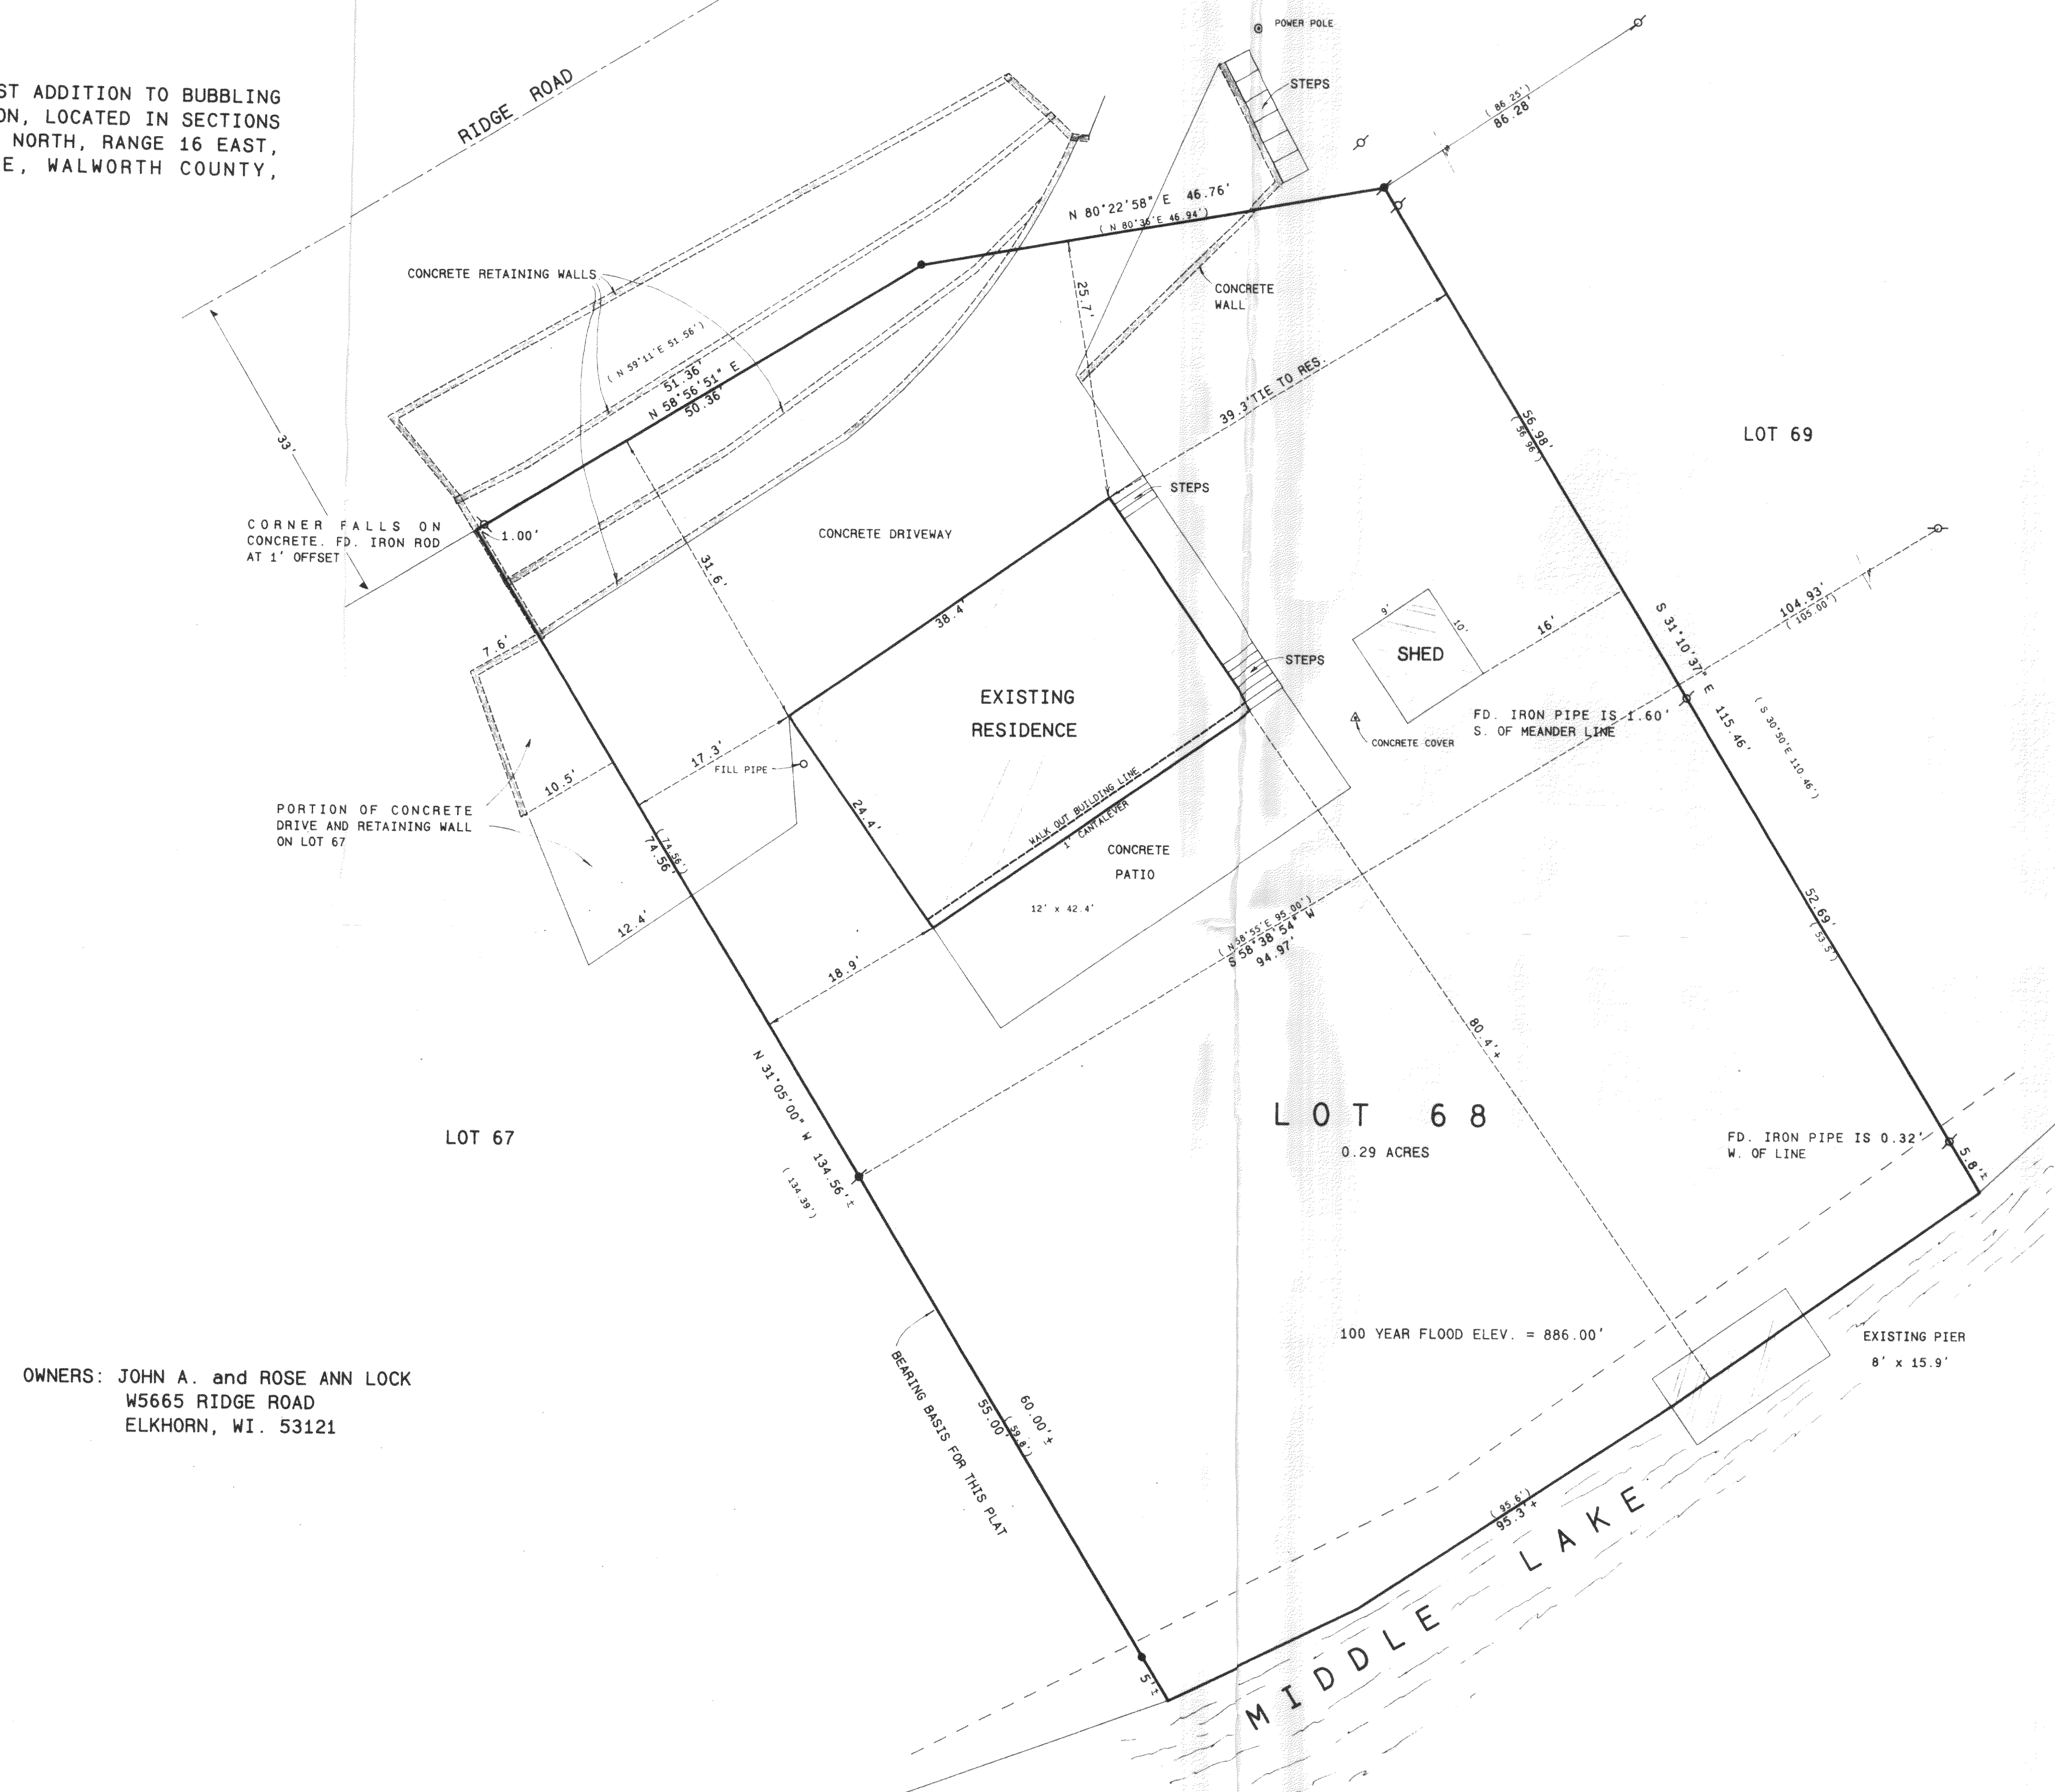

OWNERS: JOHN A. and ROSE ANN LOCK
W5665 RIDGE ROAD
ELKHORN, WI. 53121

SCALE 1" = 10 FEET

THE WEST LINE OF LOT 68
WAS ASSUMED TO BEAR
N 31°05'00" W AS PLATTED.

LOT 68
0.29 ACRES

100 YEAR FLOOD ELEV. = 886.00'


EXISTING PIER
8' x 15.9'

Legend

- FOUND IRON PIPE
 - FOUND IRON ROD
 - FOUND BRASS CAPPED MONUMENT
 - * FOUND CONCRETE MONUMENT
 - + CHISEL CUT IN CONCRETE
 - SET IRON ROD. 24" LONG, WEIGHING 1.5 LBS./LINEAL FT., 3/8" DIA.
 - SET IRON ROD. 30" LONG, WEIGHING 4.5 LBS./LINEAL FT., 1-11/16" DIA.
- (xx)
— x —
RECORDED AS DIMENSION
EXISTING FENCE



SCALE: 1" = 10 FEET

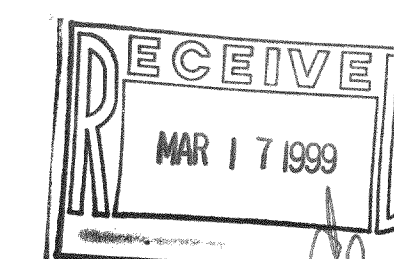

"I hereby certify that the above described property has been surveyed by me or under my direction and that the above map is a true representation thereof and shows the size and location of the property, its exterior boundaries, the location of all visible structures, and dimensions of all principal buildings thereon, boundary fences, apparent easements, roadways and visible encroachments, if any."

Kenneth B. Abernathy, Jr.
KENNETH B. ABERNATHY, JR.
WISCONSIN REGISTERED LAND SURVEYOR
S-1594
Date: DEC. 18, 1998 Job No. 98-1203

HBS1-37

416-1440