


# 201-65

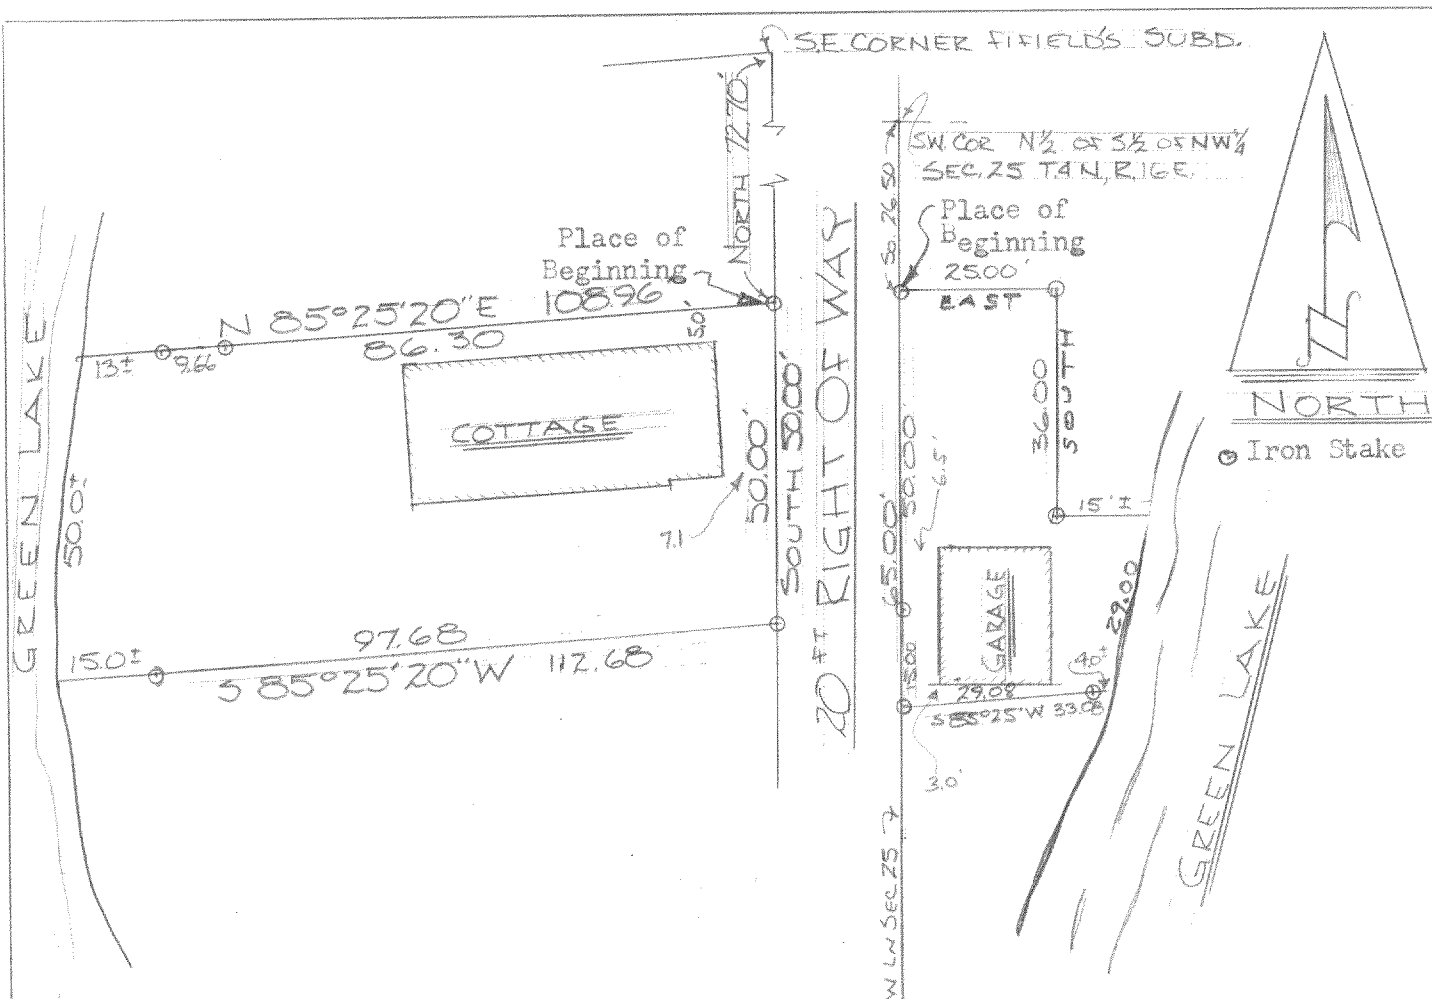

DESCRIPTION: Commencing at a point that is 72.70 feet South of the SE corner of Lot 7 of Fifields Subdivision in the NE  $\frac{1}{4}$  of Sec. 26, T. 4 N., R. 16 E. Walworth County Wisconsin; thence South 50.00 feet, thence S. 85° 25' 20" W. 112.68 feet to the shore line of Green Lake, thence N'ly along said shore line 50 ft. more or less to a point, said point being S 85° 25' 20" W 108.96 ft. from the place of beginning, thence N. 85° 25' 20" E. 108.96 feet to the place of beginning. Also Commencing at a point that is 26.50 feet south of the SW corner of the N $\frac{1}{2}$  of the S $\frac{1}{2}$  of the NW $\frac{1}{4}$  of Sec. 25 of said Township, thence East 25.00 feet, thence South 36.00 feet, thence East 15 ft more or less to the shore line of Green Lake, thence S'ly along said shore line 29 ft. more or less to a point, thence S. 85° 25' W 33.08 feet, thence North 65.00 feet to the place of beginning.

CERTIFICATE: I, James F. Biagi, surveyor, do hereby certify that I have surveyed the property hereon described.

AUGUST 1, 1965.

James F. Biagi, RLS 272

HH P-8

and

LG-25-28D

416-147B