


PLAT OF SURVEY

LOT 4 OF GLADHURST SUBDIVISION, LOCATED IN THE SOUTHEAST 1/4 OF SECTION 23, THE SOUTHWEST 1/4 OF SECTION 24, THE NORTHWEST 1/4 OF SECTION 25, AND THE NORTHEAST 1/4 OF SECTION 26, TOWN 4 NORTH, RANGE 16 EAST, TOWN OF LAGRANGE, WALWORTH COUNTY, WISCONSIN.


SURVEYED FOR: BIELINSKI BROS. BUILDERS/ EDWARD AND KATHY STARCK

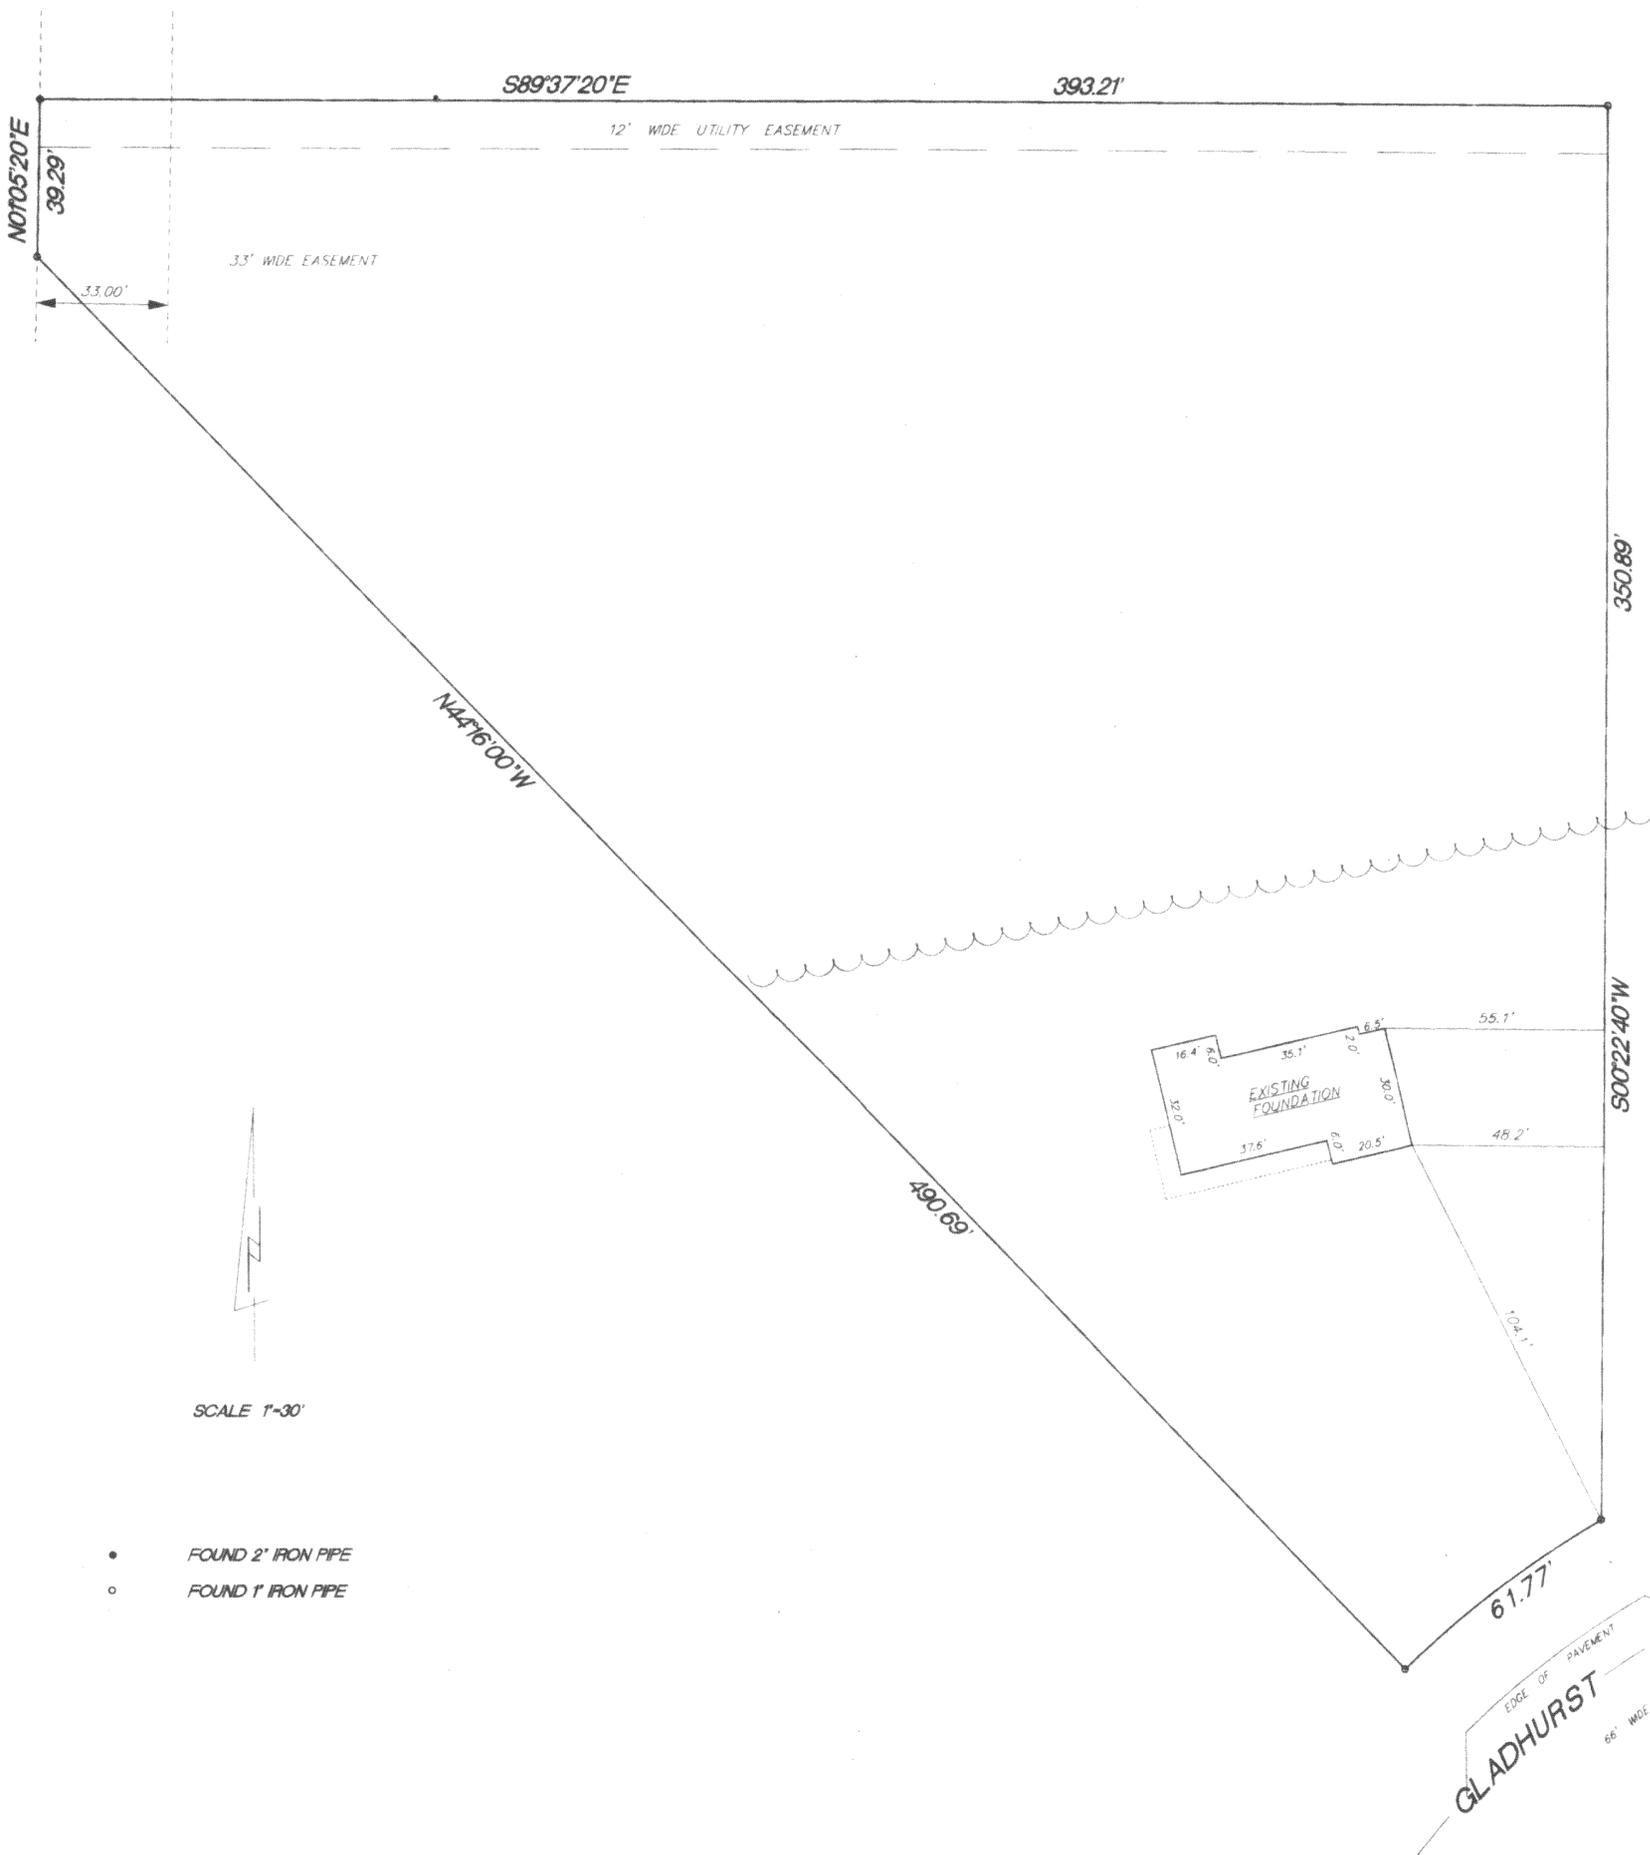

SCALE 1"=30'

- FOUND 2" IRON PIPE
- FOUND 1" IRON PIPE

RADIUS	LENGTH	CHORD	BEARING	DELTA
247.45'	61.77'	61.61'	S52°53'06"W	14°18'09"

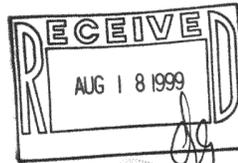

I hereby certify that I have surveyed the above property and that the above map is a true representation thereof and shows the size and location of the property exterior boundaries, the location of all visible structures and dimensions of all principal buildings thereon, boundary fences, apparent easements, roadways and encroachments if any.

This survey is made for the use of the present owners of the property, and also those who purchase, mortgage or guarantee the title thereto within one year from date hereof.

REV. 7/20/99  
REV. 6/10/99  
4/14/99

DATE \_\_\_\_\_ TEP/DW \_\_\_\_\_ FIELD WORK BY \_\_\_\_\_ TEP \_\_\_\_\_ DRAWN BY \_\_\_\_\_ 99067 \_\_\_\_\_ JOB NUMBER \_\_\_\_\_

Kettle Moraine Surveying  
W356 S9050 GODFREY LANE  
P.O. BOX 357  
Eagle WI. 53119  
(414)594-3484

TERENCE E. FISARSKA  
S-1830  
EAGLE, WISCONSIN  
LAND SURVEYOR

THIS IS NOT AN ORIGINAL SURVEY UNLESS THE SEAL IS RED.

HG-4 416-1483