



REDUCED
(FAX)

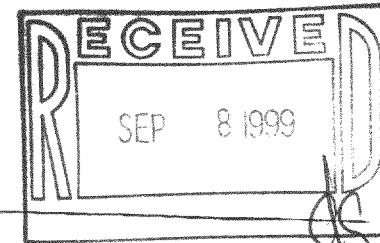

WALWORTH COUNTY
SURVEYING & MAPPING
P. O. BOX 1115
LAKE GENEVA, WISCONSIN 53147
414-248-0505

ARROWHEAD LANE

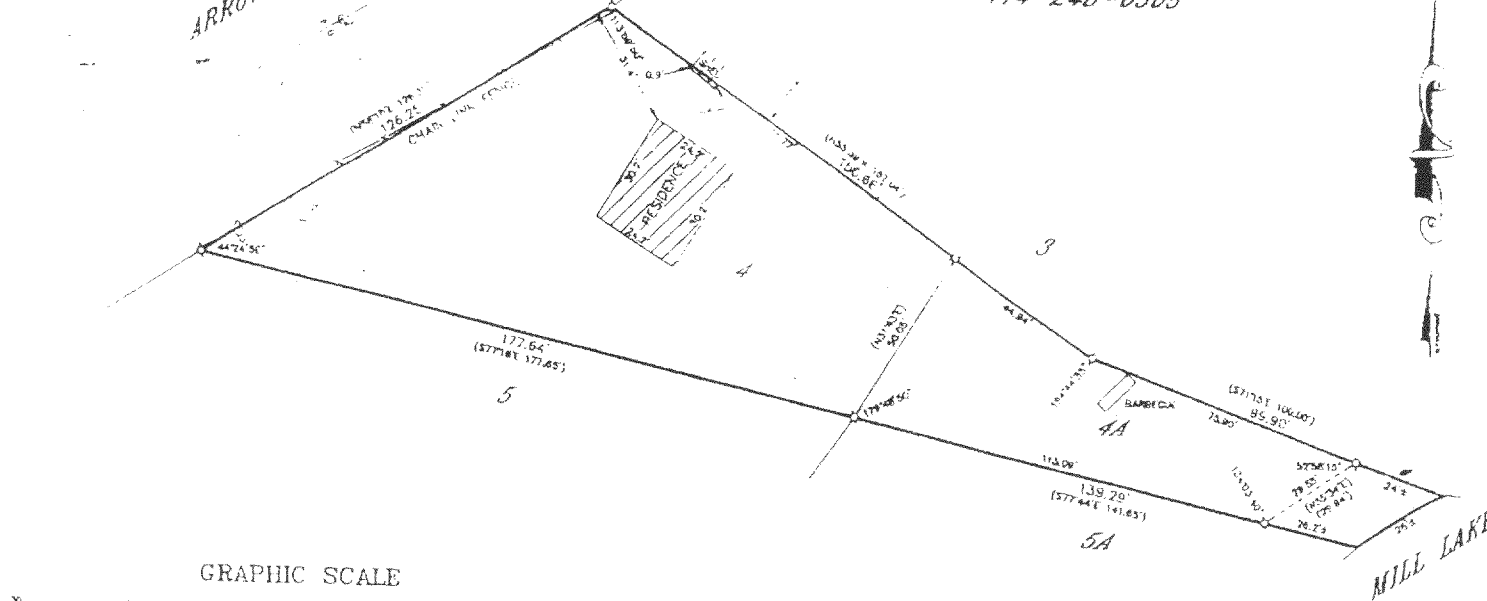

GRAPHIC SCALE



(IN FEET)
1 inch = 30 ft

- IRON PIPE FOUND
- IRON ROD FOUND
- CONCRETE MONUMENT FOUND
- IRON PIPE PLACED
- ()-RECORDED AS
- ⊖-UTILITY POLE

PLAT OF SURVEY OF

LOTS 4 AND 4A OF ARROWHEAD PARK, A SUBDIVISION
LOCATED IN GOVERNMENT LOT J IN THE SOUTHEAST 1/4
OF SECTION 35, T 4 N, R 16 E, WALWORTH COUNTY,
WISCONSIN.

ORDERED BY: CENTURY 21 ZENK REALTY
804 NORTH WISCONSIN
ELKHORN, WISCONSIN
53121

I HEREBY CERTIFY THAT I HAVE SURVEYED THE ABOVE DESCRIBED
PROPERTY AND THAT THE ABOVE MAP IS A TRUE REPRESENTATION
THEREOF AND SHOWS THE SIZE AND LOCATION OF THE PROPERTY,
ITS EXTERIOR BOUNDARIES, THE LOCATION OF ALL MONUMENTS,
AND DIMENSIONS OF ALL PRINCIPAL BUILDINGS THEREON, BOUNDARY
LINES, APPARENT EASEMENTS, ROADWAYS AND OTHER ENCUMBRANCES,
IF ANY, TO THE BEST OF MY KNOWLEDGE AND BELIEF.

THIS SURVEY IS MADE FOR THE USE OF THE PRESENT OWNERS OF
THE PROPERTY AND ALSO THOSE WHO PURCHASE PORTIONS OF
QUANTITIES OF THE TITLE THEREIN WITHIN ONE (1) YEAR FROM DATE
HEREOF.

[Signature]
ROBERT A. BAUDENHARD
WISCONSIN REGISTERED LAND SURVEYOR 5-1508

DATE: Feb. 2, 1999
JOB NO. 5077

NOTE: THIS IS NOT A CERTIFIED COPY UNLESS SEALED

HAP-3

416-1485